


RECORD OF SURVEY / MONUMENT TIE MAP

FOR

CASINO CENTER BOULEVARD

A PORTION OF THE NORTHWEST QUARTER (NW 1/4) OF
SECTION 3, TOWNSHIP 21 SOUTH, RANGE 61 EAST, M.D.M.

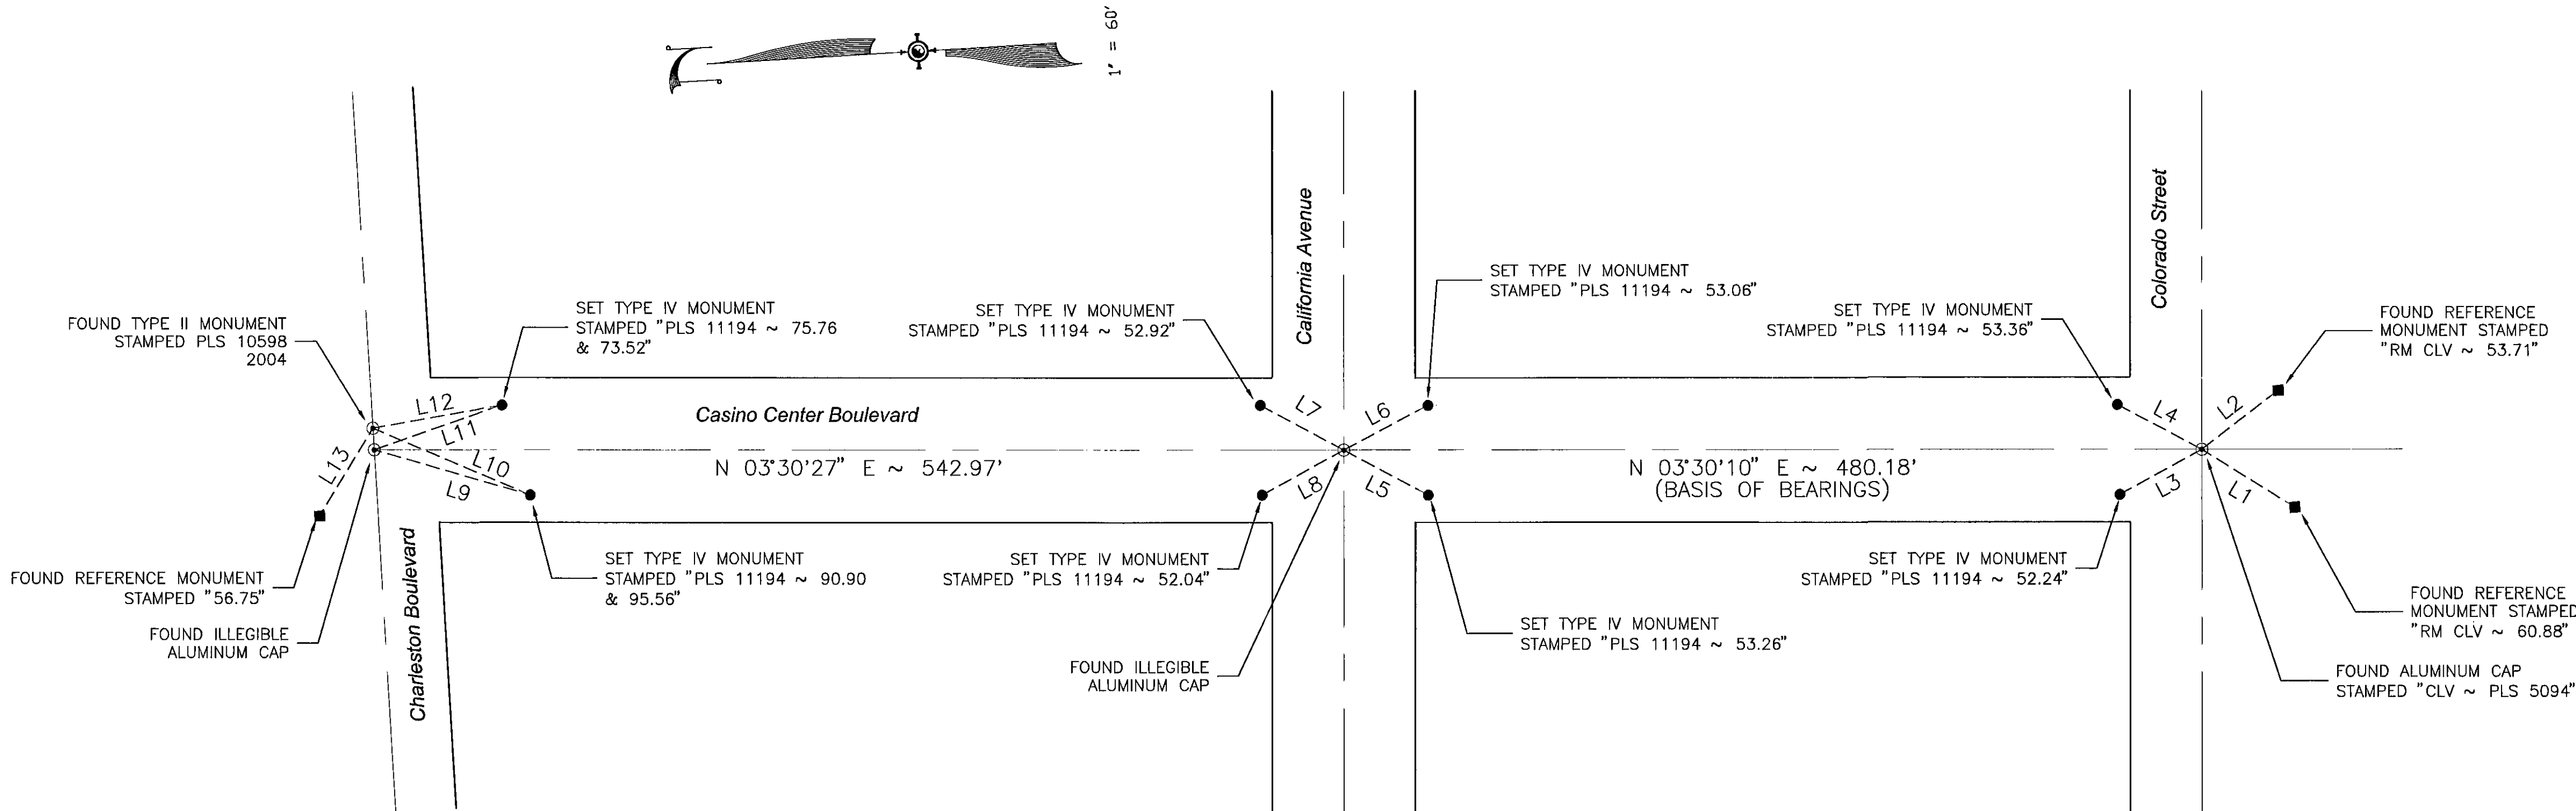

BASIS OF BEARINGS

1. NORTH 03°30'10" EAST, BEING THE CENTERLINE OF CASINO CENTER BOULEVARD BETWEEN COLORADO STREET AND CALIFORNIA STREET AS SHOWN ON THE RECORD OF SURVEY RECORDED IN FILE 82 OF SURVEYS, PAGE 84, CLARK COUNTY, NEVADA.


REFERENCES

1. Record of Survey for City of Las Vegas, filed in the Office of the Clark County Recorder on June 11, 1996 in File 82 of Surveys, Page 84, Official Records.

SURVEYOR'S CERTIFICATE

- I, ERIC V. SNYDER, A PROFESSIONAL LAND SURVEYOR LICENSED IN THE STATE OF NEVADA, CERTIFY THAT:
- THIS MAP REPRESENTS THE RESULTS OF A SURVEY CONDUCTED UNDER MY DIRECT SUPERVISION AT THE INSTANCE OF CAPRIATI CONSTRUCTION CORPORATION.
 - THE LANDS SURVEYED LIE WITHIN SECTION 3, TOWNSHIP 21 SOUTH, RANGE 61 EAST, M.D.M., LAS VEGAS, NEVADA AND THE SURVEY WAS COMPLETED ON THE DECEMBER 3, 2008.
 - THIS RECORD OF SURVEY COMPLIES WITH THE APPLICABLE STATE STATUTES AND ANY LOCAL ORDINANCES IN EFFECT.
 - THE MONUMENTS DEPICTED ON THIS RECORD OF SURVEY ARE OF THE CHARACTER SHOWN, AND OCCUPY THE POSITIONS INDICATED AND ARE OF SUFFICIENT NUMBER AND DURABILITY.

ERIC V. SNYDER
PROFESSIONAL LAND SURVEYOR
NEVADA CERTIFICATE NO. 11194

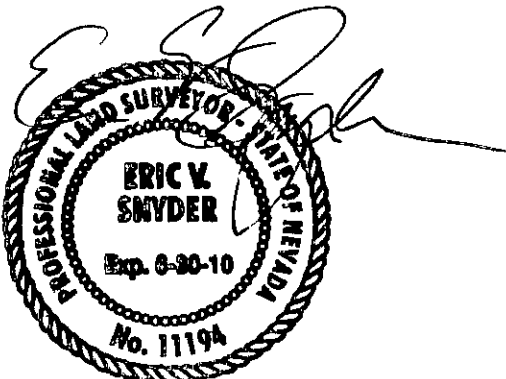

12/4/08

LINE TABLE

LINE	BEARING	DISTANCE
L1	N 35°04'53" E	60.88
L2	N 33°50'41" W	53.71
L3	N 24°53'18" W	52.24
L4	N 31°12'00" E	53.36
L5	N 31°17'19" E	53.26
L6	N 24°10'10" W	53.06
L7	N 31°26'12" E	52.92
L8	N 24°53'07" W	52.04
L9	N 19°23'36" E	90.90
L10	N 26°07'21" E	95.56
L11	N 15°33'57" W	75.76
L12	N 06°35'34" W	73.52
L13	S 54°45'51" E	56.75

LEGEND

— — — — —	CENTERLINE
— — — — —	RIGHT-OF WAY LINE
— — — — —	DIMENSION LINE
■	FOUND REFERENCE MONUMENT AS NOTED
⊙	FOUND MONUMENT AS NOTED
●	SET REFERENCE MONUMENT AS NOTED
---	LINE TABLE REFERENCE NUMBER

COUNTY RECORDER'S NOTE

ANY SUBSEQUENT CHANGES TO THIS MAP SHOULD BE EXAMINED AND MAY BE DETERMINED BY REFERENCE TO THE COUNTY RECORDER'S CUMULATIVE MAP INDEX. NRS 278.5695

16514	
RECORD OF SURVEY MONUMENT TIE MAP FOR CASINO CENTER BOULEVARD LOCATED WITHIN A PORTION OF THE NORTHWEST 1/4 OF SECTION 3, TOWNSHIP 21 SOUTH, RANGE 61 EAST, M.D.M. LAS VEGAS CLARK COUNTY NEVADA N:\DWG\SUJ\3330\SURVEY\7333010.DWG - 1:01 PM * 03-DEC-2008	
SUMMIT ENGINEERING CORPORATION 313 PILOT ROAD, SUITE A, LAS VEGAS, NV 89118 PHONE: (702) 252-3248 FAX: (702) 252-3247	SHEET 1 OF 1
INSTRUMENT NO. _____ FILED AT THE REQUEST OF SUMMIT ENGINEERING CORPORATION DATE _____ AT _____ FILE _____ PAGE _____ OF SURVEYS OFFICIAL RECORDS BOOK NO. _____ CLARK COUNTY, NEVADA RECORDS DEBBIE CONWAY CLARK COUNTY RECORDER FEE \$ _____ DEPUTY _____	