


SEE MATCH INTERSECTION ABOVE FOR SURVEY TIES.

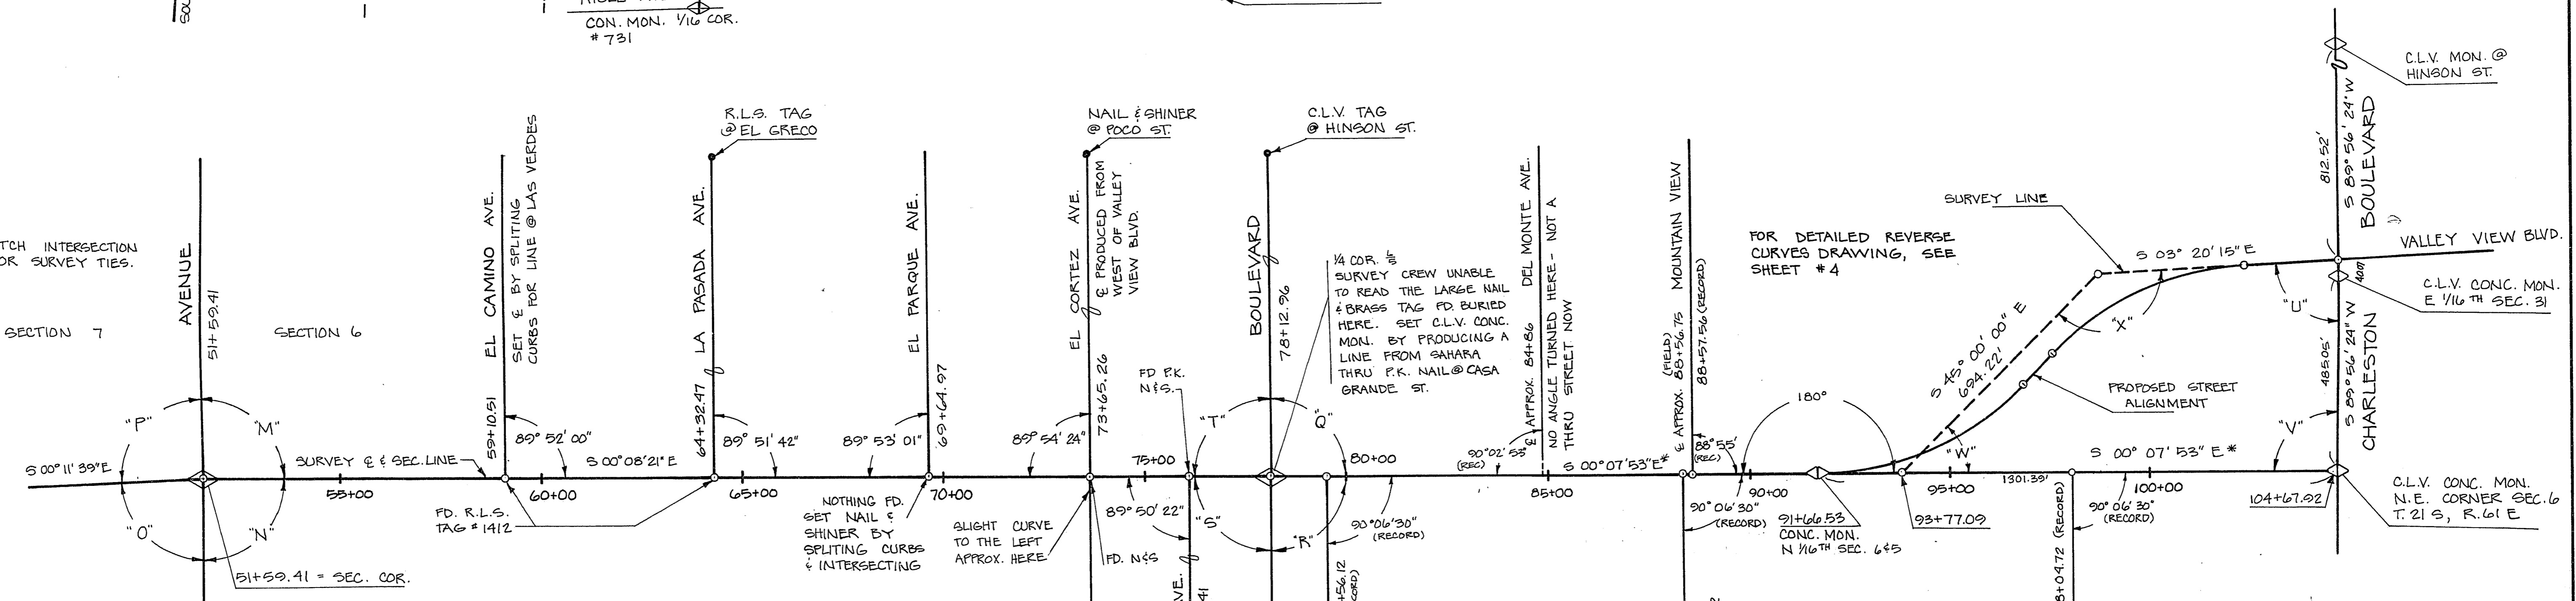

	MEASURED ANGLE	CORRECTED ANGLE
A	90° 11' 51"	90° 11' 48"
B	95° 25' 28"	95° 25' 25"
C	85° 54' 17"	85° 54' 15"
D	88° 28' 35"	88° 28' 32"
E	89° 20' 00"	89° 20' 02"
F	94° 13' 27"	94° 13' 30"
G	85° 46' 39"	85° 46' 41"
H	90° 39' 44"	90° 39' 47"
I	88° 29' 31"	88° 29' 29"
J	92° 56' 34"	92° 56' 31"
K	87° 03' 10"	87° 03' 08"
L	91° 30' 54"	91° 30' 52"
M	89° 51' 15"	89° 51' 12"
N	90° 13' 55"	90° 13' 52"
O	87° 37' 13"	87° 37' 13"
P	92° 17' 43"	92° 17' 46"
Q	90° 06' 40"	90° 06' 41"
R	90° 08' 49"	90° 08' 50"
S	89° 50' 42"	89° 50' 42"
T	89° 53' 46"	89° 53' 47"
U	86° 33' 08"	86° 33' 11"
V	90° 04' 14"	90° 04' 17"
W	44° 52' 07"	44° 52' 07"
X	138° 30' 21"	138° 30' 23"

APPROVED	
DATE	DATE
RT. DIV.	
✓ [Signature]	
✓ [Signature]	
DATE 23 NOV 71	

* BASIS OF BEARINGS - S 00° 07' 53" E EAST LINE OF SECTION 6, T. 21 S, R. 61 E PER WESTLEIGH TRACT 1 BOOK 3 OF PLATS PAGE 11 CLARK COUNTY NEVADA RECORDS

C. P. BRECHLER
C. H. BRECHLER, MANAGING ENGINEER R.S.H. DATE 11-29-71

CITY OF LAS VEGAS NEVADA
DEPARTMENT OF PUBLIC WORKS
SERVICES DIVISION

VALLEY VIEW BLVD. ALIGNMENT MAP
DESERT INN TO CHARLESTON

W.O. NO. 7677	E.BK. NO. 62, 2X, 64-	DATE	DRAWING NO.
SC. (H) 1"=200'	SC. (V) NONE	11-3-71	107V-604C
DES. E. LOUVIERE	DR. M. HALINAR		FILE NO.
APPROVED BY DIRECTOR OF PUBLIC WORKS			SHEET 3 OF 7

6-4-52