



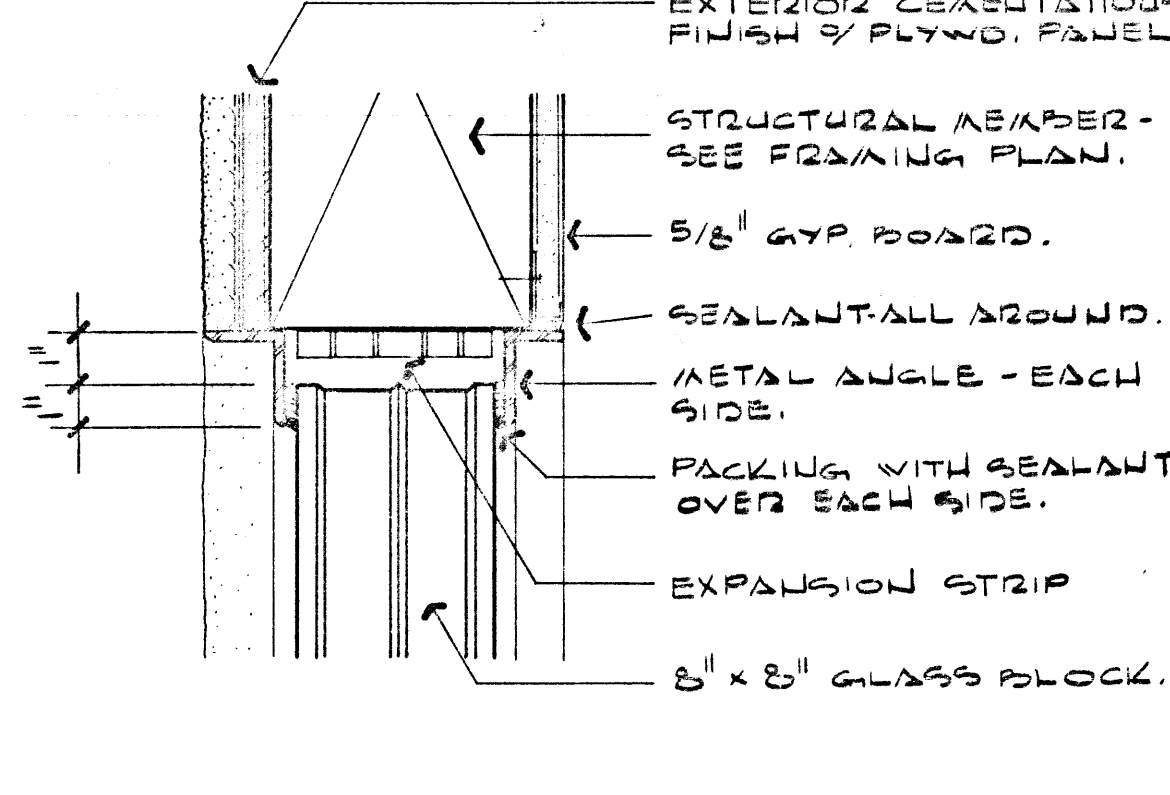

DETAIL head
3":1'-0"

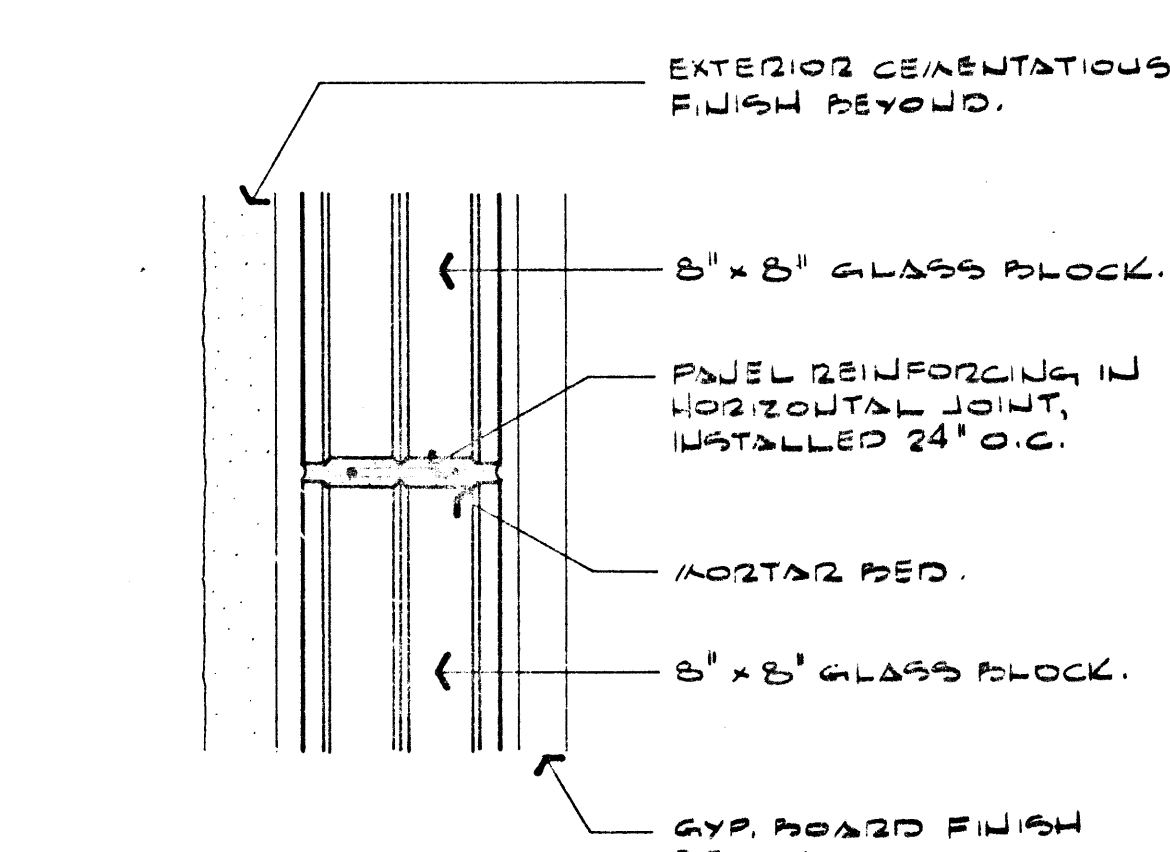


DETAIL horiz. joint

3" : 1'-0"


2

A 17

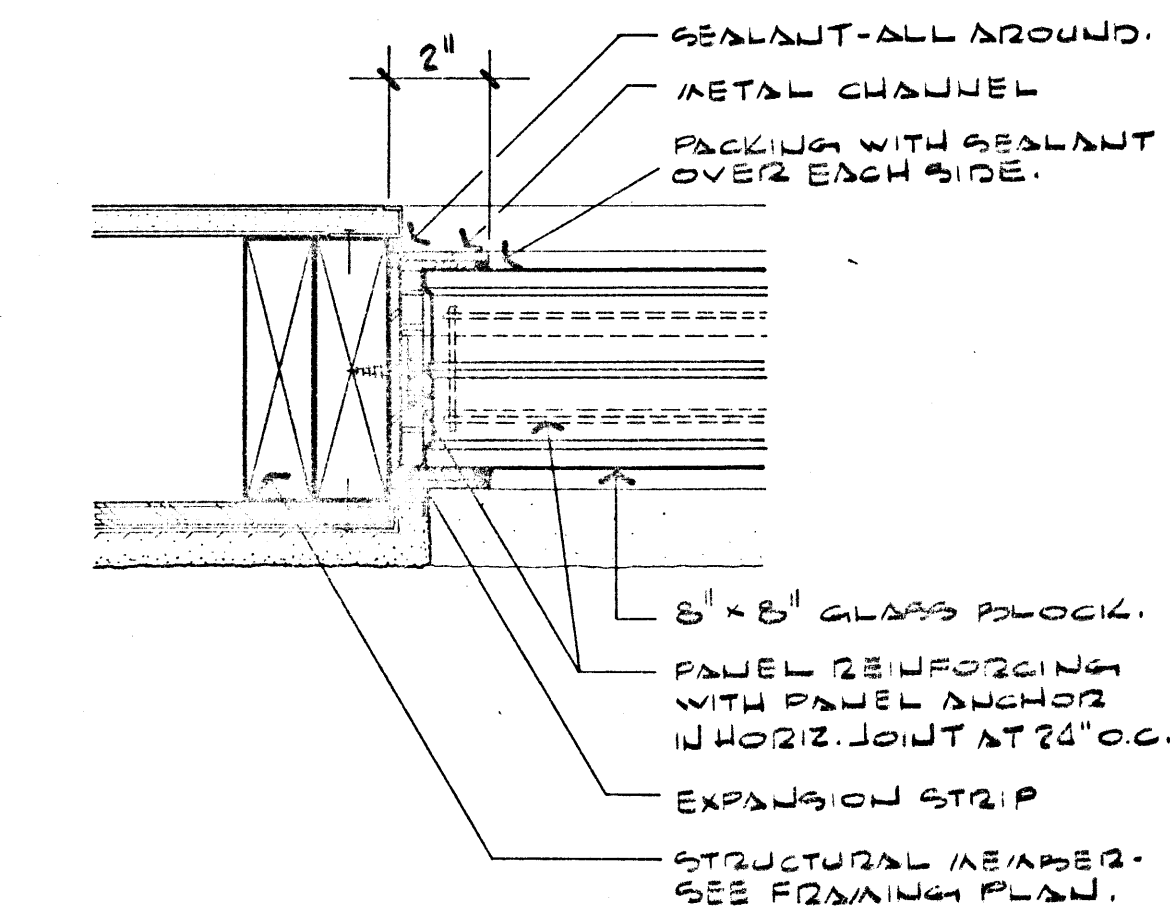

DETAIL jamb

3
A.17

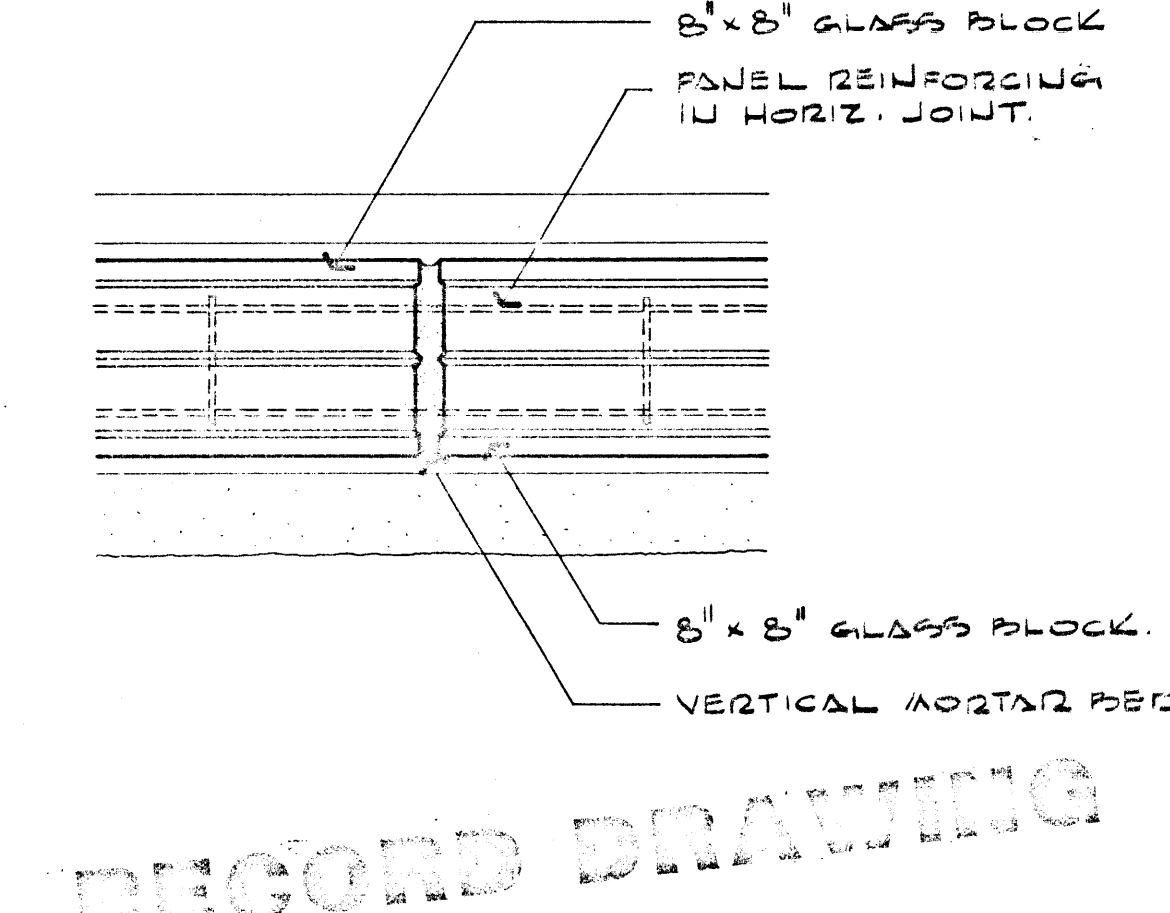


DETAIL Vert. joint

3" : 1' - 0"

4

A.17

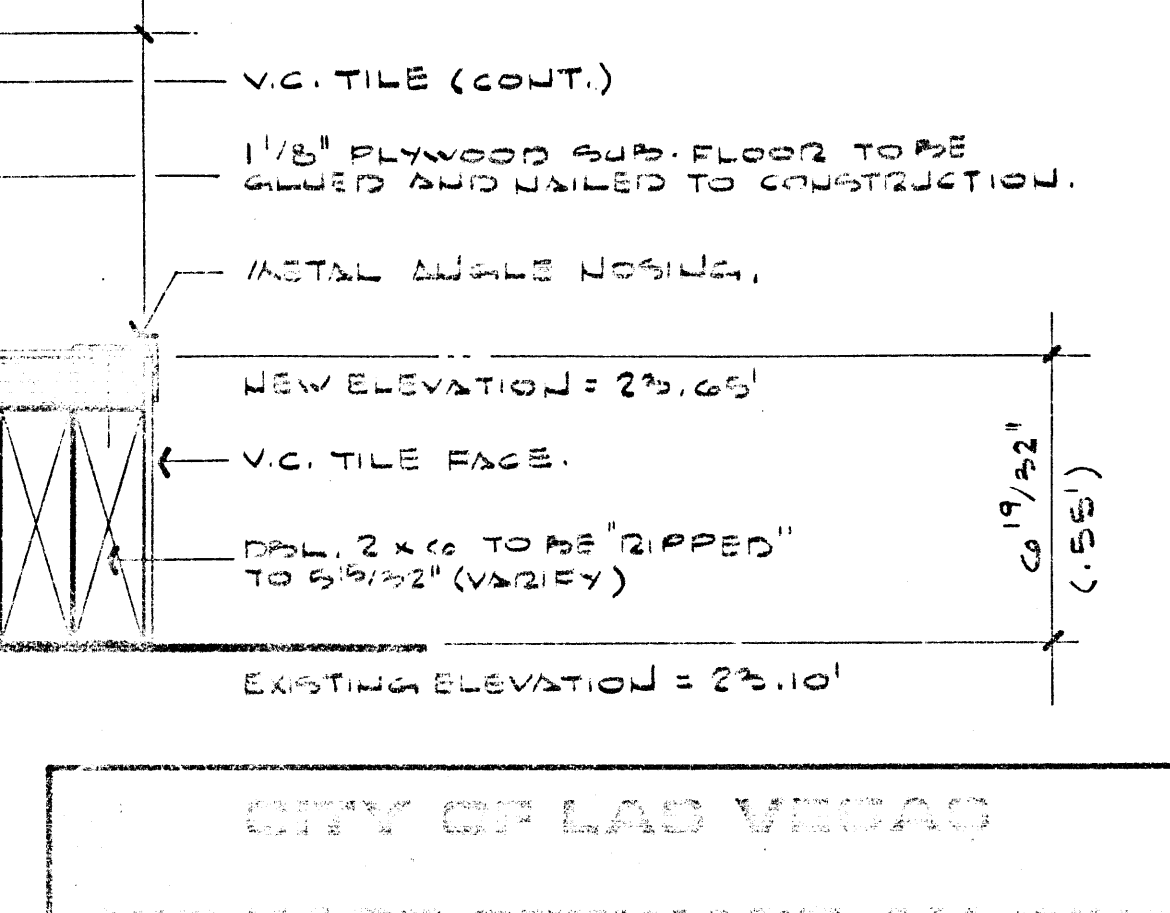

10-10-68


