



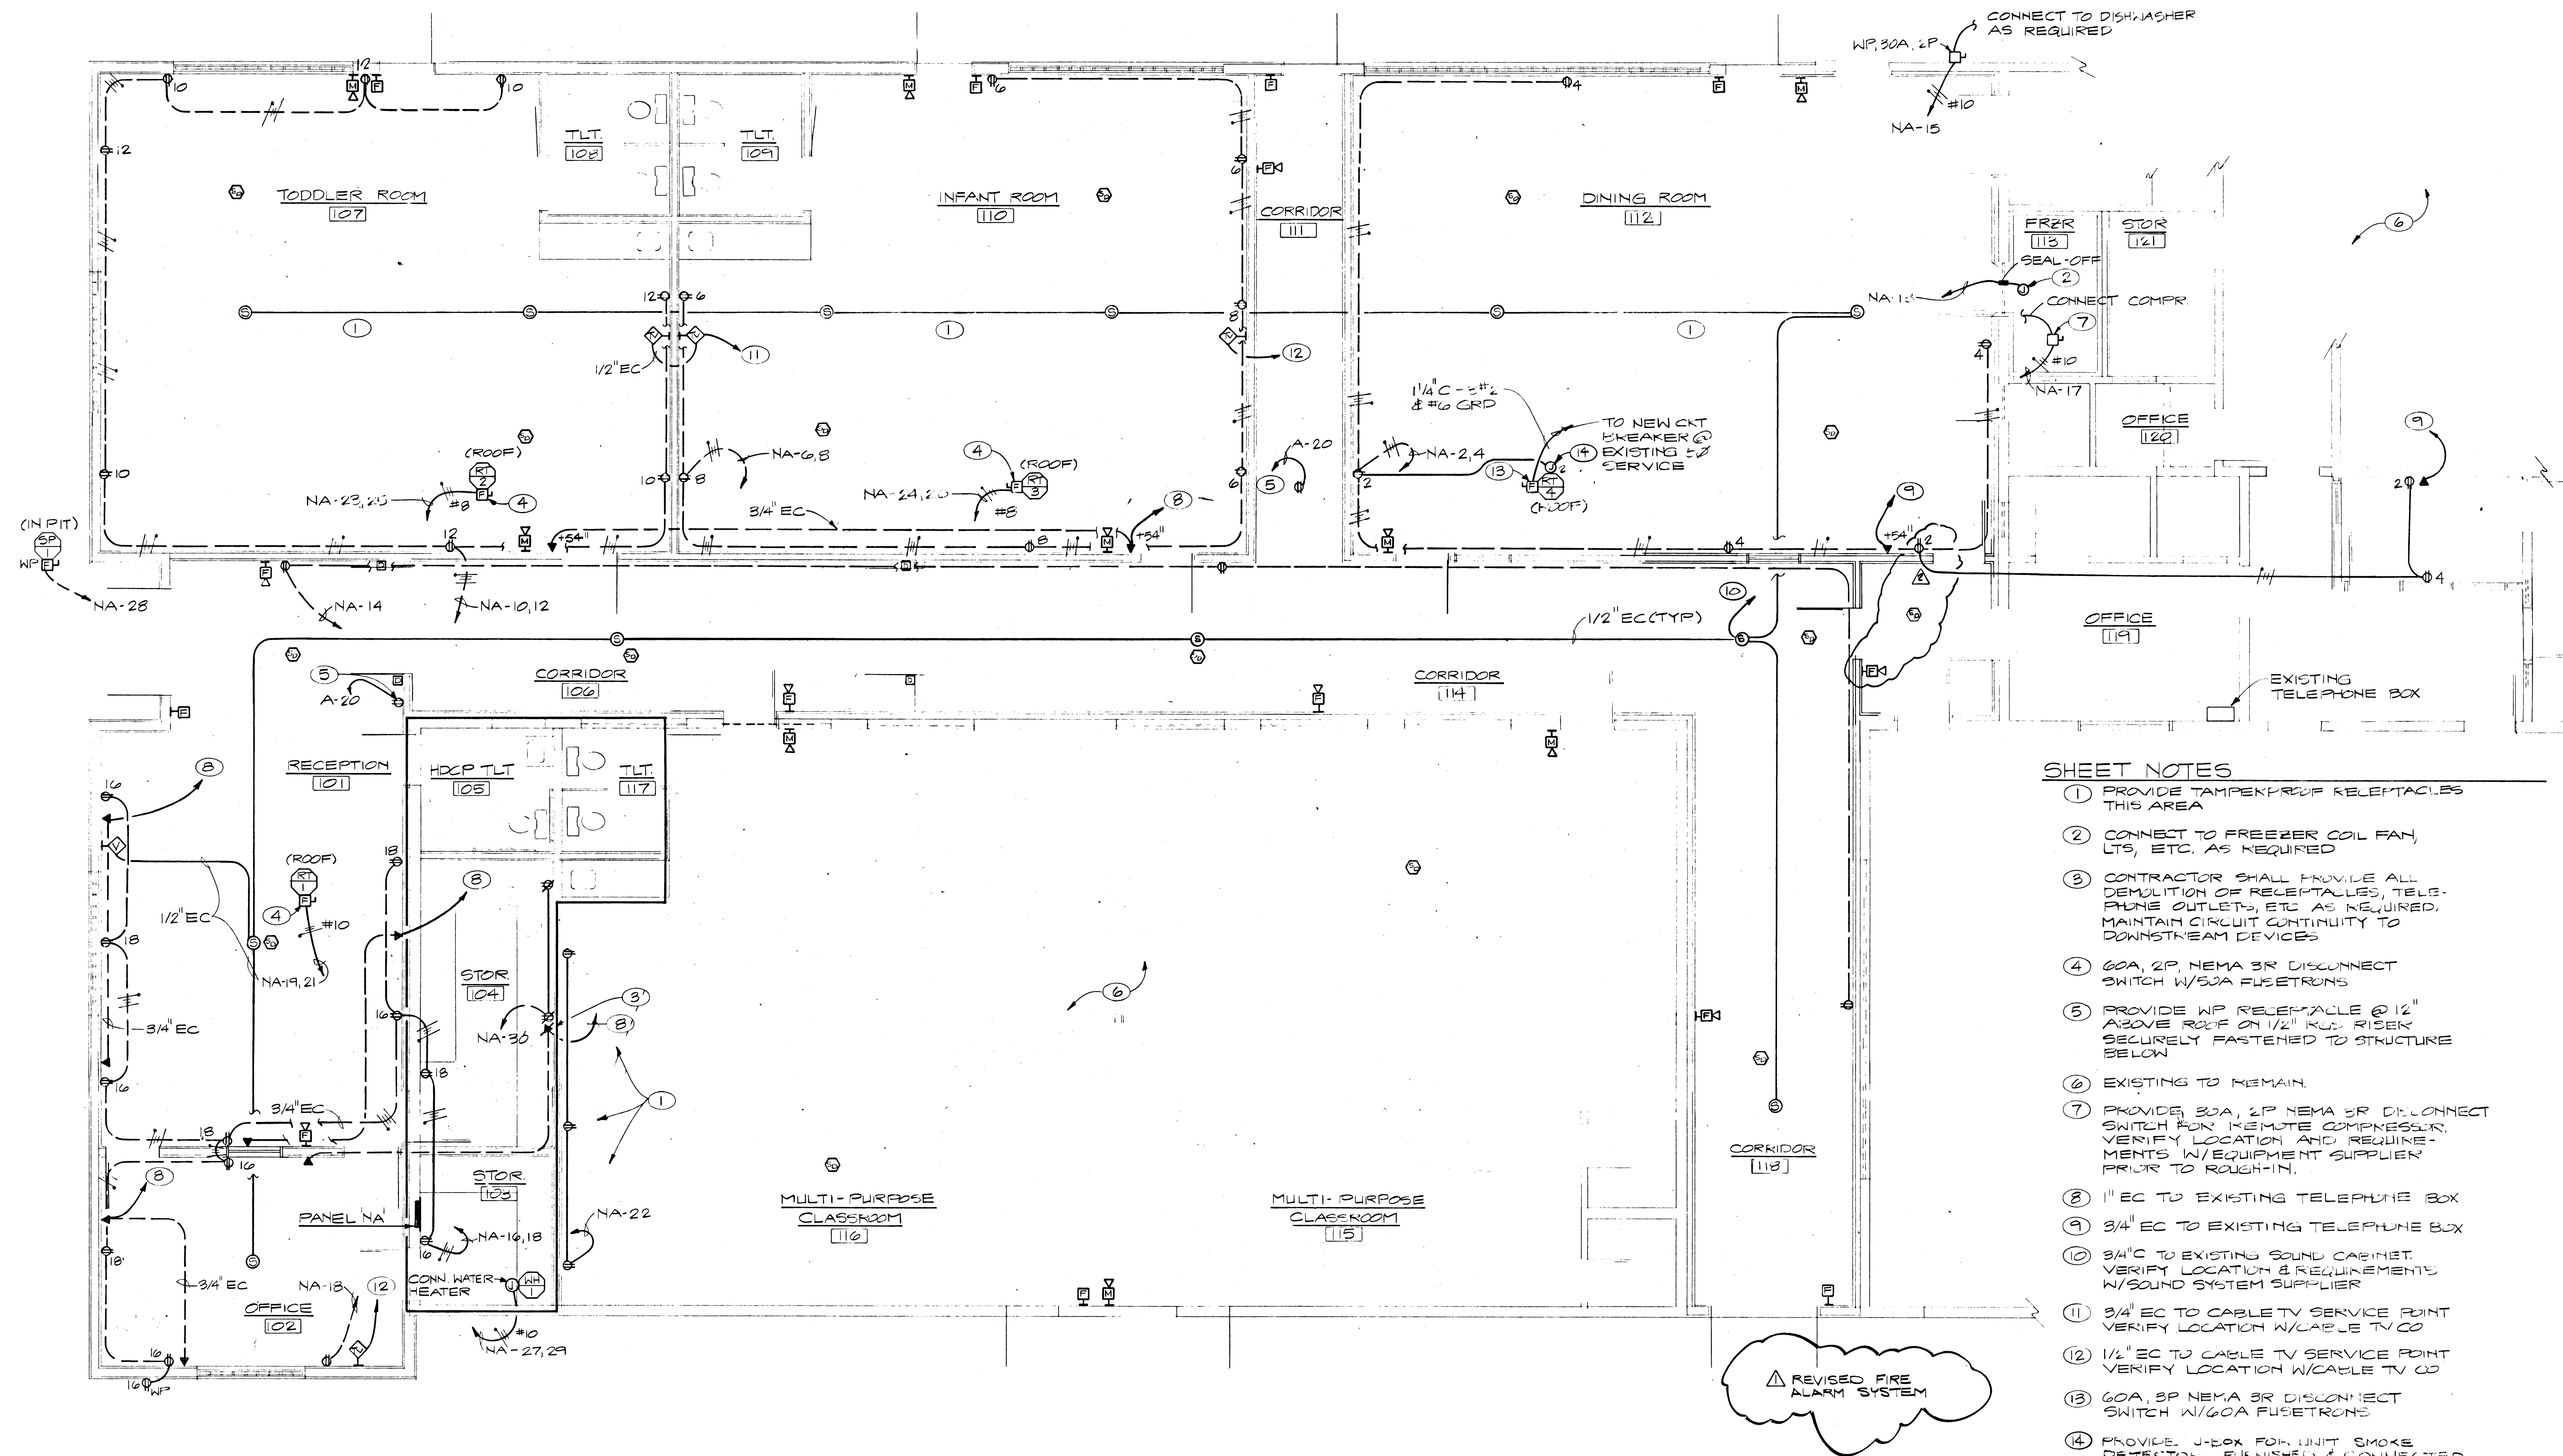

POWER & AUXILIARY PLAN

SCALE: 1/4" = 1'-0"

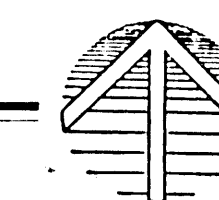

**HARRIS
ENGINEERS, INC.**
MECHANICAL/ELECTRICAL CONSULTANTS
2785 East Desert Inn Road, Suite 280
Las Vegas, Nevada 89121
702/798-0228

CITY OF LAS VEGAS
400 EAST STEWART AVENUE
LAS VEGAS, NEVADA 89101

SHEET NOTES

1. PROVIDE TAMPER-PROOF RECEPTACLES THIS AREA
2. CONNECT TO FREEZER COIL FAN, LVS, ETC. AS REQUIRED
3. CONTRACTOR SHALL PROVIDE ALL DEMOLITION OF RECEPTACLES, TELEPHONE OUTLETS, ETC. AS REQUIRED. MAINTAIN CIRCUIT CONTINUITY TO DOWNSTREAM DEVICES
4. 60A, 2P, NEMA 3R DISCONNECT SWITCH W/50A FUSETRONS
5. PROVIDE WP RECEPTACLE @ 12" ABOVE ROOF ON 1/2" K.C. RISER SECURELY FASTENED TO STRUCTURE BELOW
6. EXISTING TO REMAIN
7. PROVIDE 30A, 2P NEMA 3R DISCONNECT SWITCH FOR REMOTE COMPRESSOR. VERIFY LOCATION AND REQUIREMENTS W/EQUIPMENT SUPPLIER PRIOR TO ROUGH-IN.
8. 1" EC TO EXISTING TELEPHONE BOX
9. 3/4" EC TO EXISTING TELEPHONE BOX
10. 3/4" C TO EXISTING SOUND CABINET. VERIFY LOCATION & REQUIREMENTS W/SOUND SYSTEM SUPPLIER
11. 3/4" EC TO CABLE TV SERVICE POINT. VERIFY LOCATION W/CABLE TV CO
12. 1/2" EC TO CABLE TV SERVICE POINT. VERIFY LOCATION W/CABLE TV CO
13. 60A, 3P NEMA 3R DISCONNECT SWITCH W/60A FUSETRONS
14. PROVIDE J-BOX FOR UNIT SMOKE DETECTOR. FURNISHED & CONNECTED BY DLU IC.

POWER & AUXILIARY PLAN

drawn by: LFF
issue dates:
11/3/88
11/22/88 bidding
revisions:
2/1/89 2nd. bidding
6/7/89 3rd. bidding
6/15/89 GEN. REV.
job no.:

E.4

32

671-25


PHASE I (VARIETY CLUB)

"D" STREET / JEFFERSON AVENUE
NEIGHBORHOOD FACILITY PROJECT

**ARCHITECT • GERALD GARAPICH &
ASSOCIATES A.I.A.**

2330 FIFTH AVENUE, SUITE 201, SAN DIEGO, CA 92101 (619) 233-7296
2000 PASO DEL PRADO, C-108, LAS VEGAS, NV 89102 (702) 387-4445

27-179

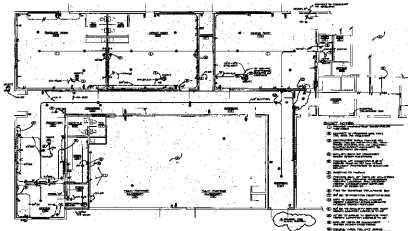

POWER & AUXILIARY PLAN

CITY OF LAS VEGAS
400 EAST STEWART AVENUE
LAS VEGAS, NEVADA 89101





