

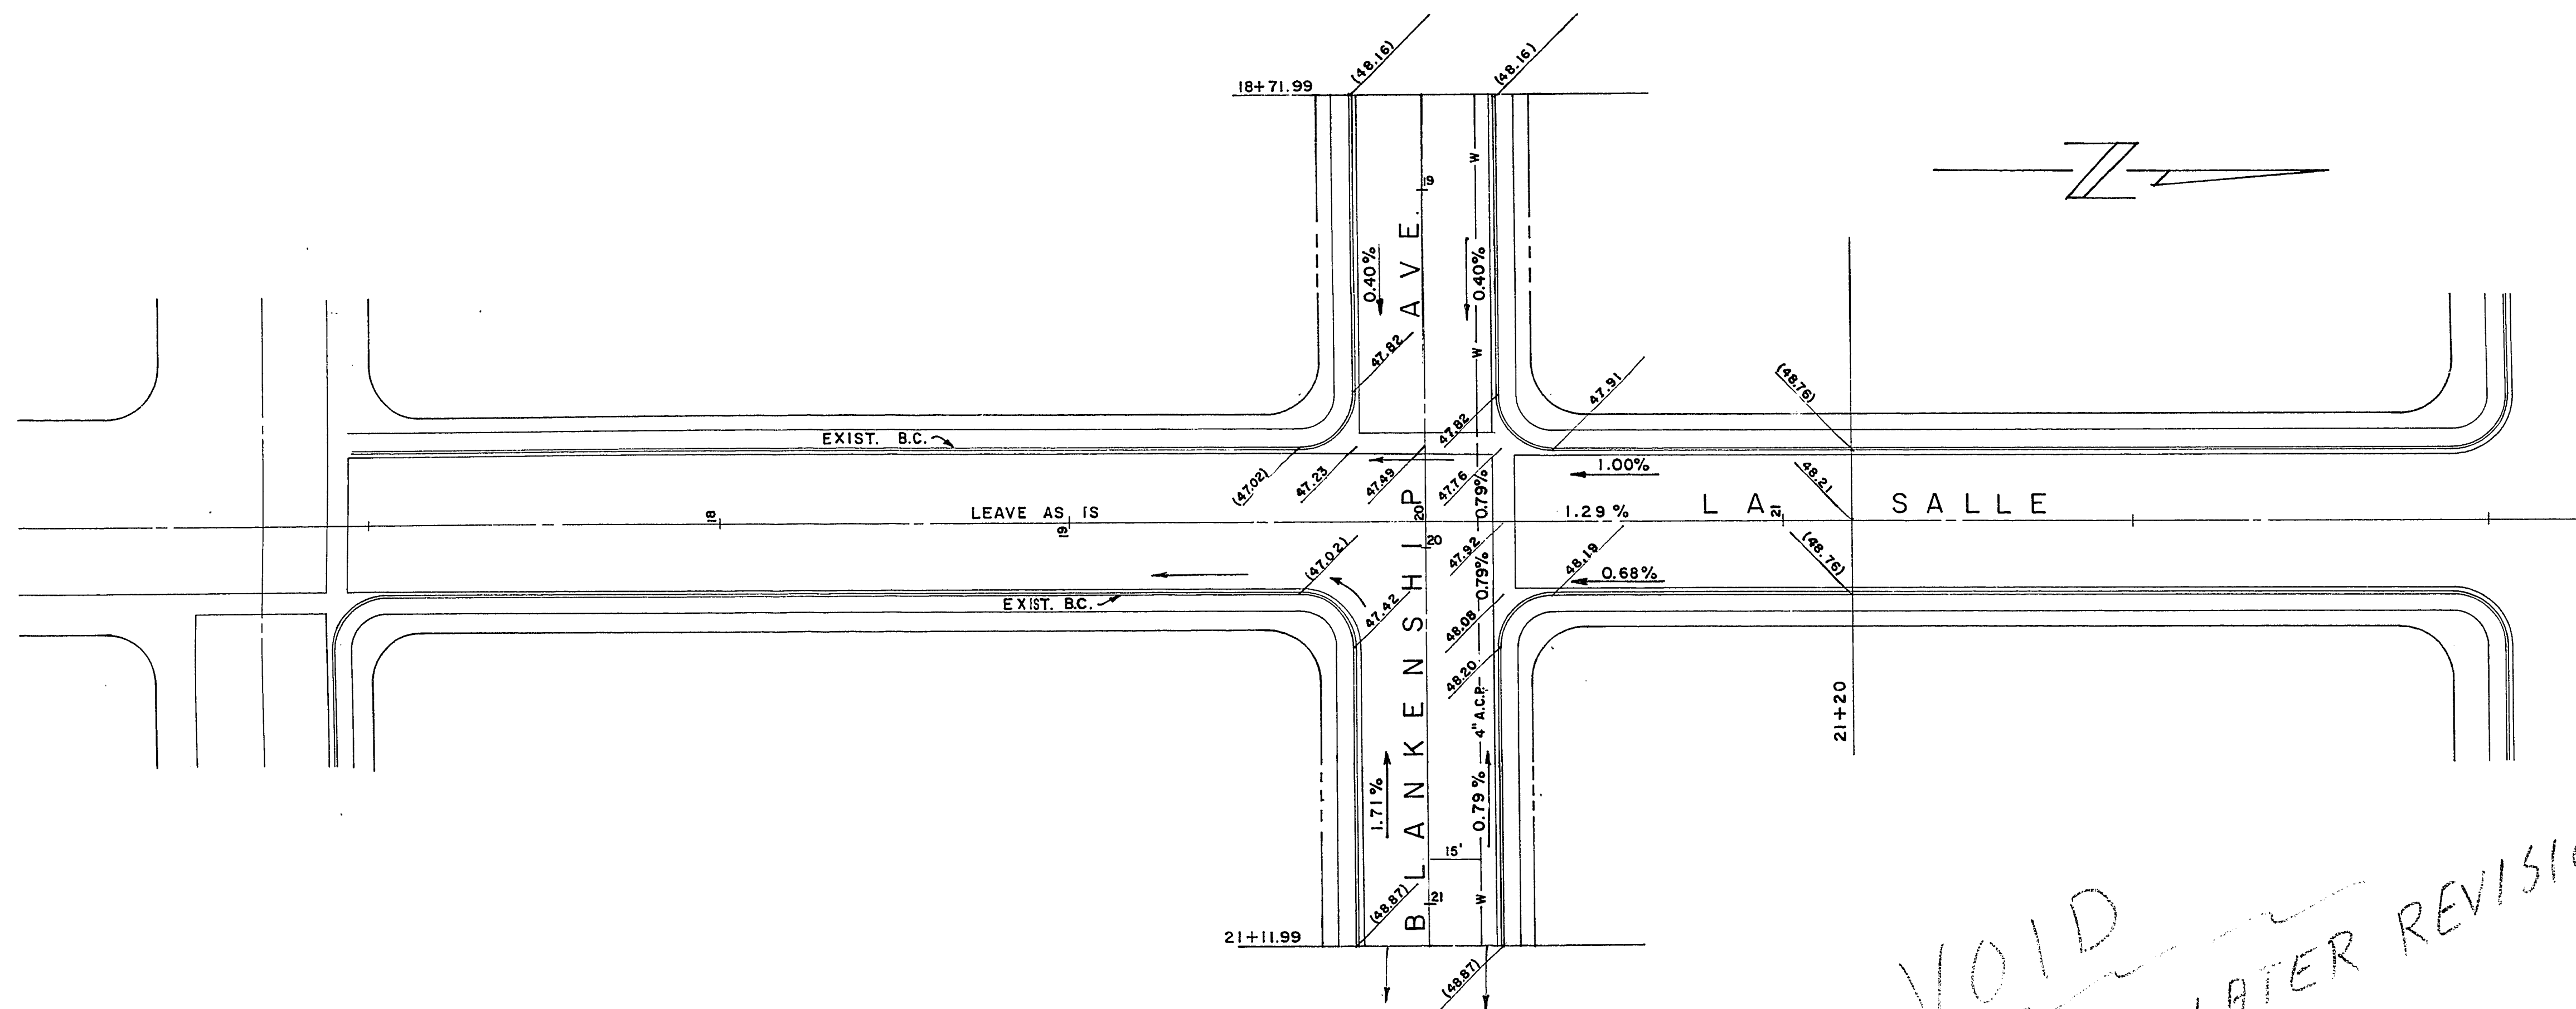


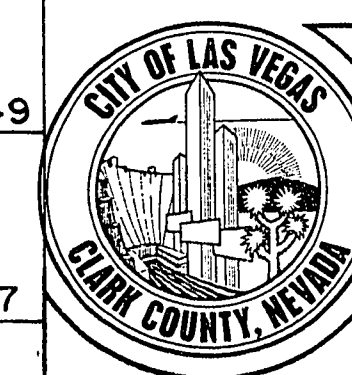

VOID
SEE LATER REVISION

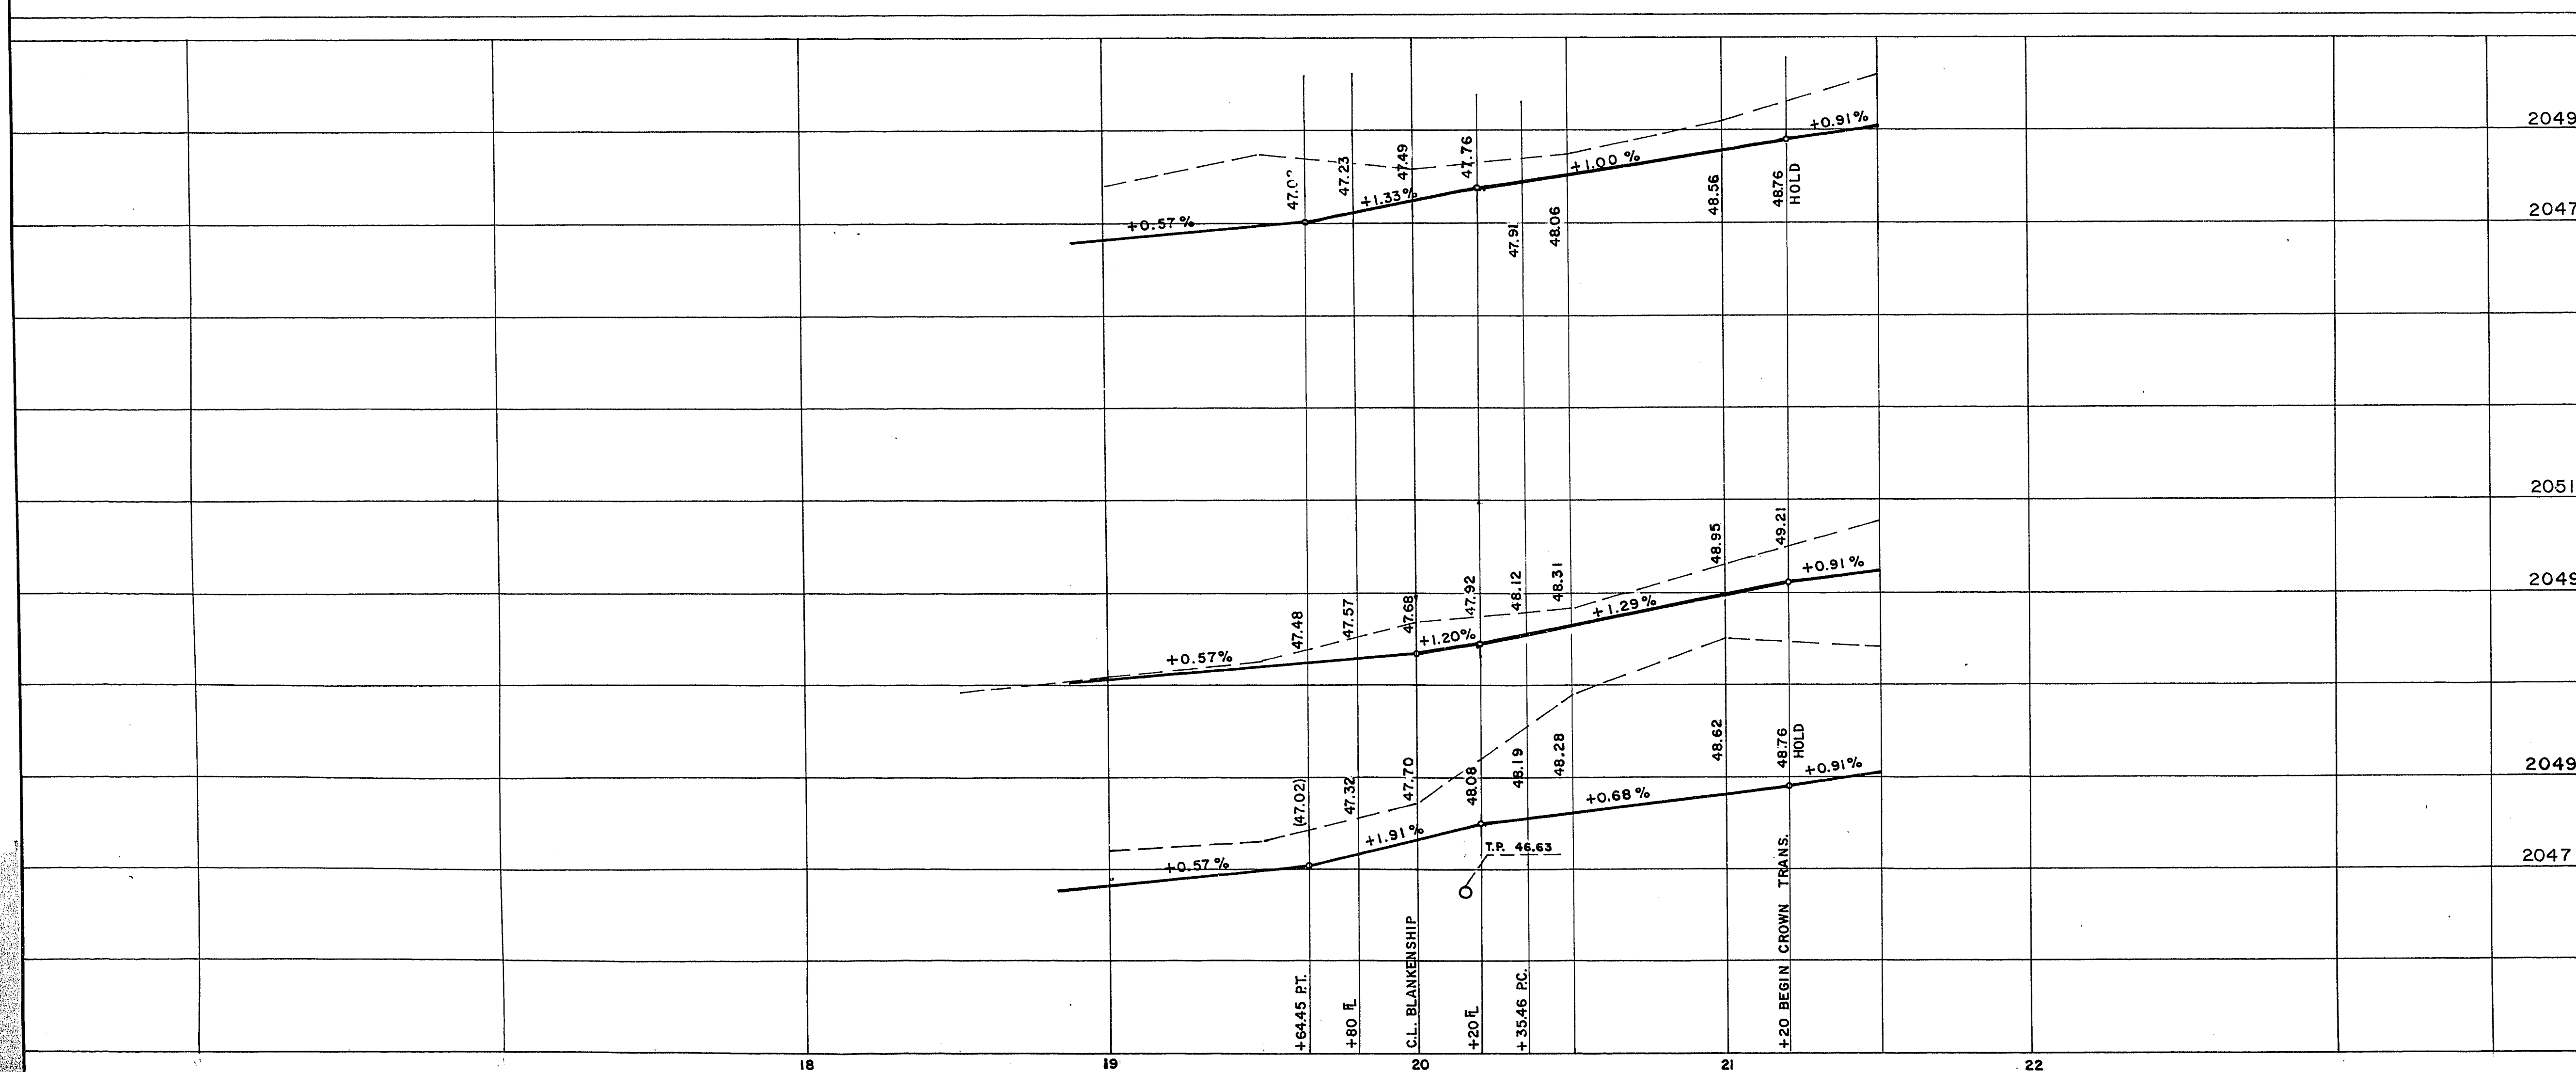

Department of Public Works
Engineering Division

REVISION
OF FLOW LINE GRADES

AT LA SALLE STREET AND
BLANKENSHIP AVENUE (VEGAS HGTS.)

scale (h) 1" = 30'	scale (v) 1" = 2'	drawing no.
w.o.no.	f.bk.no. 73 - 6X	107V-924
design by W.L.J.	drawn by R.W.W.	date 3-2-76
approved by Director of Public Works	date	sht. 1 of 1

21-4-107