


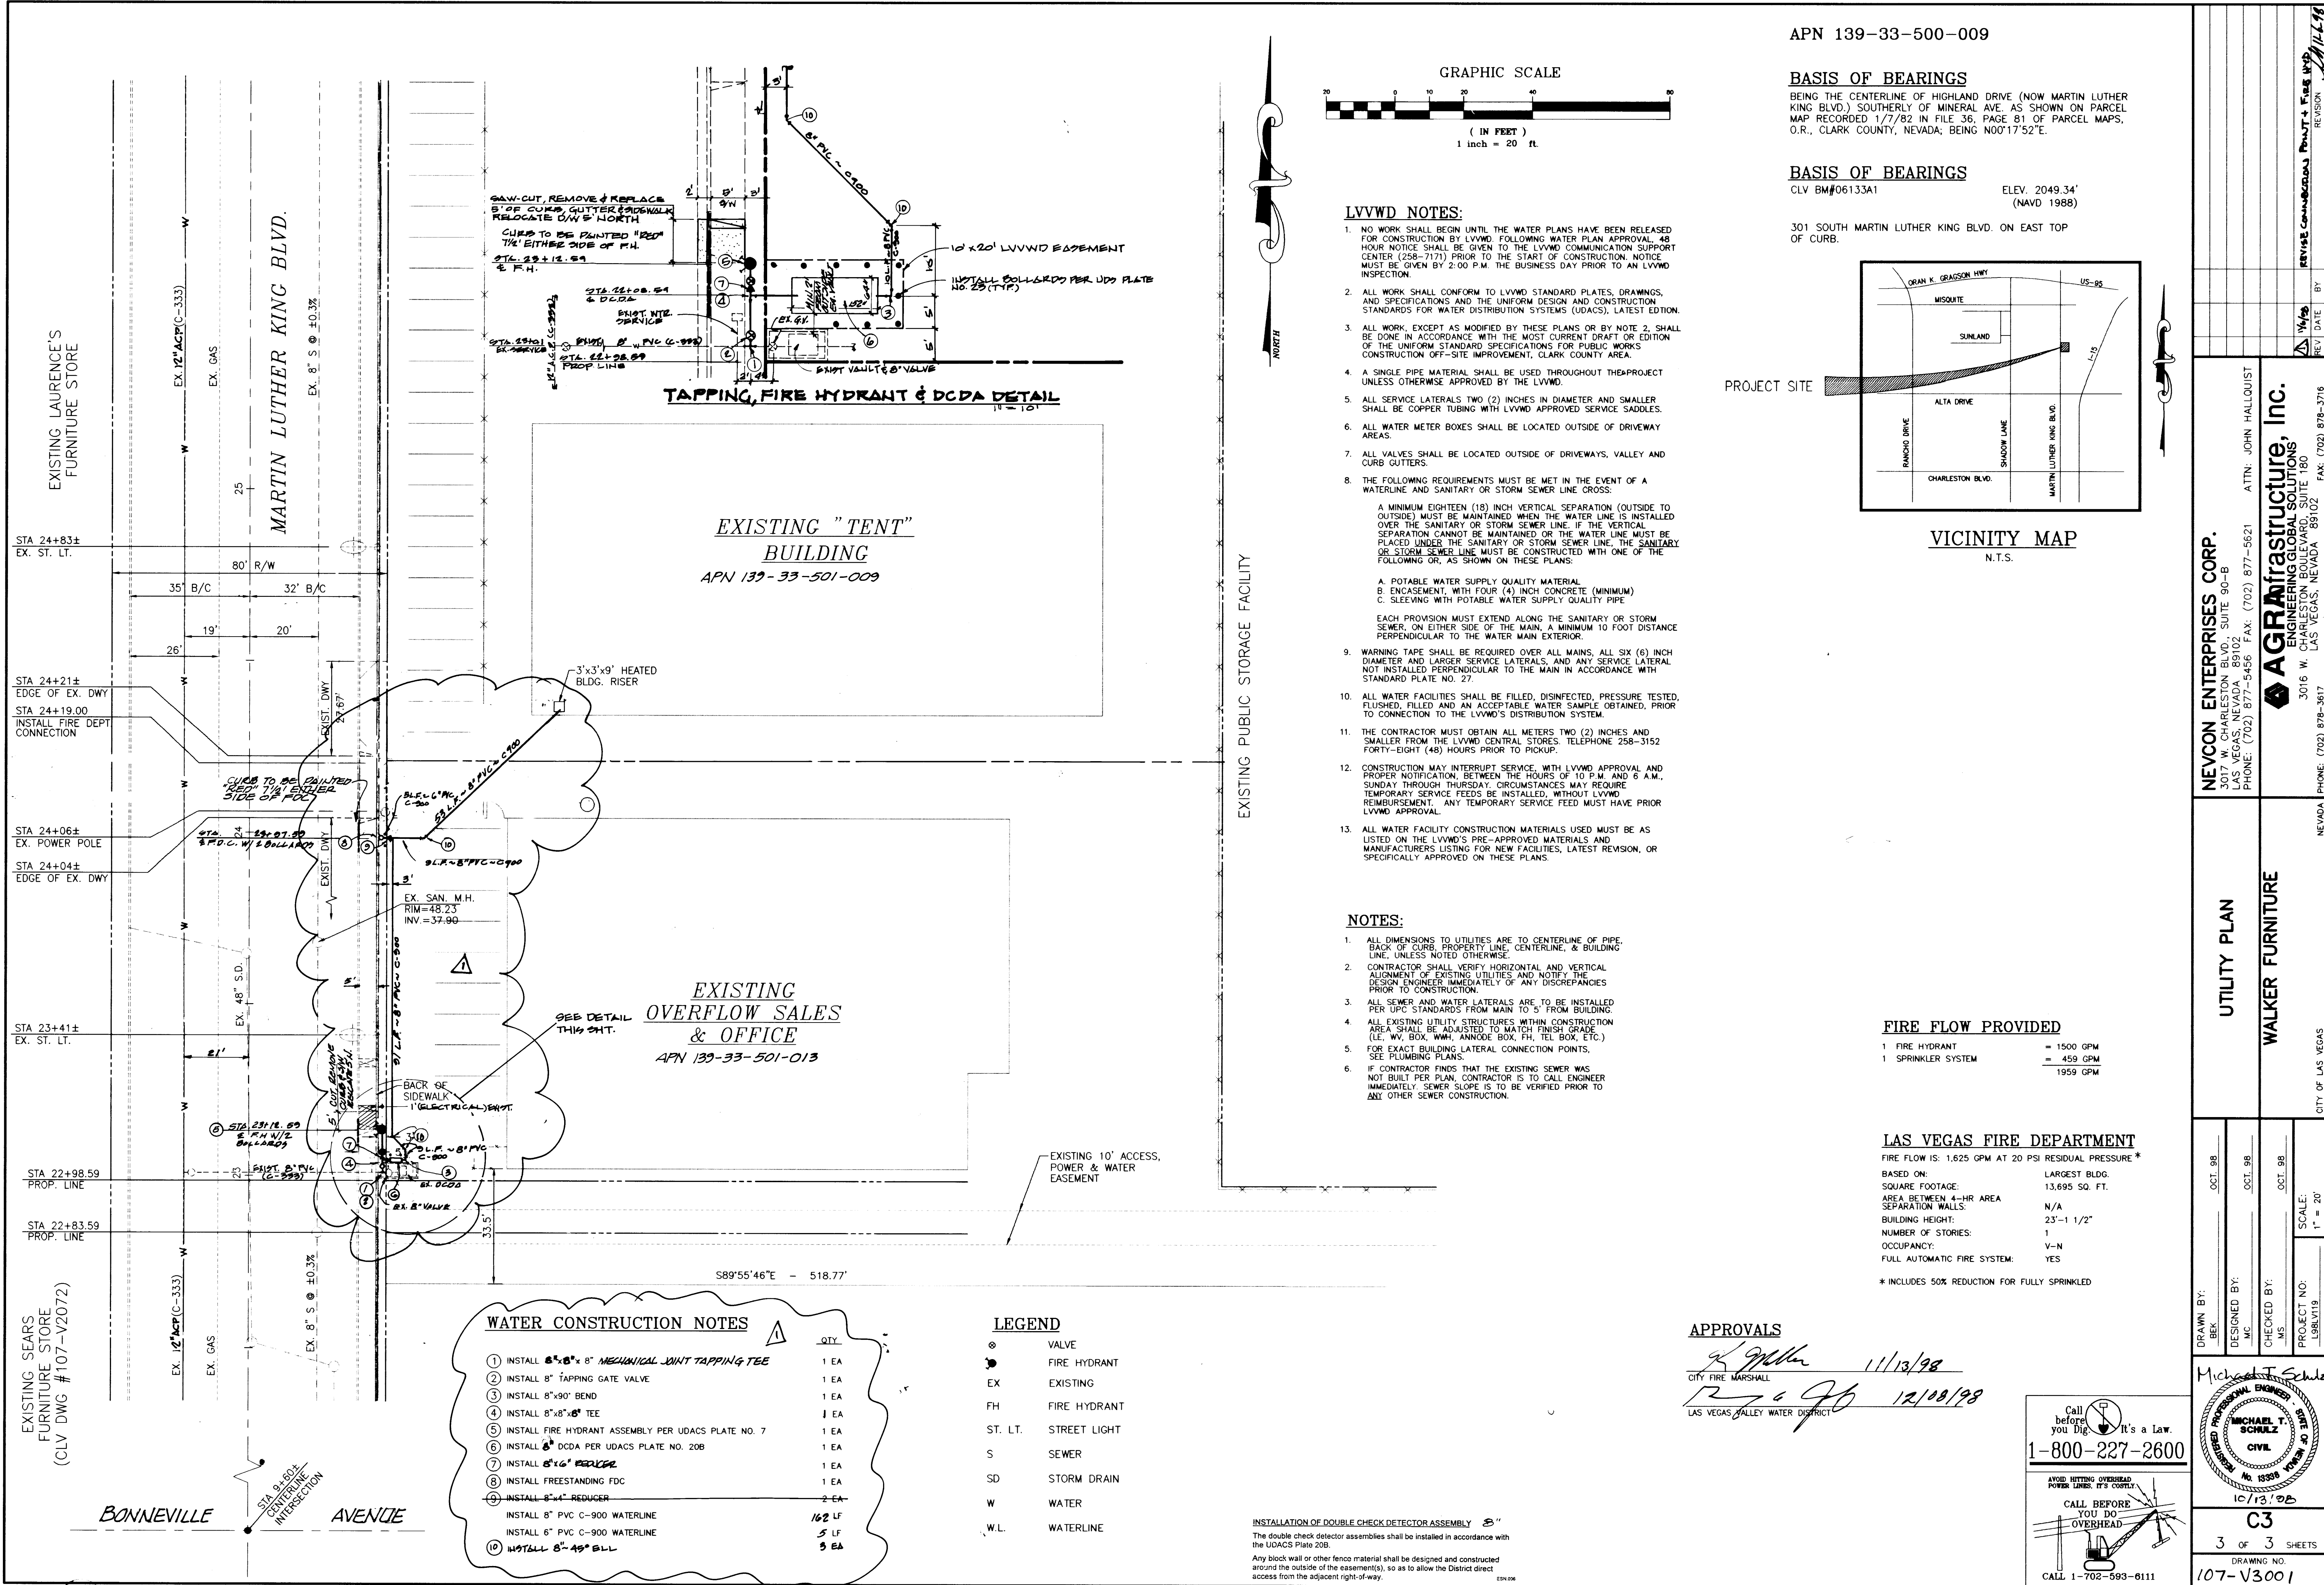

APN 139-33-500-009

REVISION

REVISED COMMERCIAL PRINT & FILE W/CD

BY DATE

ATN: JOHN HALLOQUIST

3017 W. CHARLESTON BLVD., SUITE 90-B  
LAS VEGAS, NEVADA 89102  
PHONE: (702) 877-5456 FAX: (702) 877-5621

**AGRA Infrastructure, Inc.**  
ENGINEERING GLOBAL SOLUTIONS  
3016 W. LAS VEGAS BOULEVARD, SUITE 180  
LAS VEGAS, NEVADA 89102  
PHONE: (702) 878-3617

**NEVCON ENTERPRISES CORP.**  
3017 W. CHARLESTON BLVD., SUITE 90-B  
LAS VEGAS, NEVADA 89102  
PHONE: (702) 877-5456 FAX: (702) 877-5621

**UTILITY PLAN**

**WALKER FURNITURE**

**CITY OF LAS VEGAS**

**Michael T. Schulz**  
PROFESSIONAL ENGINEER  
No. 13358  
10/13/98


**C3**  
3 OF 3 SHEETS  
DRAWING NO. 107-V3001

**Call before you Dig**  
It's a Law.  
1-800-227-2600  
CALL BEFORE YOU DIG OVERHEAD  
CALL 1-702-593-6111

EXISTING UNIVERSITY  
FOOTWIDE STRIP

MARTIN LUTHER KING BLVD.

ALCANTARA

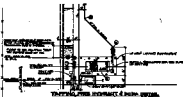


EXISTING "TENT"  
BUILDING  
APRIL 1971 - 10-1971-1972

EXISTING  
OVERVIEW SALON  
& OFFICE  
APRIL 1971-10-1971-1972

PROPERTY - 10-1971



EXISTING PUBLIC STORAGE (INCLUT)



APR 196-35-300-000






**APPROVALS**  
*[Signature]*  
*[Signature]*  
*[Signature]*



UTILITY PLAN  



