


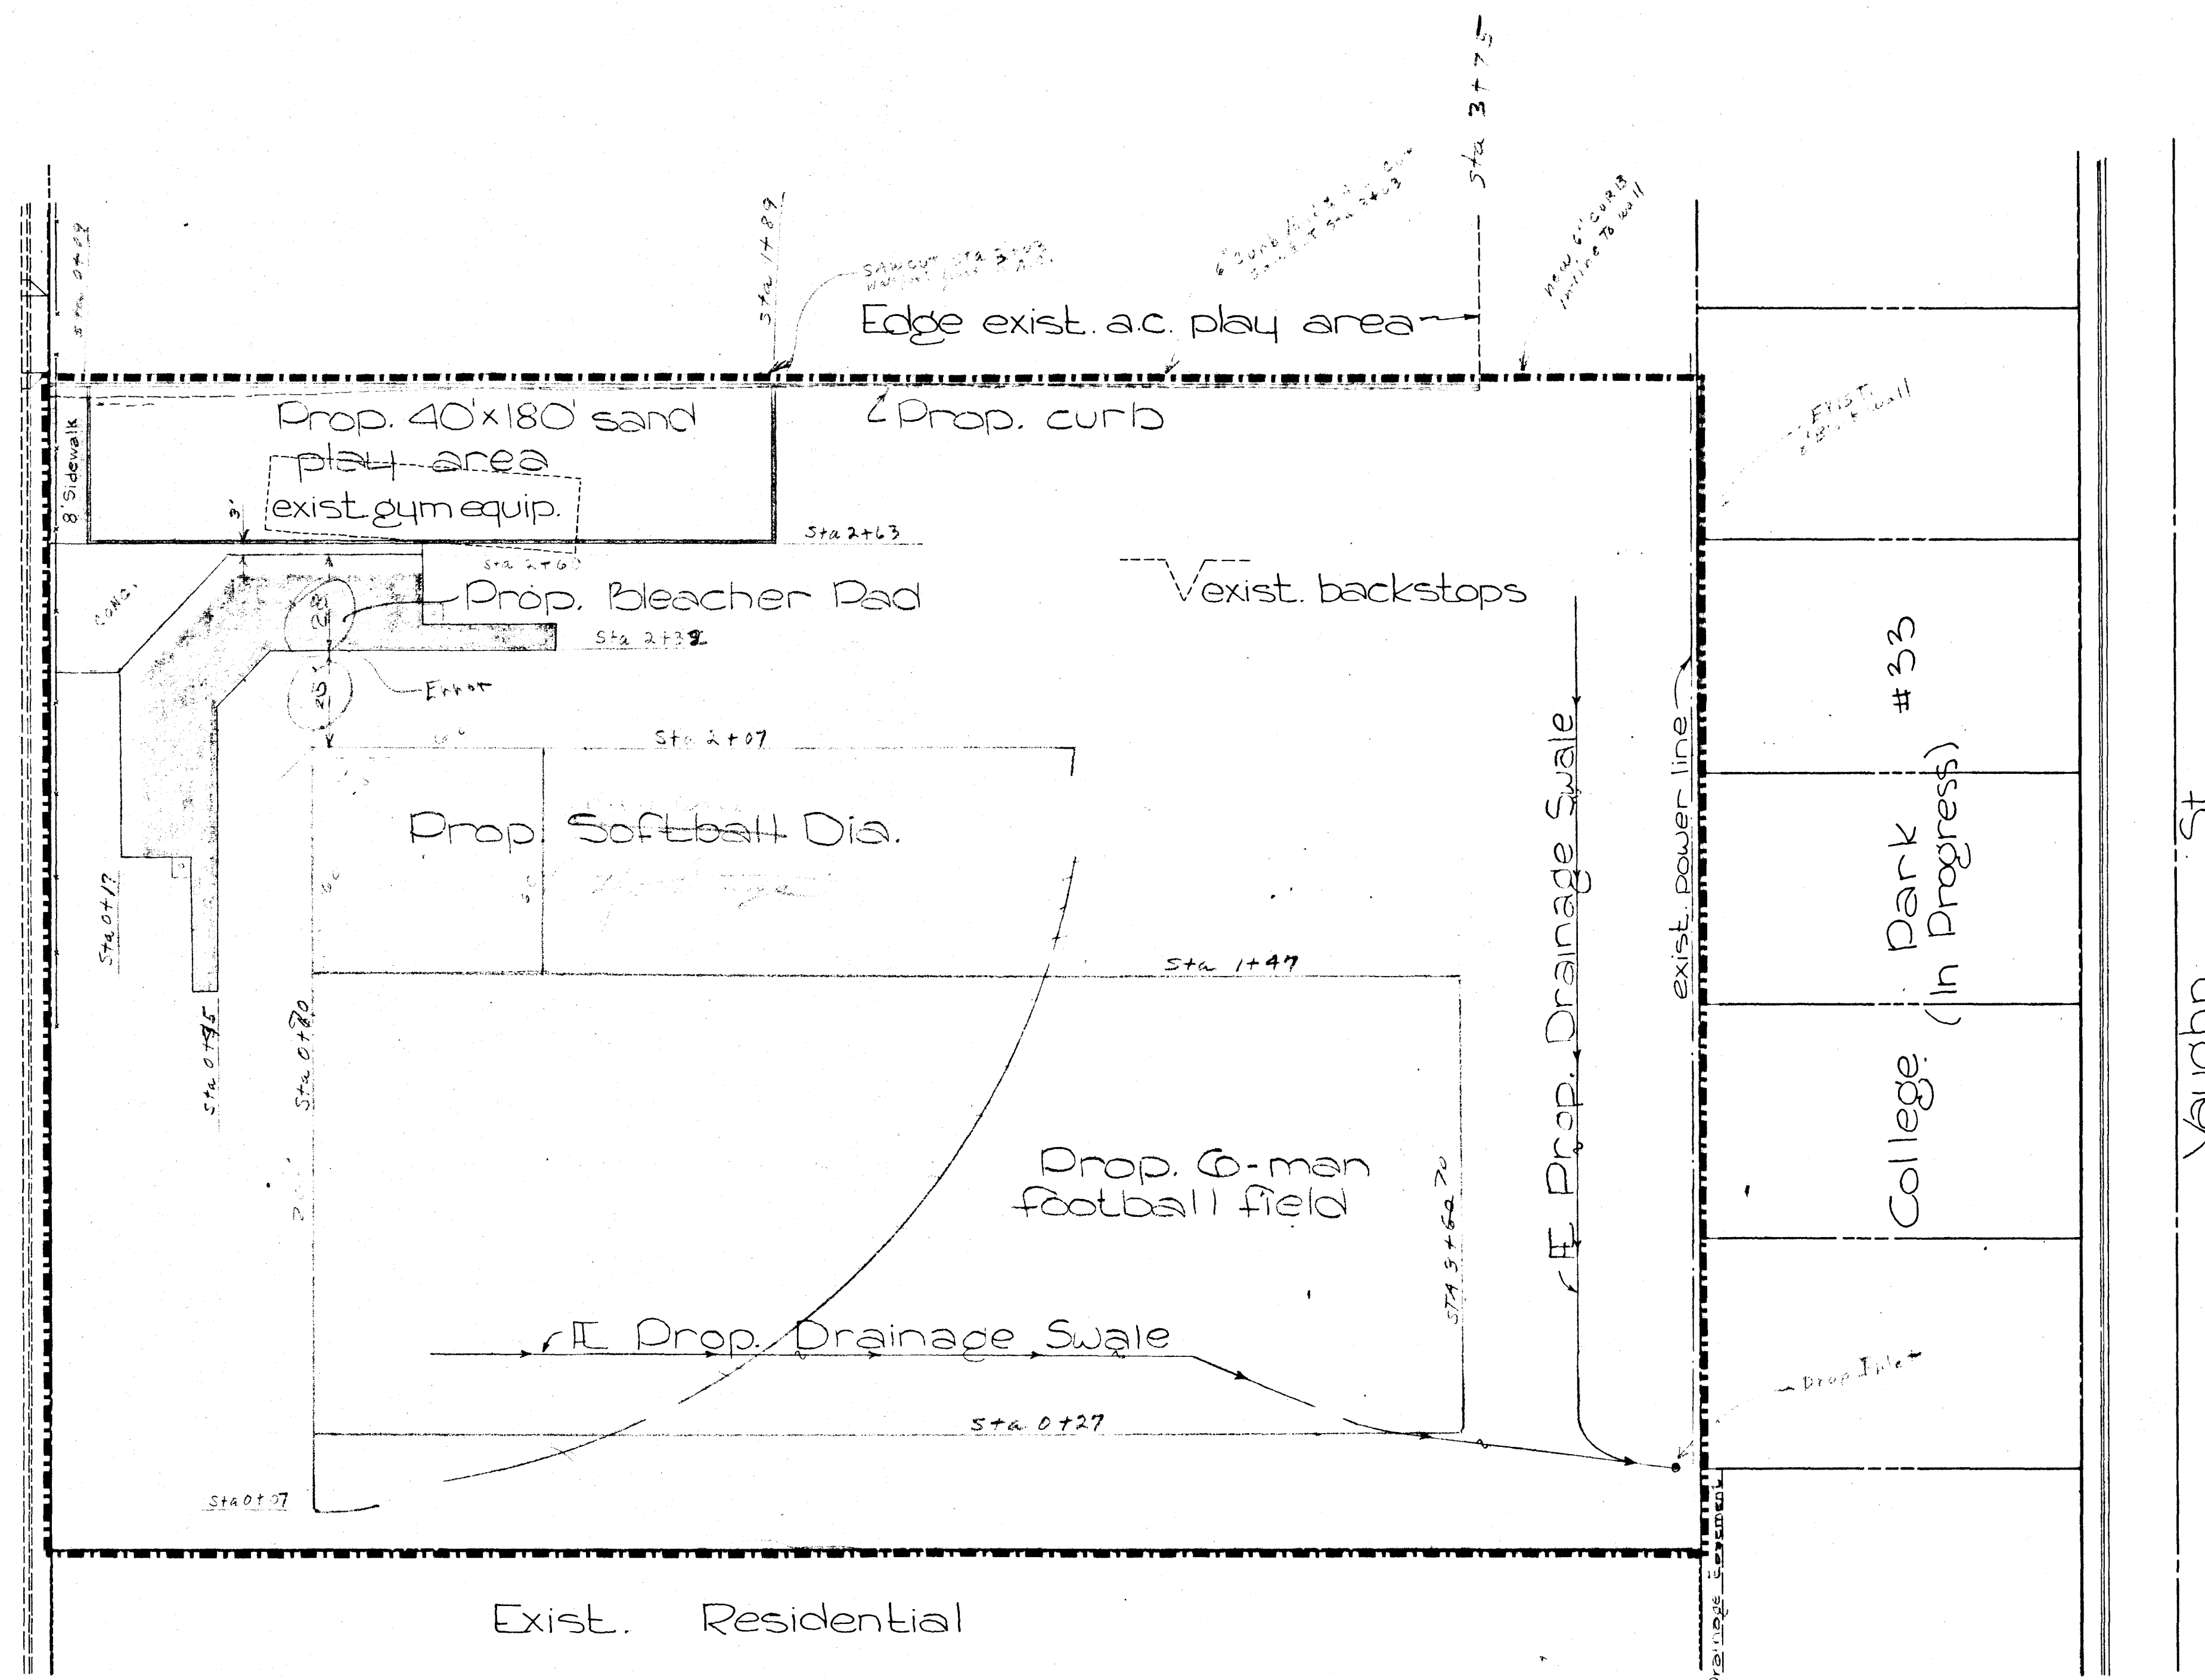

Twenty-Seventh St.



APPROVALS:

<i>[Signature]</i>	4-1-77
Coordinator of Urban Renewal	Date
<i>[Signature]</i>	4-6-70
Superintendent of Recreation	Date
Superintendent of Parks	Date
Director of Public Works	Date
For Clark County School Dist.	Date

CITY OF LAS VEGAS NEVADA			
DEPARTMENT OF PUBLIC WORKS			
SERVICES DIVISION			
Walter Bracken School-Diplot Plan			
W.O. NO 3062	F.B.K. NO. 67-135X	DATE	DRAWING NO.
SC (H) 1"=30'	SC (V)		
DES RT. Whitney			FILE NO.
DR cappy			715-492
APPROVED BY DIRECTOR OF PUBLIC WORKS			SHEET 1 OF 3
<i>[Signature]</i>			