


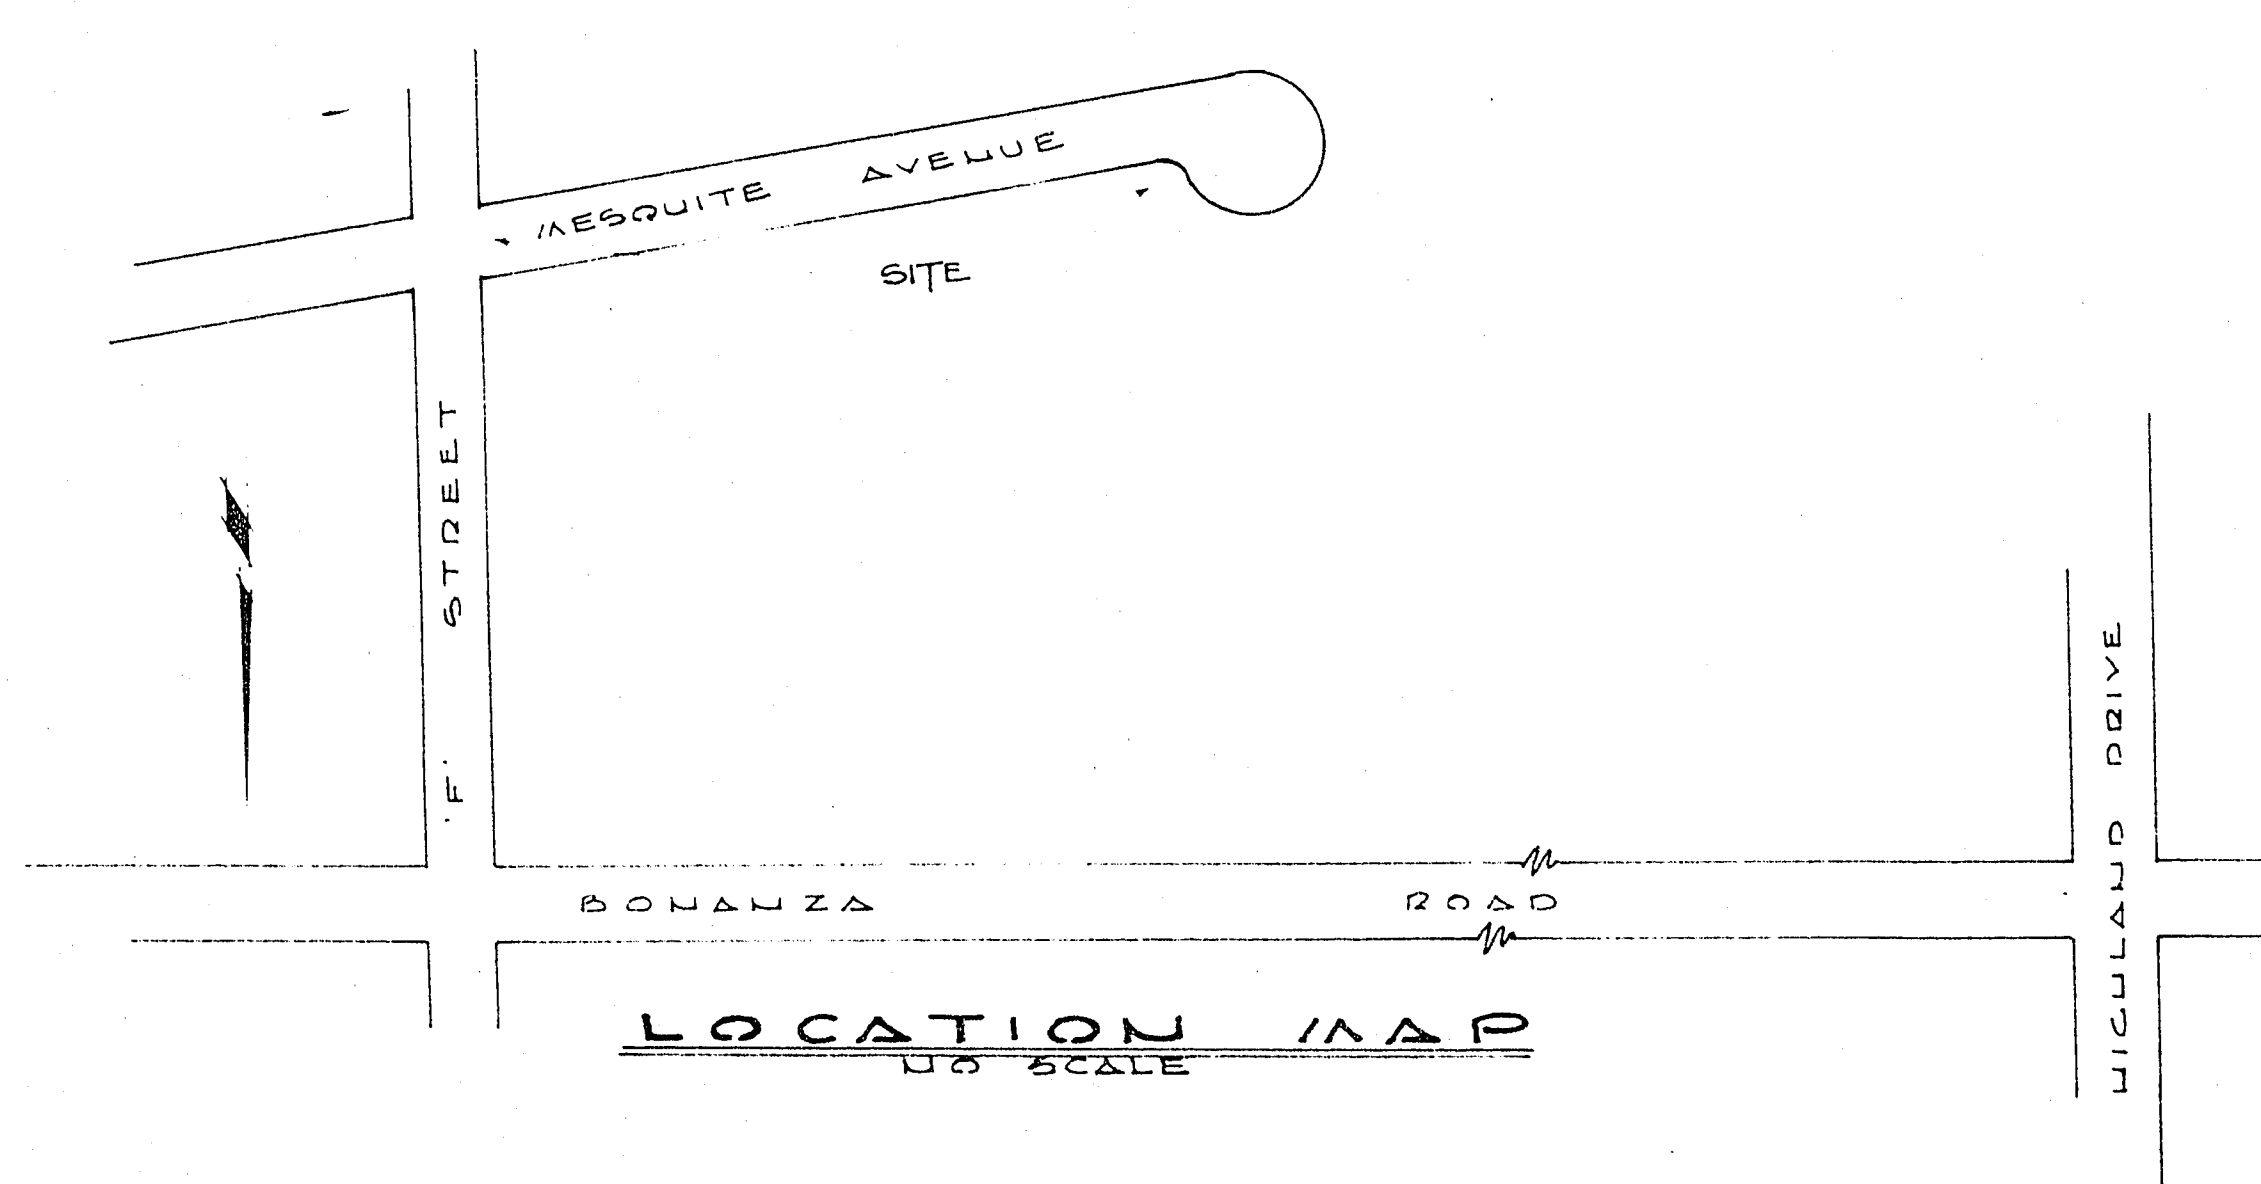


NOTES

1. WATER LINE TO BE CONSTRUCTED PRIOR TO STREET CONSTRUCTION
2. ALL PIPE TO BE PROPERLY TURNED BLOCKED AND ZEP'D
3. ALL PIPE TO HAVE A MINIMUM COVER OF 36"
4. FIVE HYDRAULICS TO MEET CITY OF LAS VEGAS FIRE DEPT. REQUIREMENTS
5. ALL CONSTRUCTION SHALL COMPLY WITH LV V.V.D. SPEC S-1
6. ALL PIPE TO BE PRESSURE TESTED AT 200 P.S.I.
7. EVIDENCE OF APPROVED EXCAVATION PERMIT MUST BE PRESENTED TO THE LV V.V.D. 48 HOURS PRIOR TO ACTUAL CONSTRUCTION.
8. ALL FLANGED FITTINGS TO BE COATED WITH EC-244 OR DISTRICT APPROVED EQUIVALENT (6 MIL THICKNESS) AND WRAPPED WITH APPROVED PLASTIC MATERIAL.

☐ DOMESTIC WATER METER BOX INSTALLED BY LAS VEGAS VALLEY WATER DISTRICT.

ΔS BUILT	
SEPT. 21 1971	
N.B. Will	10/11
CITY ENGINEER	DATE
Gene J. Smith	10-22
FIELD ENGINEER	DATE
M. Will	10/6
LAS VEGAS VALLEY WATER DIST	DATE
Richard J. Baumhau	10-15

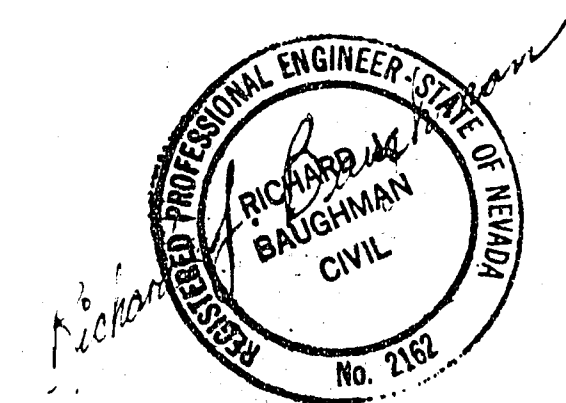

UPPR Prep-Sts 107-V8

515-102

SHEET 1 2 3	WATER PLAN SECTION 27, TOWNSHIP 20 SOUTH, RANGE 61 EAST CITY OF LAS VEGAS, NEVADA	BAUGHMAN HAUGHT & TURNER CIVIL ENGINEERS, PLANNING ENGINEERS LAND SURVEYORS 2975 WEST CHARLESTON BLVD. LAS VEGAS, NEVADA	APPROVALS CITY OF LAS VEGAS ENGINEER DATE CITY OF LAS VEGAS AIDE CHIEF DATE <i>Shane Higgins</i> 1/27/71		DATE DESIGNED BY: <i>PHS</i> CHECKED BY: SCALE: NOTED	REVISIONS DATE	APPD.