


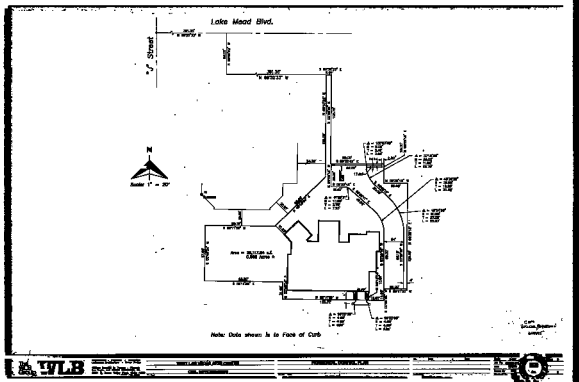

	AG-BUILT
	WEST LAS VEGAS ARTS CENTER DOORVILLE PARK - LAS VEGAS, NEVADA HORIZONTAL CONTROL PLAN
671-46 671-46	C-13 671-46