


Harry Campbell Architects
1800 East Platteau Road, Suite 120 Las Vegas, NV 89119 (702) 731-0363 Fax (702) 731-8266

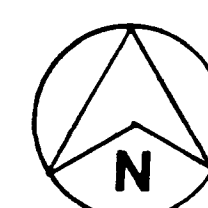

A
E10

- 1 INTEGRAL BATTERY UNITS SHALL BE WIRED FOR SWITCHED OPERATION.
- 2 MOUNT REMOTE BALLAST ADJACENT TO FIXTURE IN COVE AS DIRECTED BY ARCHITECT.
- 3 PROVIDE CONFIGURATION SHOWN.
- 4 LIGHTING FIXTURES IN THIS ROOM SHALL BE DUAL SWITCHED - OUTER LAMPS ON ONE SWITCH INNER LAMPS ON SECOND SWITCH - REWIRE BALLASTS AS NECESSARY.
- 5 PROVIDE STAFF THREE CIRCUIT TRACK SURFACE MOUNTED WHITE IN COLOUR. PROVIDE ONE TYPE 'M' LIGHTING FIXTURE FOR EVERY 4' OF TRACK.
- 6 WEATHERPROOF RECEPTACLES FOR 3Ø, 4Ø LVS. INSTALLED ON UNDERSIDE AT SHADE STRUCTURE. COORD. LOCATION WITH MOUNTING PIPE FOR SHADE LOTS.
- 7 STRAND LIGHTING PAR 64 WP 500W NARROW SPOT.
- 8 STRAND LIGHTING PAR 64 WP 500W NARROW SPOT.
- 9 FIXTURES SHALL BE PIPE BOTTOM MOUNTED ON 1-1/4" BLACK STEEL PIPE. ELECTRICAL CONTRACTOR SHALL PROVIDE AND INSTALL PIPE. COORD. AS REQ'D.
- 10 PROVIDE 2000VA RATE DIMMERS.
- 11 LOCATE SNAP & DIMMER SWITCHES UNDER COUNTER IN RM. 126. COORD. EXACT LOCATION W/ ARCHITECTURAL DRAWINGS/DETAIL'S.
- 12 PROVIDE RECESSED LOCKABLE WEATHERPROOF ENCLOSURE W/ 5 - 3 PQL 120V/2ØA SWITCHES FOR BALLAST STRUCTURE AND STAGE LIGHTS. Tie SWITCHES IN DIRECTED TO SWITCHES UNDER COUNTER IN RM. 126. COORD. AS REQ'D.

- NOT ALLOWED - WILL VOID U.C. LISTING


Gen
Nucleus/American
3/29/5

671-46

Project: **WEST LAS VEGAS ARTS CENTER
DOOLITTLE PARK • LAS VEGAS, NEVADA**

ELECTRICAL FLOOR PLAN ~~AS-BUILT~~

Project:		
Date	8/12/52	
Drawn By	KNF	Checked By DOB
Project No.	92-160	
Scale:	1/8" = 1'-0"	
Sheet No.	E1.0	

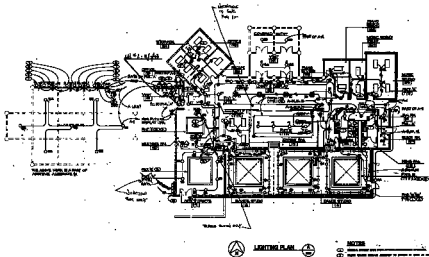

LIGHTING PLAN

NOTES

1/2" = 1'-0"

671-46

WEST LAS VEGAS ARTS CENTER
DOOLITTLE PARK - LAS VEGAS, NEVADA

ELECTRICAL FLOOR PLAN

ELO