13-1-27

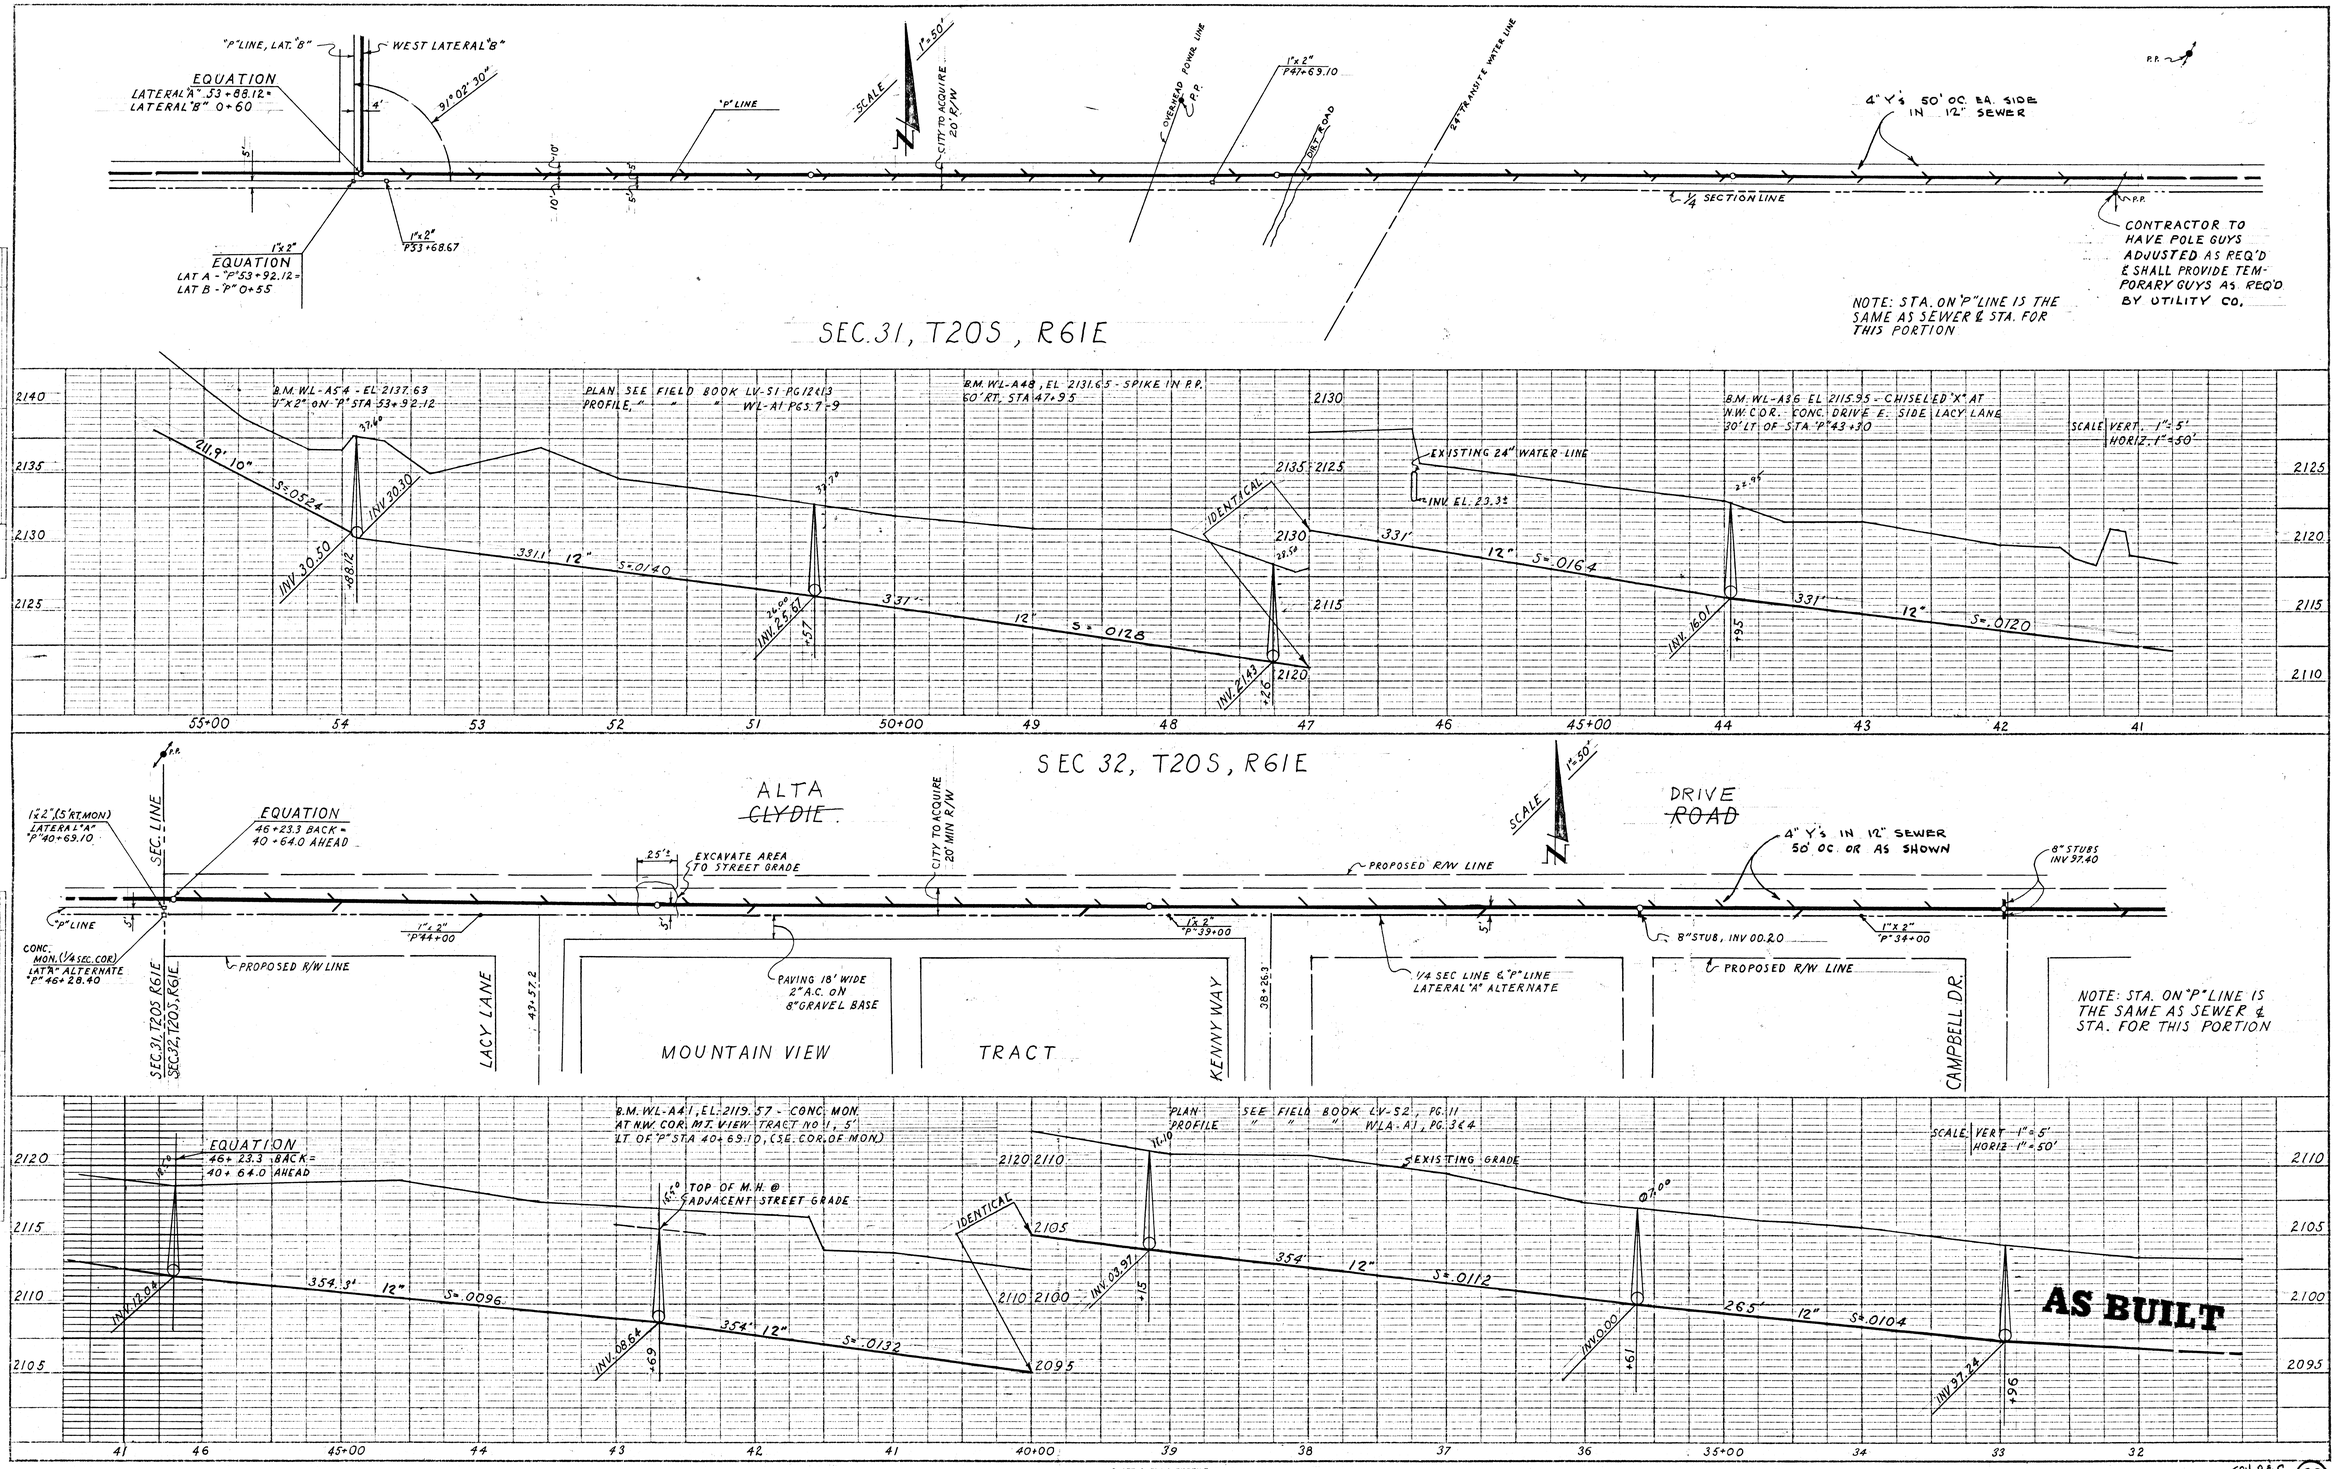

PLATE 2 PLAN PROFILE - F.A.S.
GOVERNMENT PRINTING OFFICE, S.F. CAL.
No. 13600H 2