
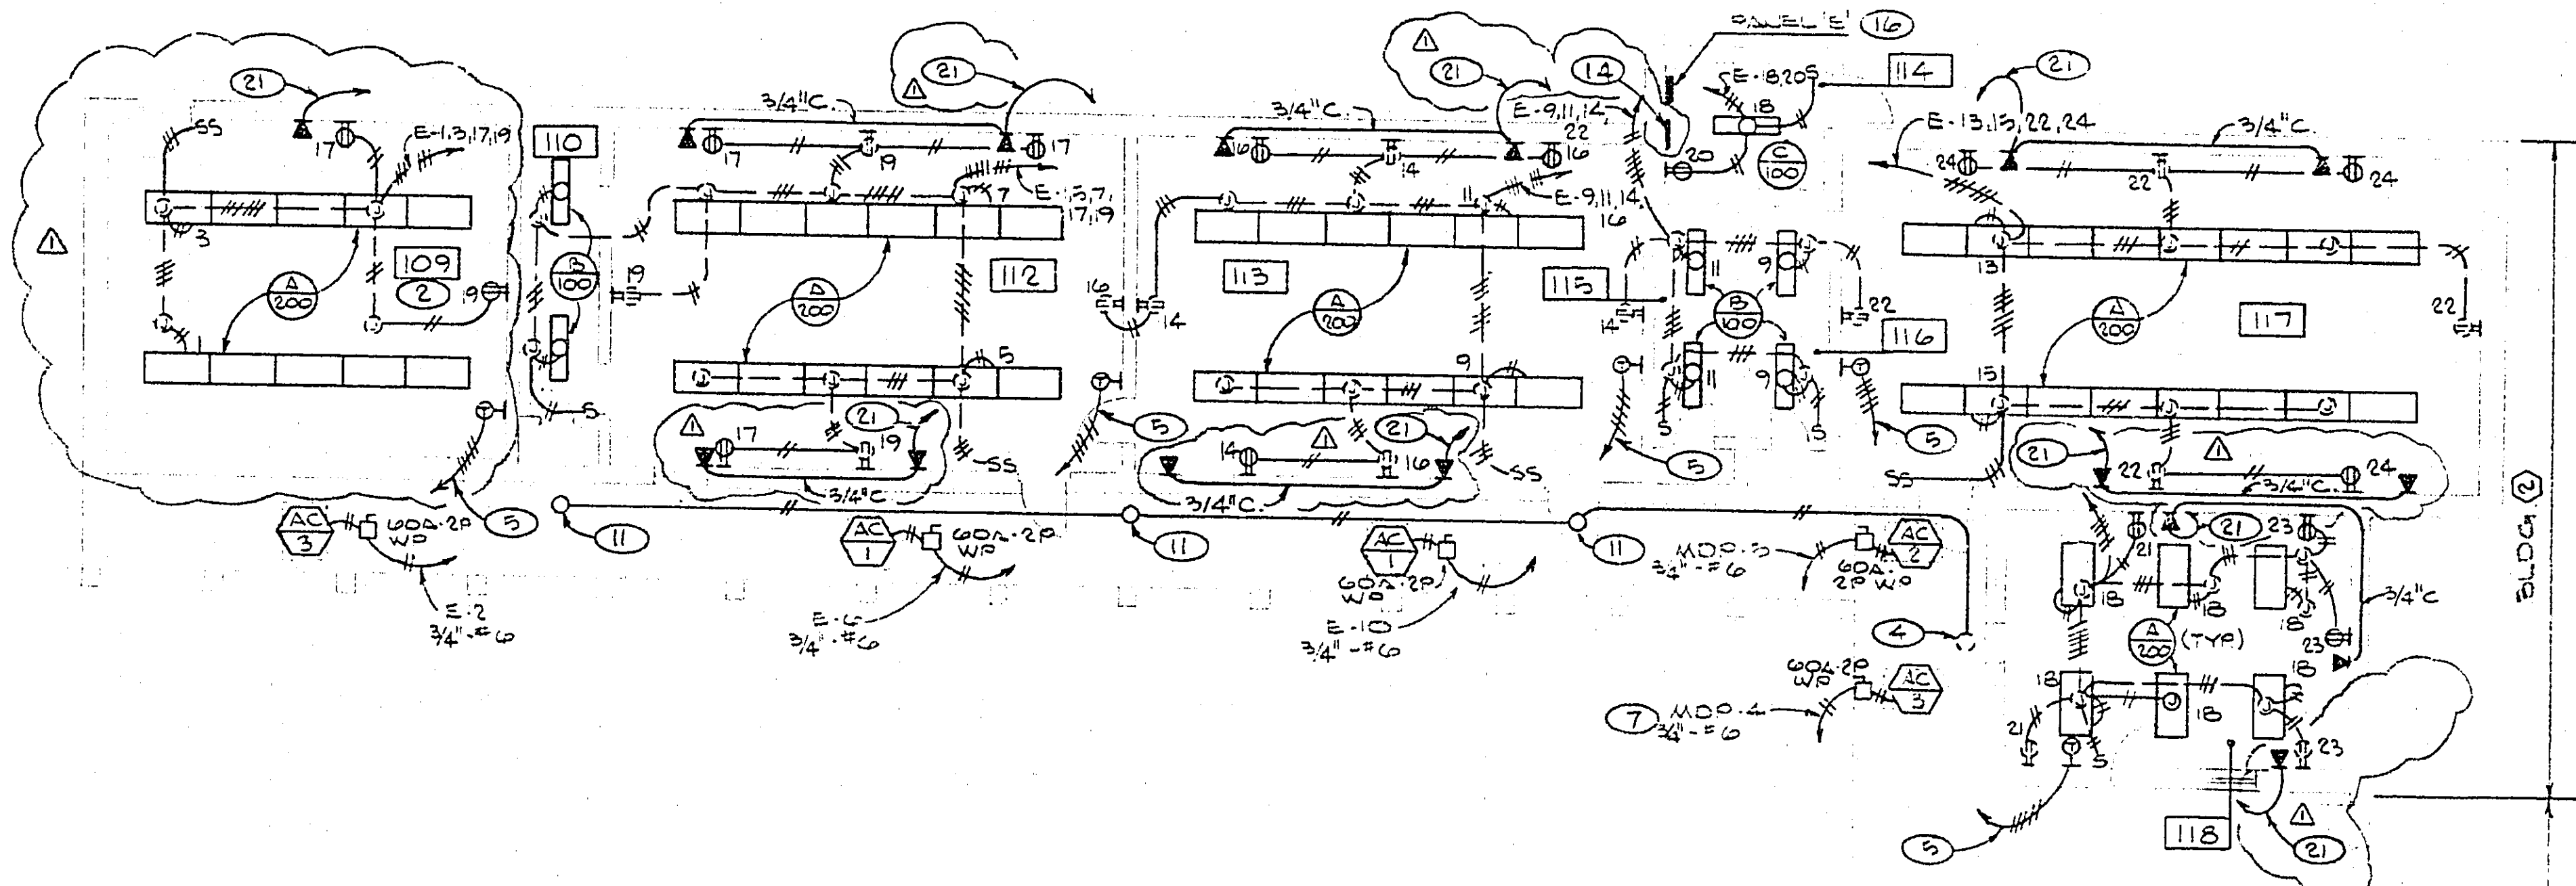
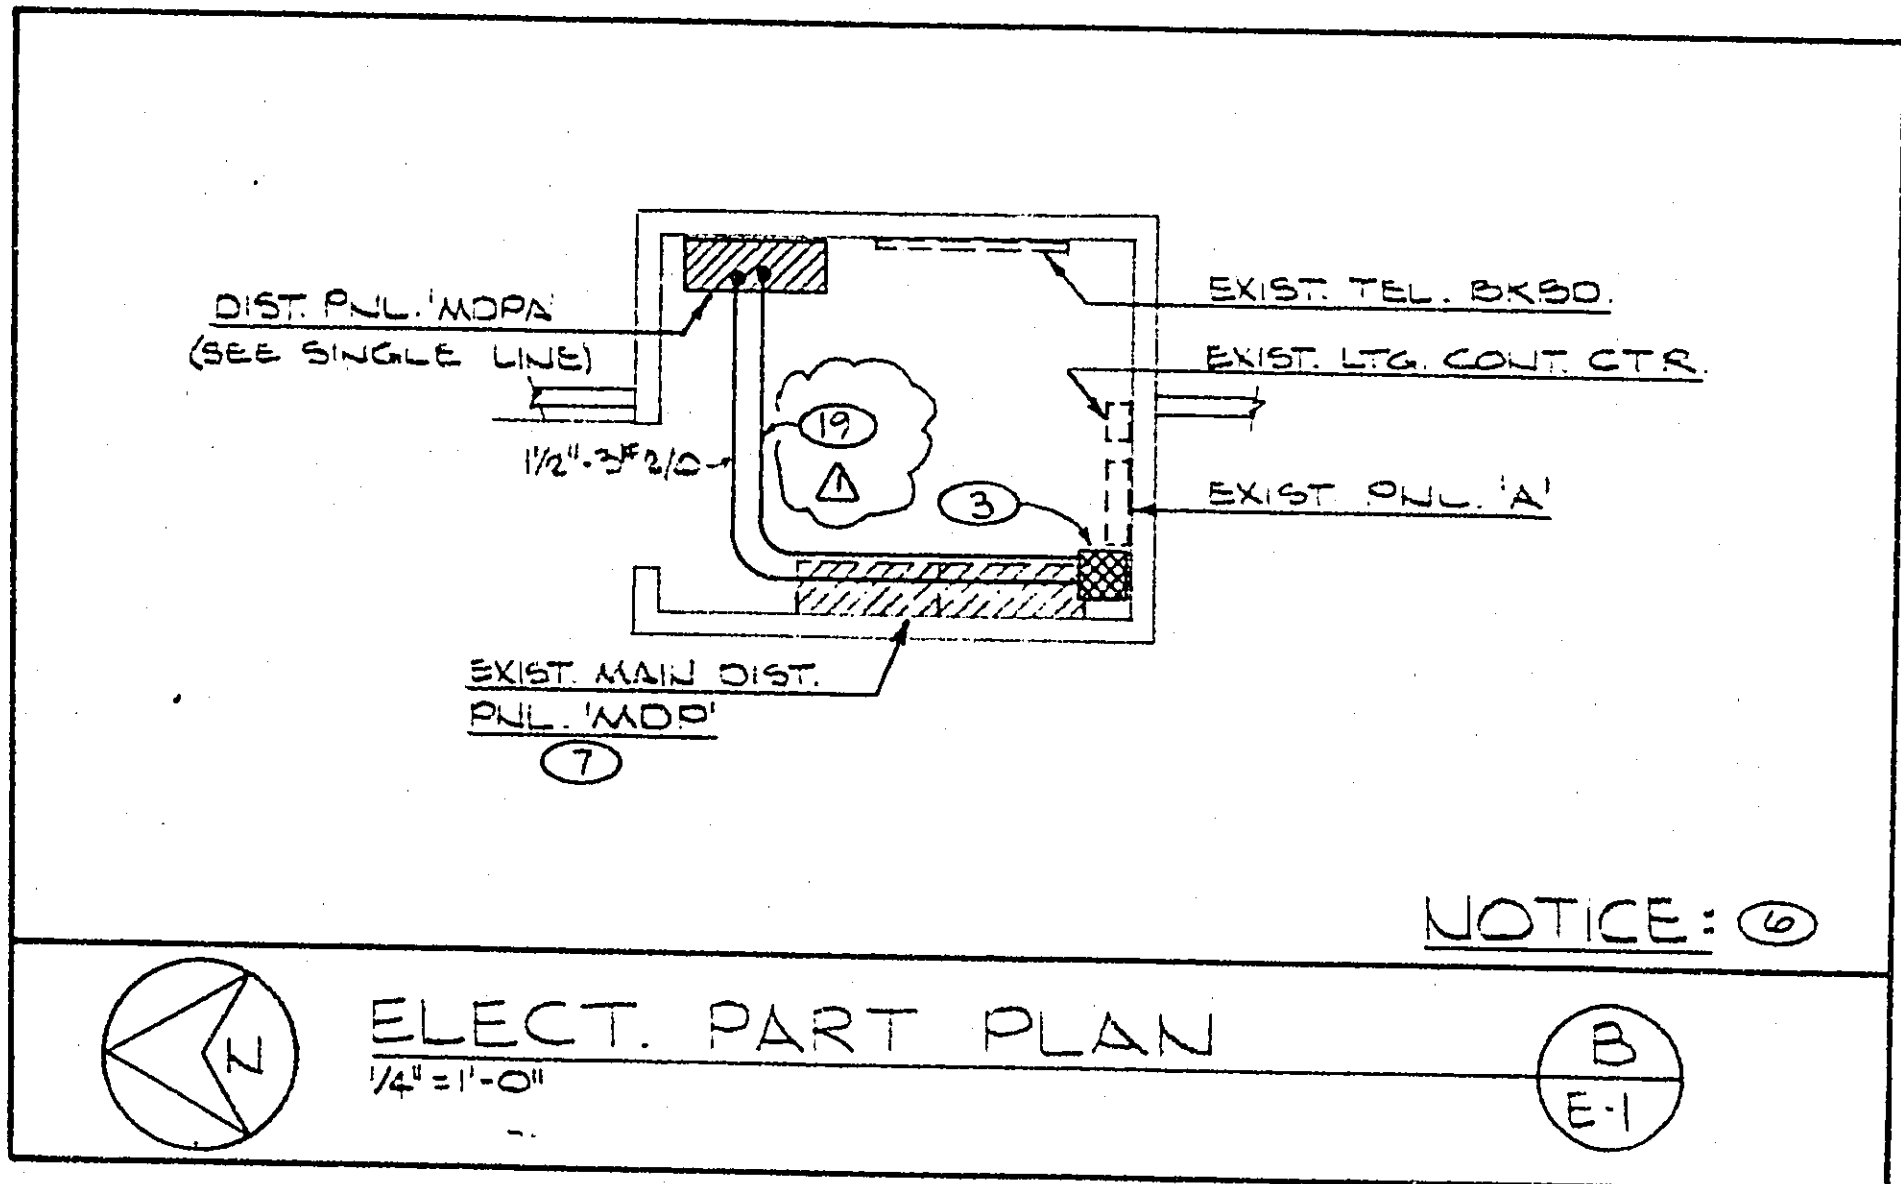



FIXTURE LIST						
TYPE	LAMPS	VOLTS	MOUNTING	DESCRIPTION		
				MANUFACTURER	CATALOG NO	REMARKS
AC-1	2	120	RECESSED	PROCENTAL	E-102-4885-09A	2ND FLOR.
AC-1	2	120	RECESSED	PROCENTAL	E-102-4885-09A	1X4 FLOR.
AC-1	2	120	RECESSED	PROCENTAL	E-102-4885-09A	1X4 FLOR.
AC-1	1	120	RECESSED	MARCO	UP-4-3L	WP DJ. LIGHT

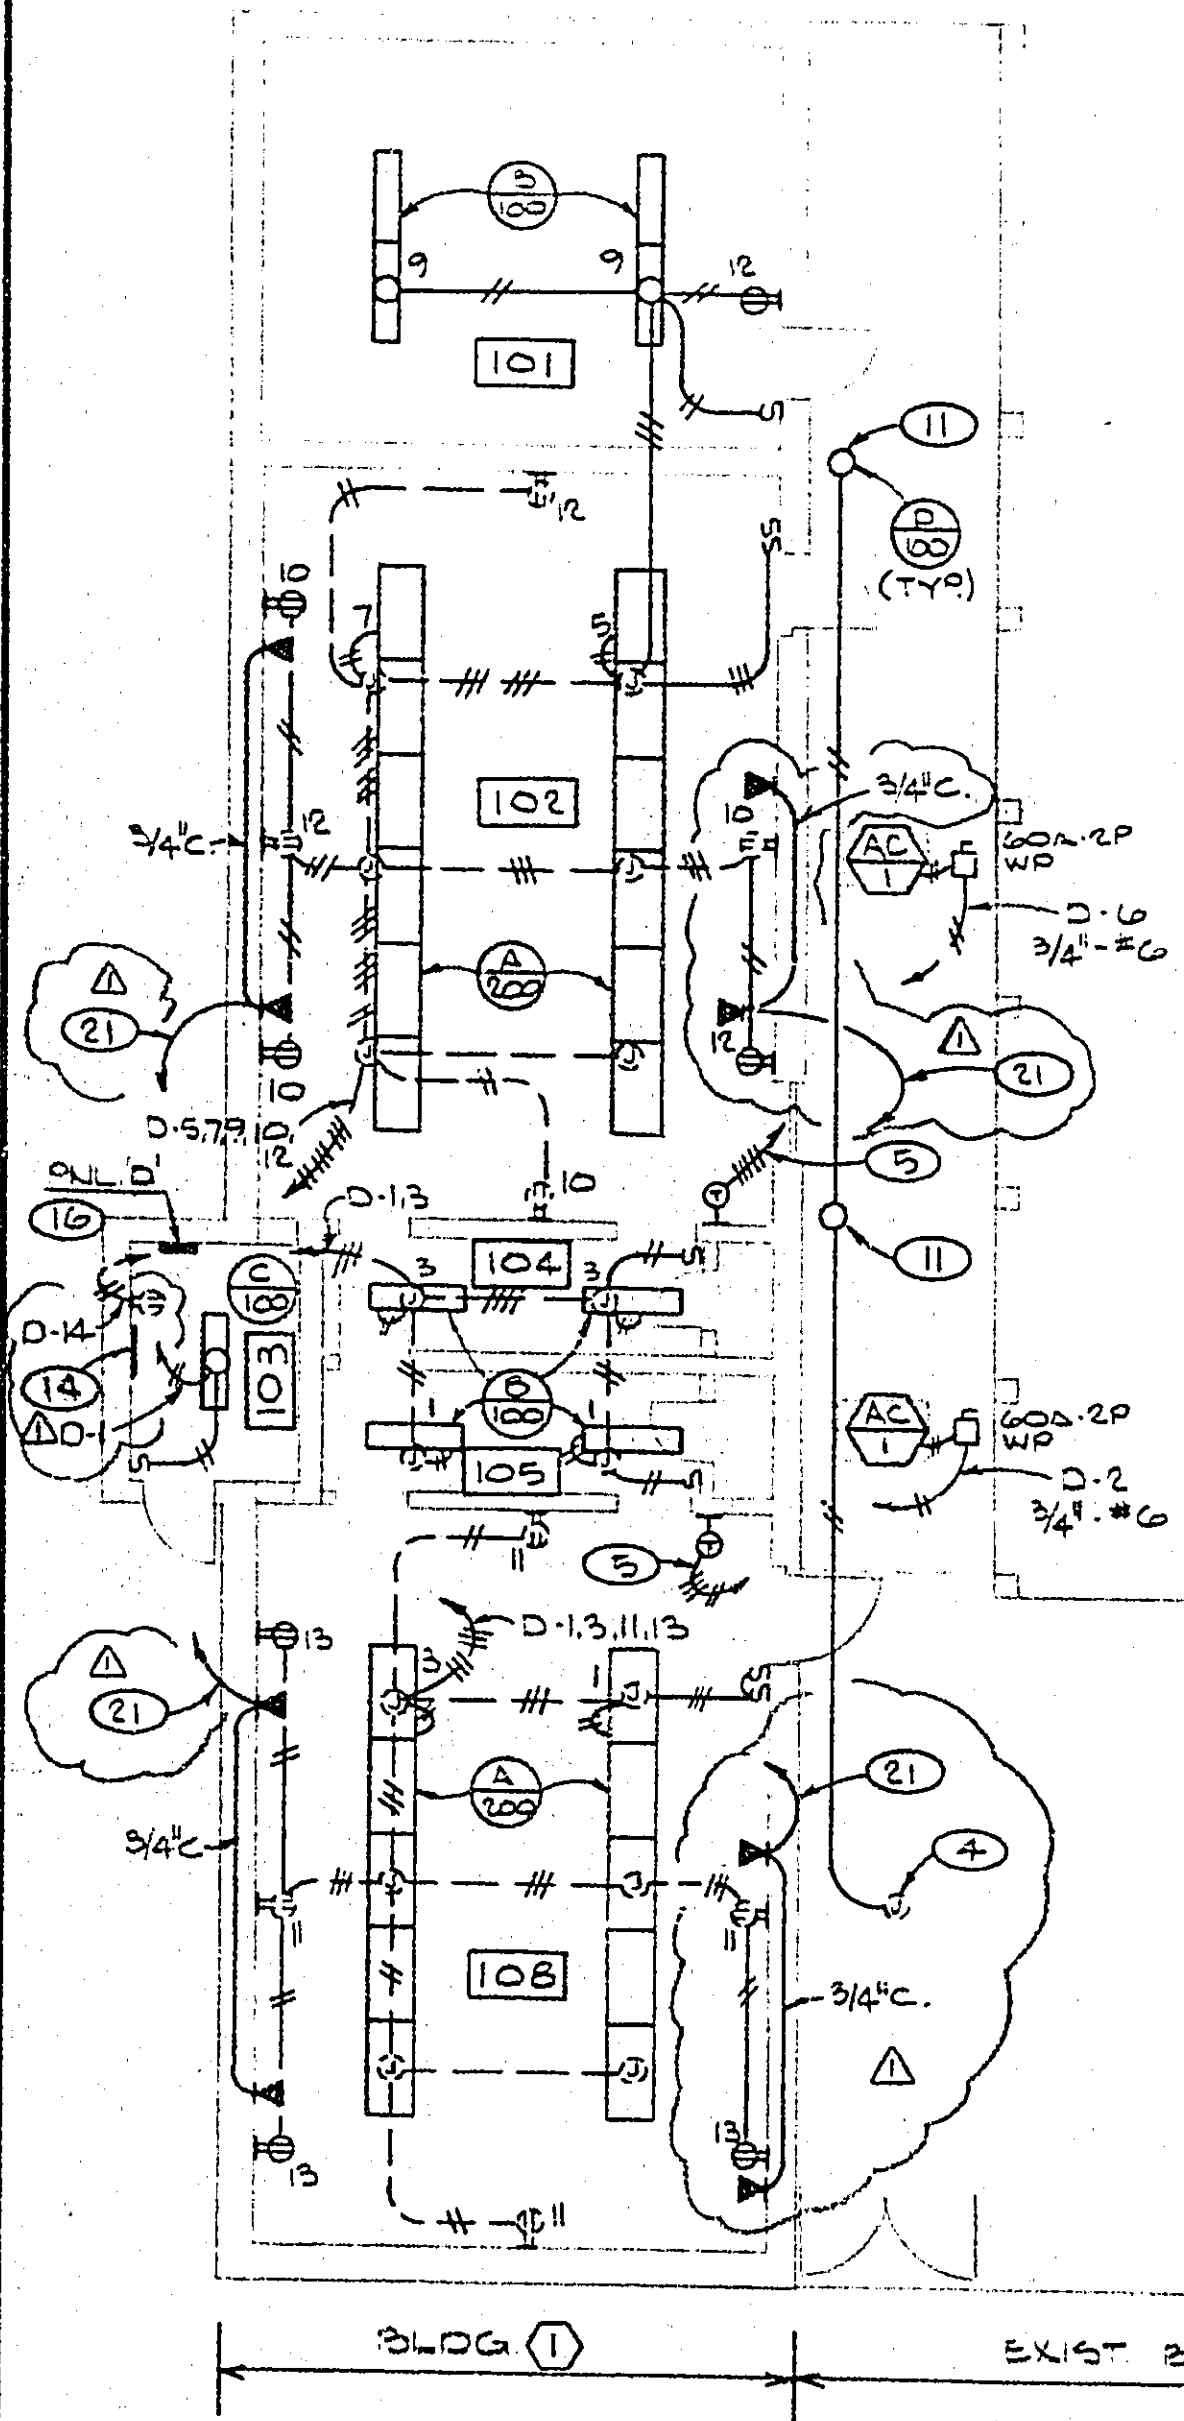

ALL IDEAS, DESIGN ARRANGEMENTS AND PLANS INDICATED OR NOTED HEREON ARE THE PROPERTY OF WALTER F. ZICK & HARRIS P. SHARP ARCHITECTS - ENGINEERS, INC. AND ARE NOT TO BE REPRODUCED OR USED IN ANY MANNER WITHOUT THE WRITTEN PERMISSION OF WALTER F. ZICK & HARRIS P. SHARP ARCHITECTS - ENGINEERS, INC.

FROM THE OFFICE OF:
WALTER F. ZICK & HARRIS P. SHARP
 ARCHITECTS - ENGINEERS, INC.
 LAS VEGAS, NEVADA

PANEL D			
120/240V 1Ø 3 WIRE SERVO MOUNTED 225 AMPERE MAIN LUGS OUT 225 AMPERE BUS			
NO	VOLTS	AMPERES	DESCRIPTION
1	120	200	OFFICES
2	120	200	OFFICES
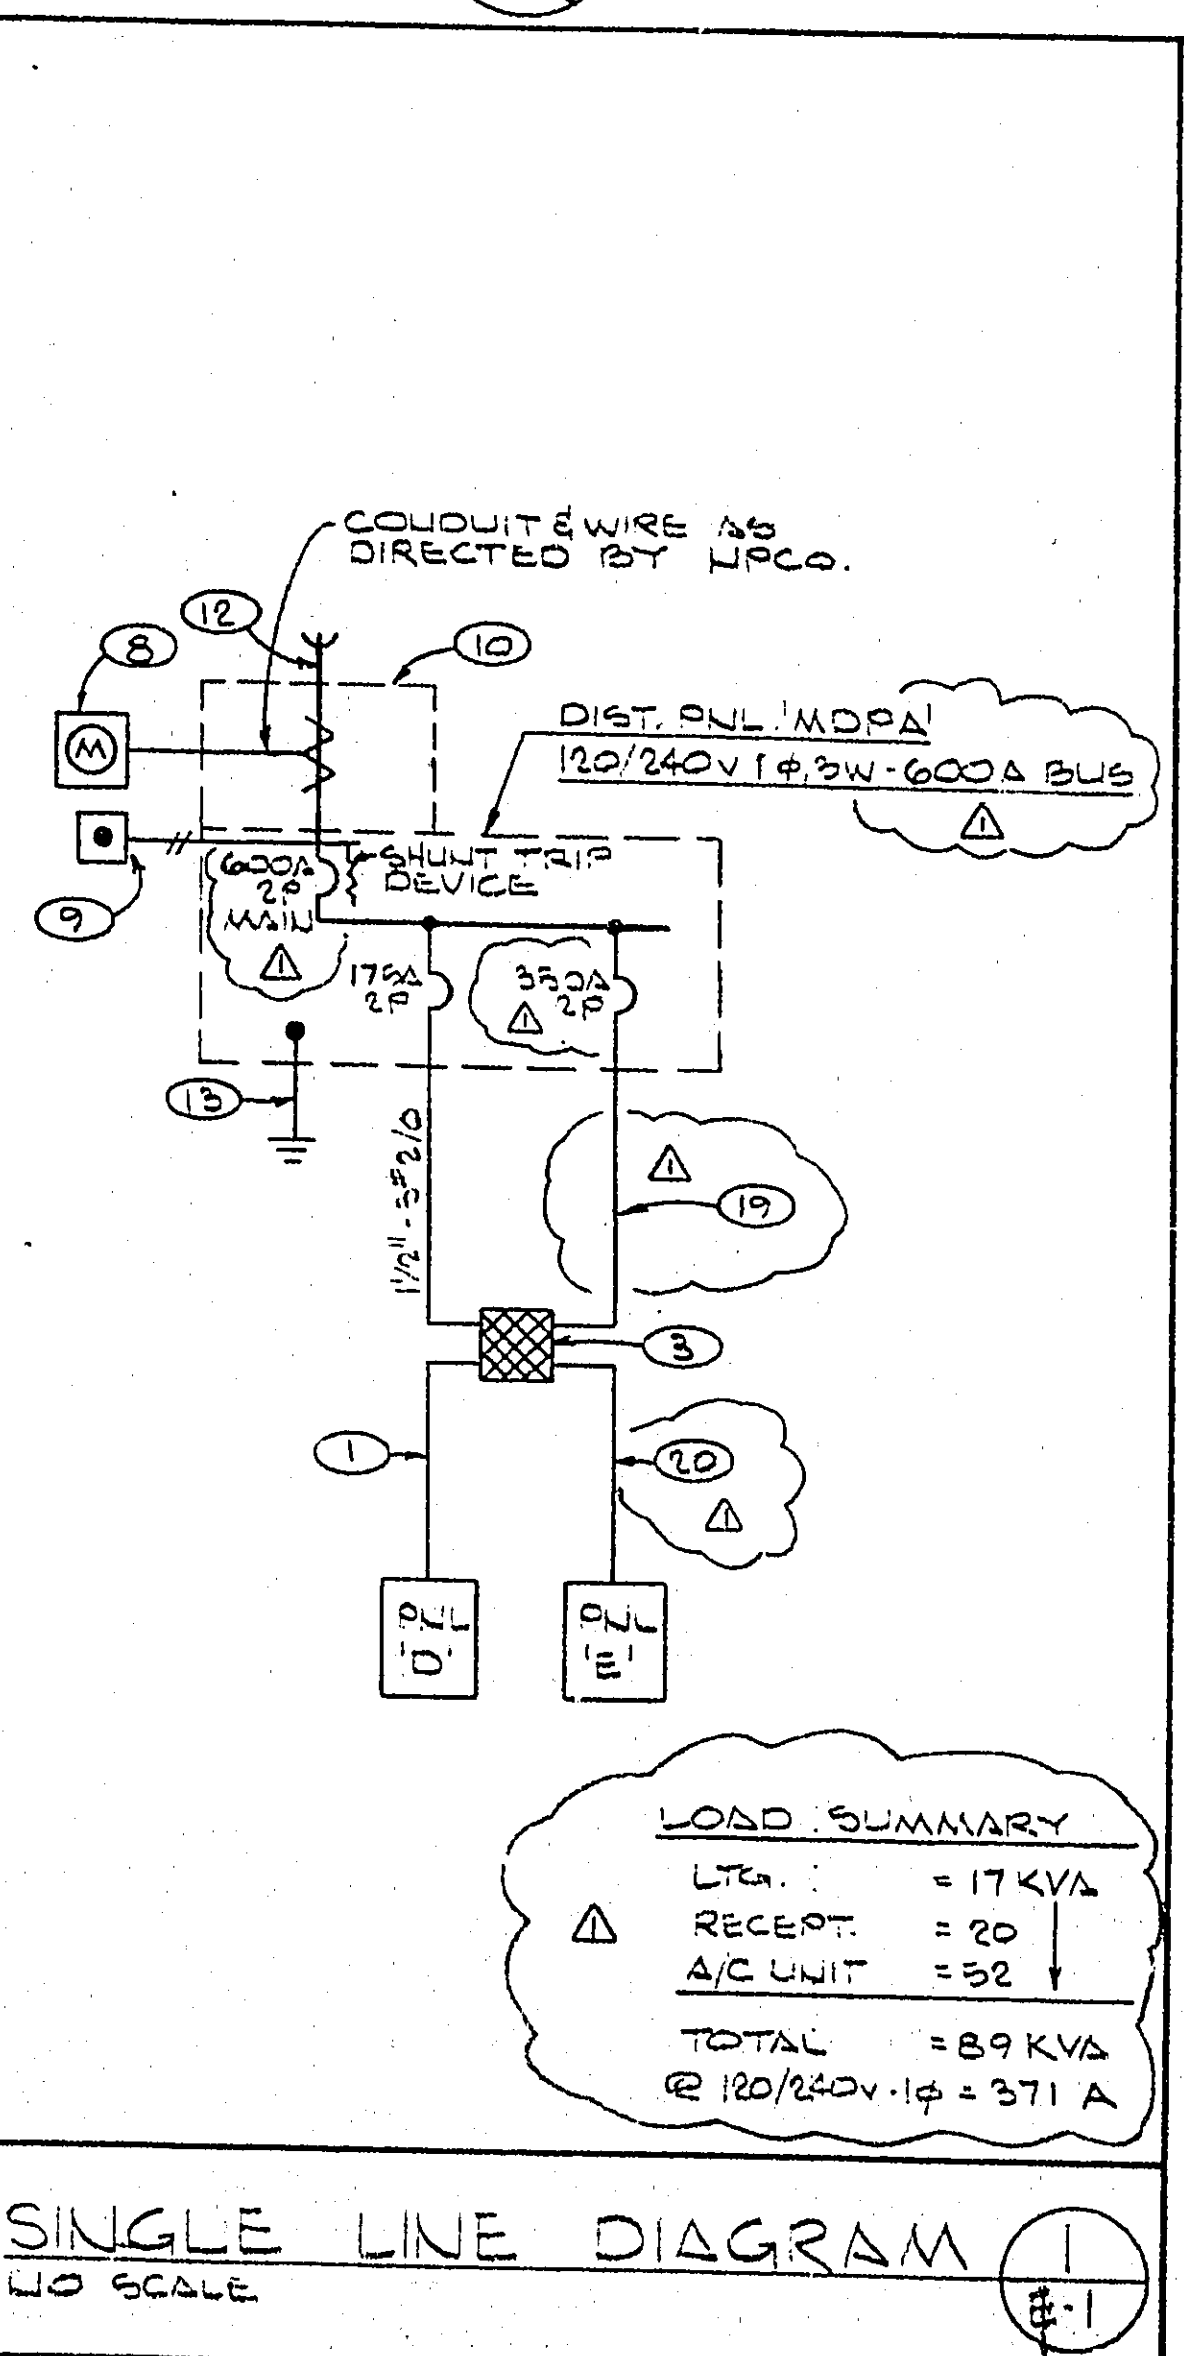

- ### NOTES
- 2"Ø IN EXIST 1/2" CONDUIT
 - FOR KITCHEN PART PLAN SEE (A) (E-1)
 - 2"Ø IN EXIST PULLBOX AT CEILING
 - CONDUIT TO EXIST CIRCUIT CONTROLLED BY LIGHTING CONTROL CENTER
 - TO AC UNIT SEE SHEET M-1 FOR EXACT LOCATION
 - VERIFY EXACT LOCATION OF EXIST EQUIP PRIOR TO BID
 - REPLACE EXIST 10-20 CIRCUIT BREAKER W/NEW 40A-20 CIRCUIT BREAKER
 - REMOVE METER ENCLOSURE LOCATE ADJACENT TO EXIST
 - REMOVE SHUNT TRIP PUSH BUTTON STATION LOCATE ADJACENT TO EXIST
 - METER & CT PREVIOUSLY PER NRCO STOPS
 - MOUNT AS DIRECTED BY ARCH. IN FIELD
 - PROVIDE 2"Ø 1Ø GROUND WIRE TO CODE APPROVED GROUND
 - 48"Ø 1/2" TEL BXBD. PROVIDE 2"Ø TO EXIST TEL BXBD. FOR LOCATION SEE (A) (E-1)
 - INSTALL CONNECT THAT PURCHASED BY OTHERS
 - REMOVE EXIST SINGLE POLE SWITCHES. EXTEND CONDUIT TO NEW PULL AS REQ'D.
 - CONTRACTOR SHALL VERIFY CEILING TYPE & MOUNTING OF ALL FIXTURES W/ARCH. DWGS & SPECIFICATIONS PRIOR TO RECEIVING ORDER FOR FIXTURES
 - CAT. NUMBERS INDICATE BASIC FIXTURE REQUIRED FOR THIS PROJECT. VERIFY W/ MANUFACTURER TO INCLUDE ALL ACCESSORIES & MODIFICATIONS REQ'D. AND/OR INDICATED FOR THIS PROJECT.
 - 1/2" Ø TO NEAREST TELEPHONE BXBD.

- ### GENERAL NOTES
- REPLACE ALL EXIST 3-WAY SWITCHES W/TWO (2) SINGLE POLE SWITCHES IN NEW FURRED WALL IN ALL EXIST BOXES.
 - PROVIDE 2"Ø EXTENSION BOXES THROUGH NEW FURRED WALL & NEW PLATE FOR ALL EXIST RECEPT.
 - ALL EXIST WIRE SHALL BE REMOVED & NEW WIRE SHALL BE PROVIDED IN EXIST CONDUIT. SIZES AS SHOWN.
 - VERIFY LOCATION OF EXIST RECEPTS, J-BOXES, ETC. PRIOR TO BID.
 - ALL CONDUITS, J-BOXES, RECEPTS ETC. SHOWN DASHED ARE EXIST TO REMAIN. PROVIDE BLANK COVER PLATE ON ALL EXIST J-BOXES.
 - ALL WIRES IN EXIST CONDUIT ARE SHOWN. WHERE NO WIRES ARE SHOWN EMPTY CONDUIT SHALL REMAIN.
 - PROVIDE 1/2" FLEX W/ØØØØØMM THN(CU) FROM EXIST J-BOXES TO NEW LIGHTING FIXTURES AS SHOWN ON DRAWING.
 - REMOVE ALL EXIST LIGHTING FIXTURES IN OFFICES & HEATER ROOMS

LEGEND

NO. DATE

REVISIONS

1. 12/15/77

2. 12/15/77

SHEET TITLE: ELECTRICAL FLOOR PLAN, PHASE 2, WEST SIDE GRADE SCHOOL RENOVATION

JOB NUMBER: 377-1

DATE: 12-15-77

DRAWN BY: GRS

CHECKED BY: GRS

SHEET NUMBER: 11

OF: 11

VERIFIED ALL DIMENSIONS AND CONDITIONS AT THE SITE

WALTER F. ZICK & HARRIS P. SHARP ARCHITECTS - ENGINEERS, INC. LAS VEGAS, NEVADA