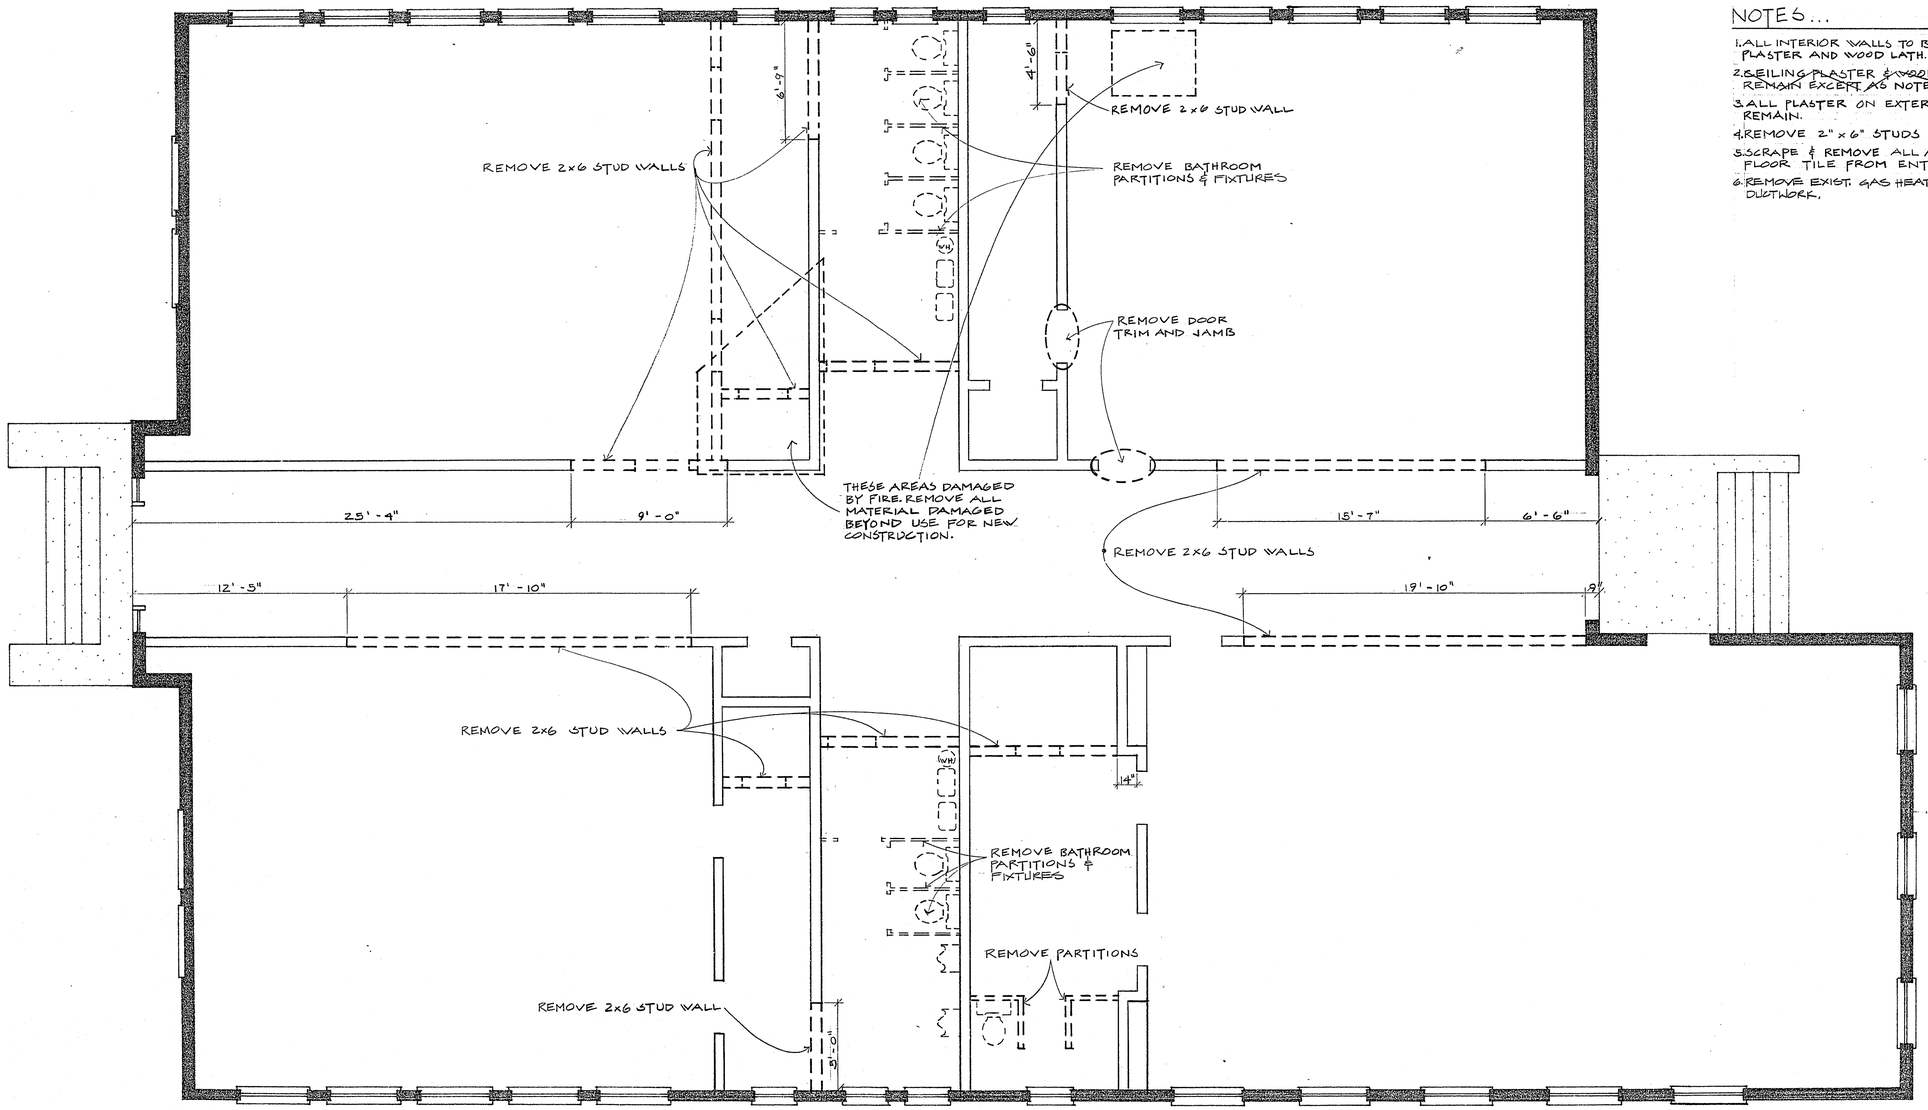

DEMOLITION FLOOR PLAN

SCALE: 1/4" = 1'-0"

NOTES...

1. ALL INTERIOR WALLS TO BE STRIPPED OF PLASTER AND WOOD LATH.
2. CEILING PLASTER & WOOD LATH TO REMAIN EXCEPT AS NOTED ON SHEET 5.
3. ALL PLASTER ON EXTERIOR WALLS TO REMAIN.
4. REMOVE 2" x 6" STUDS AS NOTED.
5. SCRAPE & REMOVE ALL ASBESTOS FLOOR TILE FROM ENTIRE BLDG.
6. REMOVE EXIST. GAS HEATERS, PIPING & DUCTWORK.

AS BUILT

1-18-82

City of Las Vegas, Nevada
Office of Architectural Services and Project Control
Don J. Seyler A.I.P. Deputy City Manager

WEST SIDE SCHOOL RENOVATION
DEMOLITION FLOOR PLAN

Design By: R. RUELGE Date: 8/82 Reviewed By: Date:
Drawn By: F. TEZUPIANO Date: 8/82 Revised By: Date:
Division: TECHNICAL SERVICES Scale: 1/4" = 1'-0"

Phase 3
Drawing no. 513-53
W.O. no. WH 1532
of 57

7-28