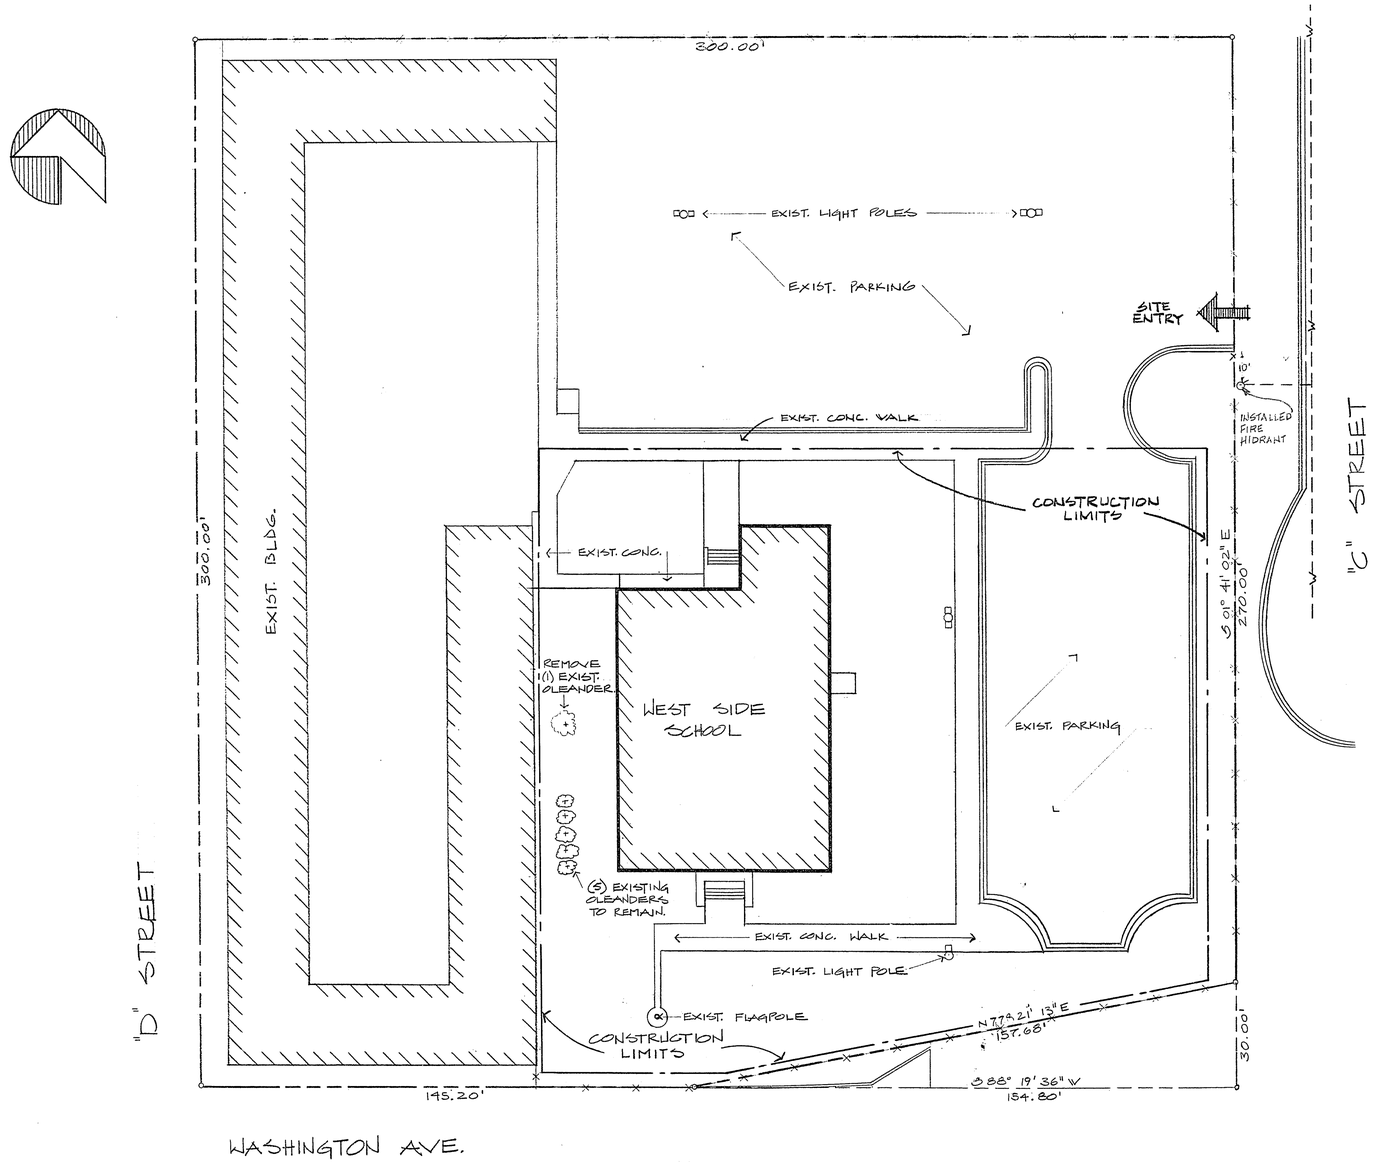

SITE PLAN

SCALE: 1" = 20'

NOTES

THE CONTRACTOR SHALL REMOVE EXCESS, LEVEL, AND BACKFILL TO PROVIDE A UNIFORMLY LEVEL DIRT AREA AROUND THE BUILDING AND ALL DIRT AREAS WITHIN THE LIMITS OF CONSTRUCTION. THE CONTRACTOR SHALL INSURE ALL AREAS WITHIN THE LIMITS OF CONSTRUCTION DRAIN AWAY FROM THE BUILDING AND OFF THE LOT WITHOUT PUDDLES OR DEPRESSIONS. ALL DIRT AREAS (EXCEPT UNDER THE BUILDING) SHALL HAVE A RAKED FINISH WITHOUT ORGANIC MATERIAL, ROCKS, CLUMPS OF DIRT LARGER THAN 2" IN ANY DIRECTION, OR DEBRIS.

[illegible] UTILITIES ARE LOCATED ON THE PLANS [illegible] THE LOCATION SHOWN ON THE PLANS.

CONTRACT DRAWING
NOV 30 1982

AS BUILT

11-18-82

City of Las Vegas, Nevada
Office of Architectural Services and Project Control
Don J. Seyler A.I.P. Deputy City Manager

WEST SIDE SCHOOL RENOVATION
SITE PLAN

Design By: J.J. & R.R. | Date: 8-82 | Revised By: | Date:
Drawn By: F.T. | Date: 8-82 | Revised By: | Date:
Division: TECHNICAL SERVICES | Scale: 1" = 20.00'

Sheet: 2 | Drawing no: 513-53 | W.O. no: W.I. 1932 | of 57

7-77