


TOTAL BLDG. EXTERIOR STUCCO TO BE PATCHED AS NECESSARY W/ MATERIAL SIMILAR IN STRENGTH, COMPOSITION, & TEXTURE OF ORIGINAL. PAINT AS PER FINISH SCHEDULE.

CROSS SECTION (A)

SCALE: 1/4"=1'-0"

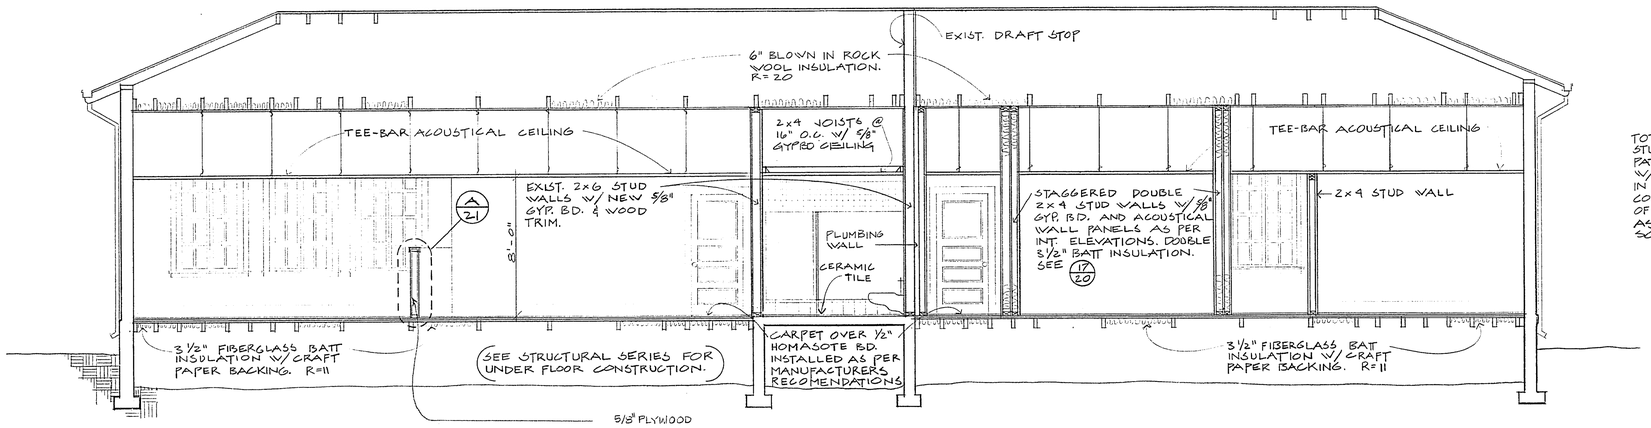


TOTAL BLDG. EXTERIOR STUCCO TO BE PATCHED AS NECESSARY W/ MATERIAL SIMILAR IN STRENGTH, COMPOSITION, & TEXTURE OF ORIGINAL. PAINT AS PER FINISH SCHEDULE.

CROSS SECTION (B)

SCALE: 1/4"=1'-0"

OFFICIAL RECORDS NOV 30 1982

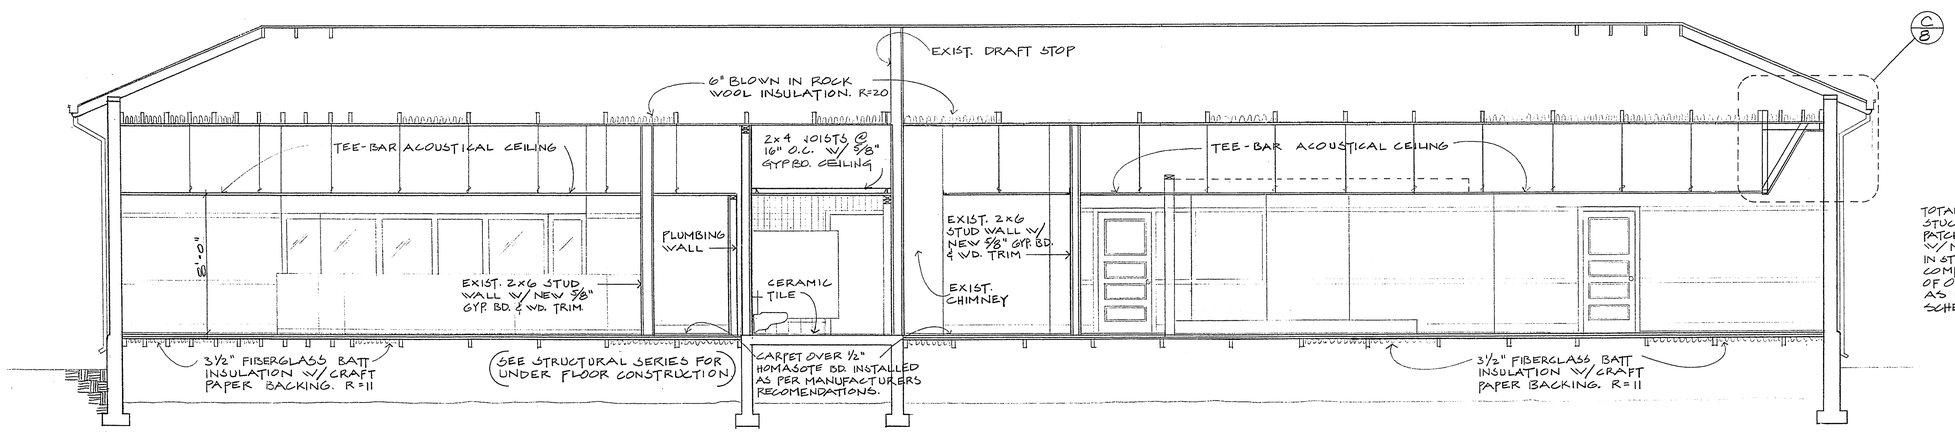CHARLES G. CIVIL No. 05077

11-18-82

AS BUILT

City of Las Vegas, Nevada
Office of Architectural Services and Project Control
Don J. Saylor A.I.P. Deputy City Manager

WEST SIDE SCHOOL RENOVATION
CROSS SECTIONS A & B

Design By: R. RUEGGE Date: 8-82 Revised By: Date:
Drawn By: EGT-JN Date: 8-82 Revised By: Date:
Division: TECHNICAL SERVICES Scale: 1/4" =1'-0"

Sheet 9 of 57
Drawing no: 513.59
W.O. no: W-1932

7-84