



130000

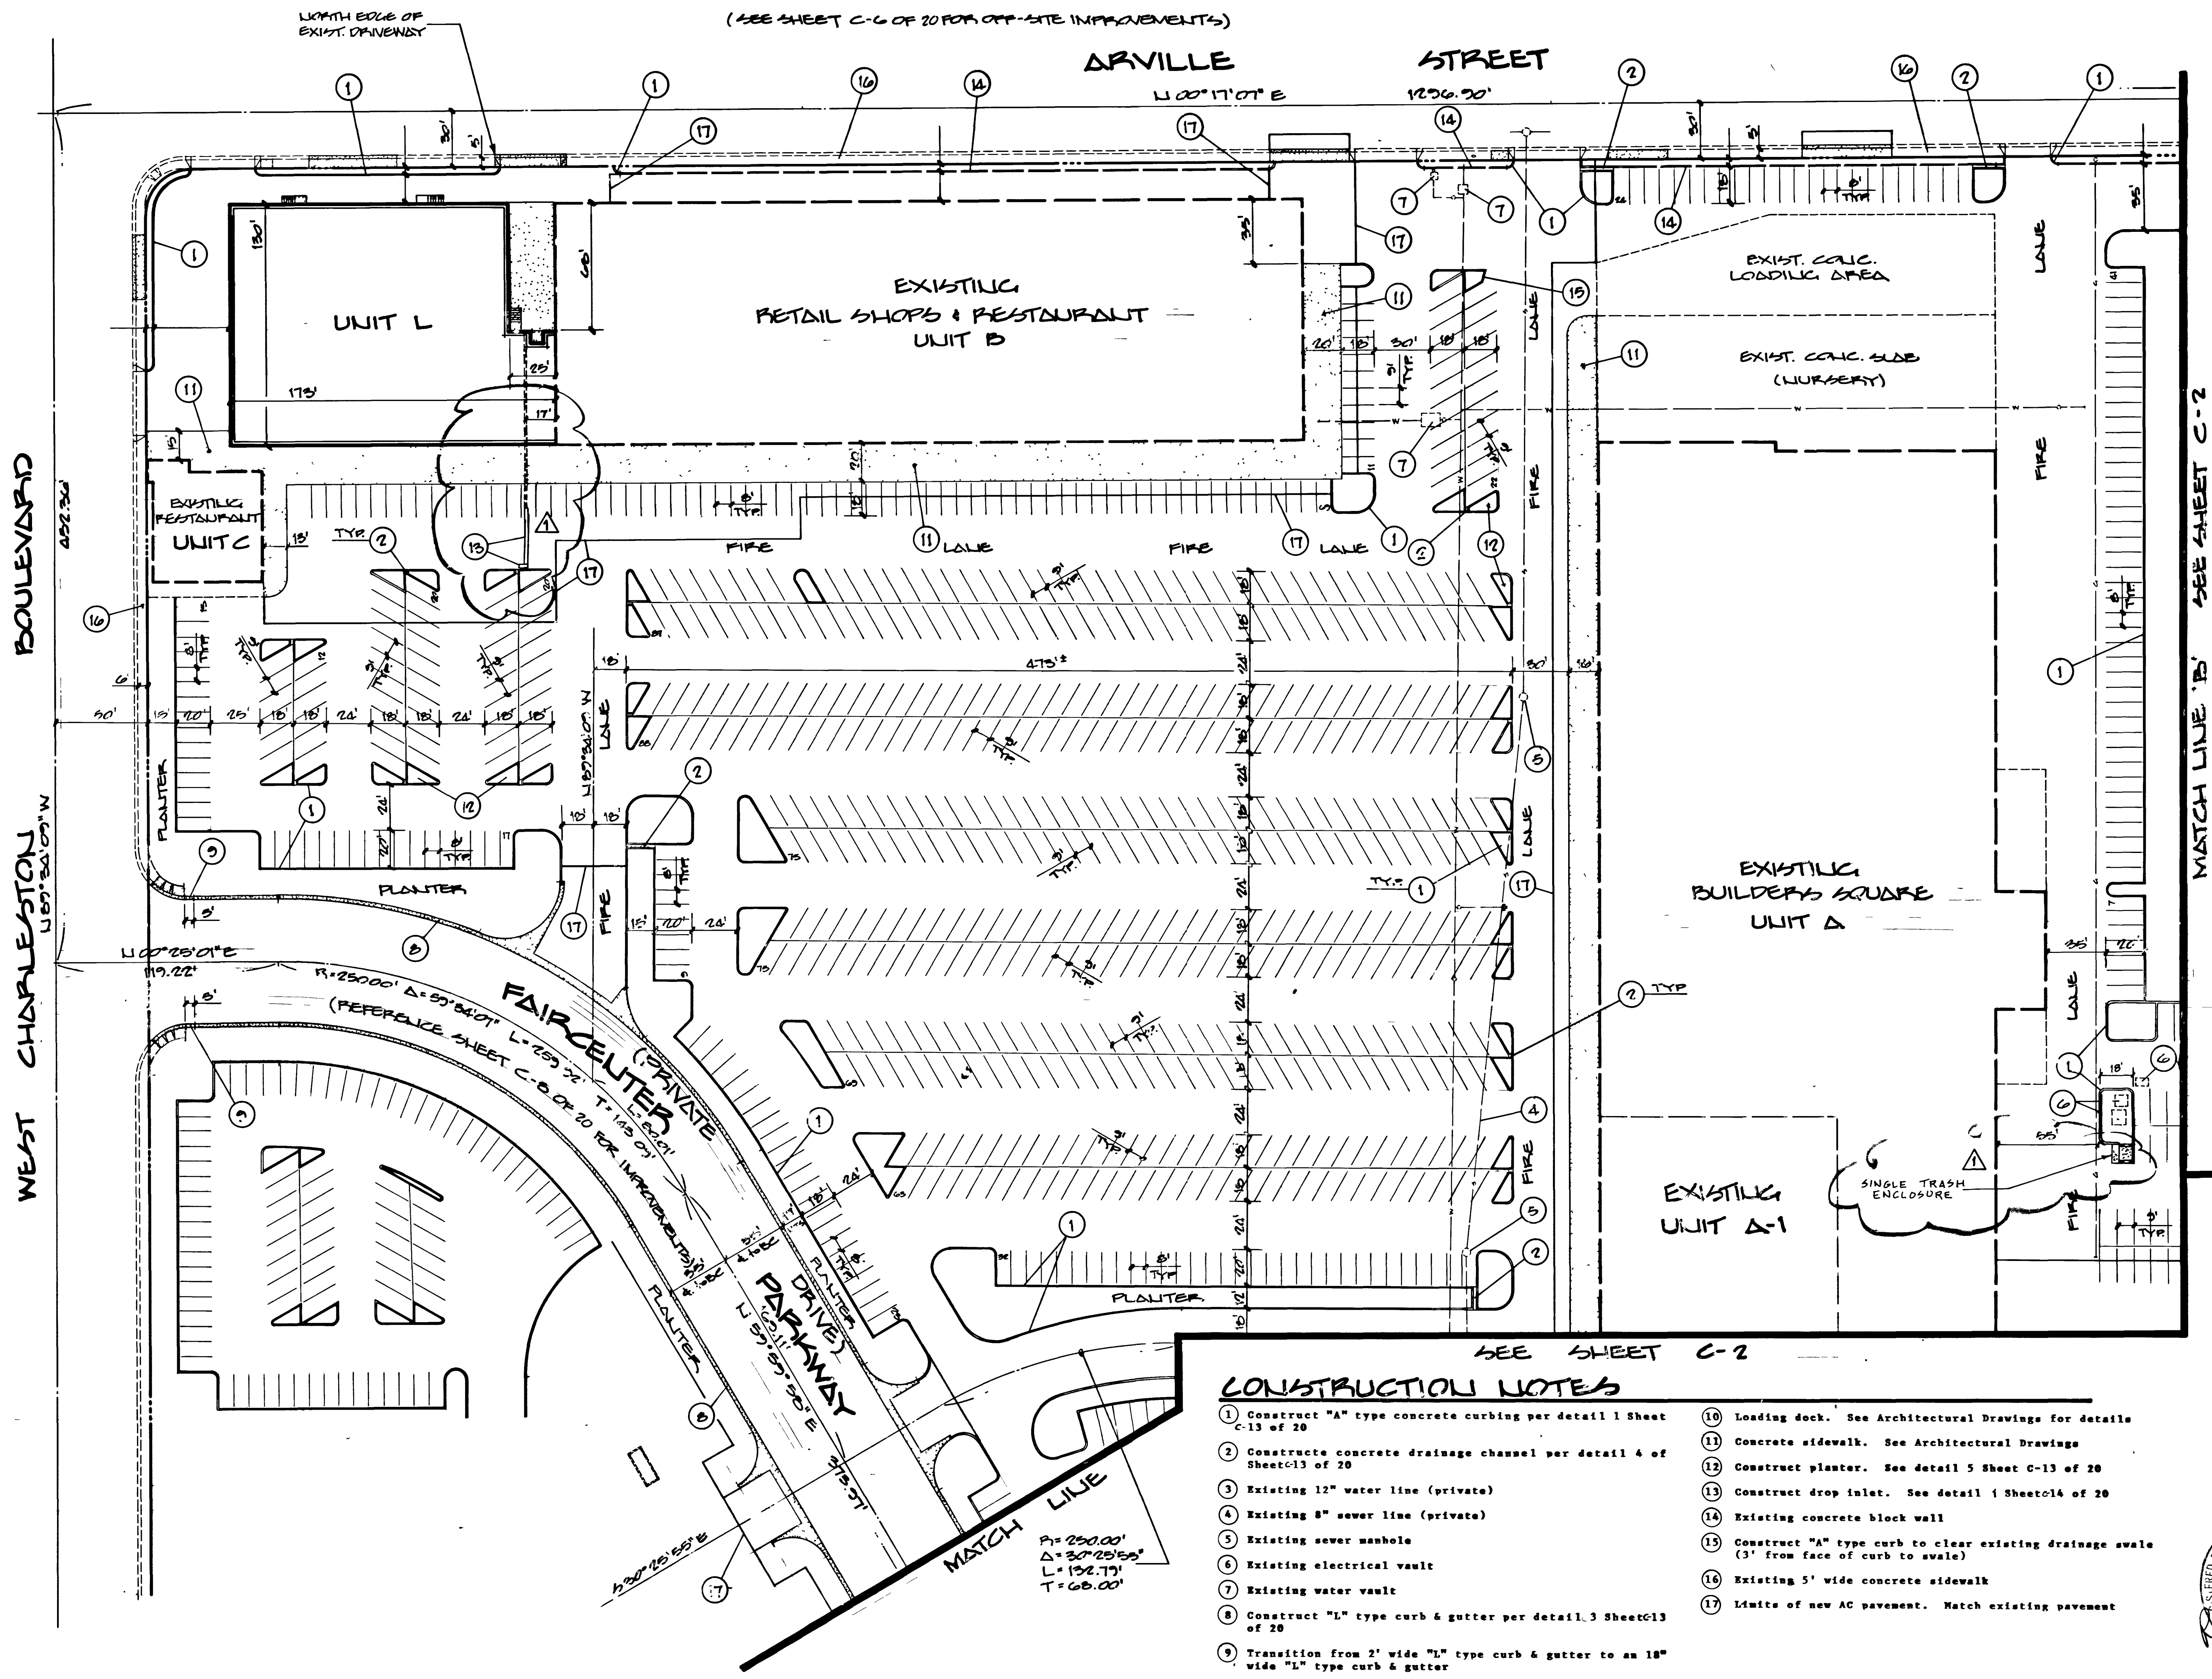

CONSTRUCTION NOTES

1. Construct "A" type concrete curbing per detail 1 Sheet C-13 of 20
2. Construct concrete drainage channel per detail 4 of Sheet C-13 of 20
3. Existing 12" water line (private)
4. Existing 8" sewer line (private)
5. Existing sewer manhole
6. Existing electrical vault
7. Existing water vault
8. Construct "L" type curb & gutter per detail 3 Sheet C-13 of 20
9. Transition from 2' wide "L" type curb & gutter to an 18" wide "L" type curb & gutter
10. Loading dock. See Architectural Drawings for details
11. Concrete sidewalk. See Architectural Drawings
12. Construct planter. See detail 5 Sheet C-13 of 20
13. Construct drop inlet. See detail 1 Sheet C-14 of 20
14. Existing concrete block wall
15. Construct "A" type curb to clear existing drainage swale (3' from face of curb to swale)
16. Existing 5' wide concrete sidewalk
17. Limits of new AC pavement. Match existing pavement

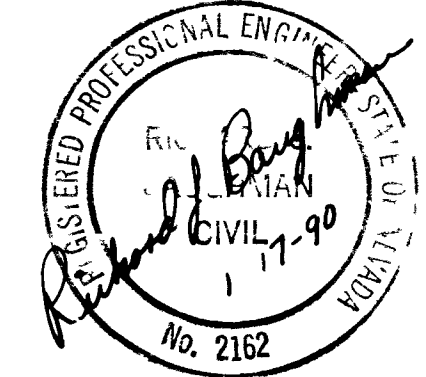

PLOT PLAN WESTLAND FAIR PHASE 1 RETRACTING, TOWING, TRAILER, SOUTH, PARKING, EXIST. U.D.B. 4th. CITY OF LAS VEGAS, NEVADA	BAUGHMAN & TURNER MINING ENGINEERS LAND SURVEYORS 3335 WEST CHARLESTON BOULEVARD LAS VEGAS, NEVADA 89102 702.870.8771	DATE: JAN. 15, 1990	DESIGN: ANNA	DRAWN: ANNA	CHECK: SCALE: 1" = 40'
		PREPARED FOR: HES DECK ASSOC.	REVISIONS: DATE NO. DESCRIPTION REV. 1 DEP. INLET LOCATION	APPROVED:	

6503

1077-4083-1

