

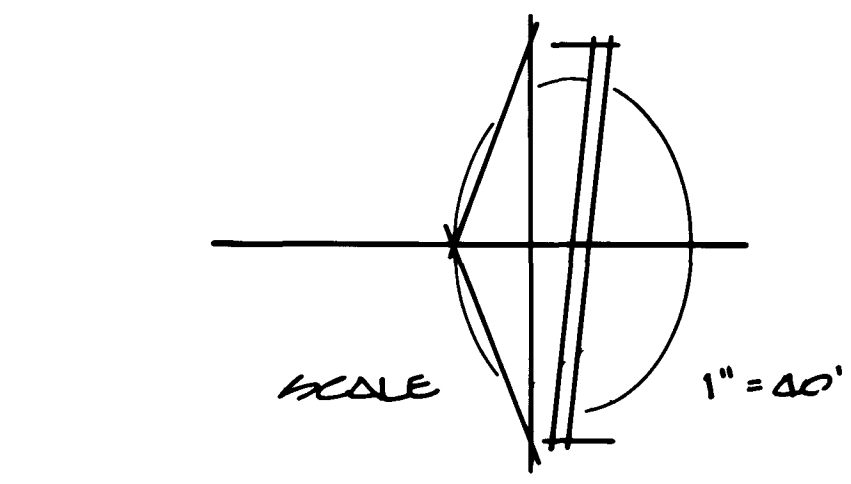


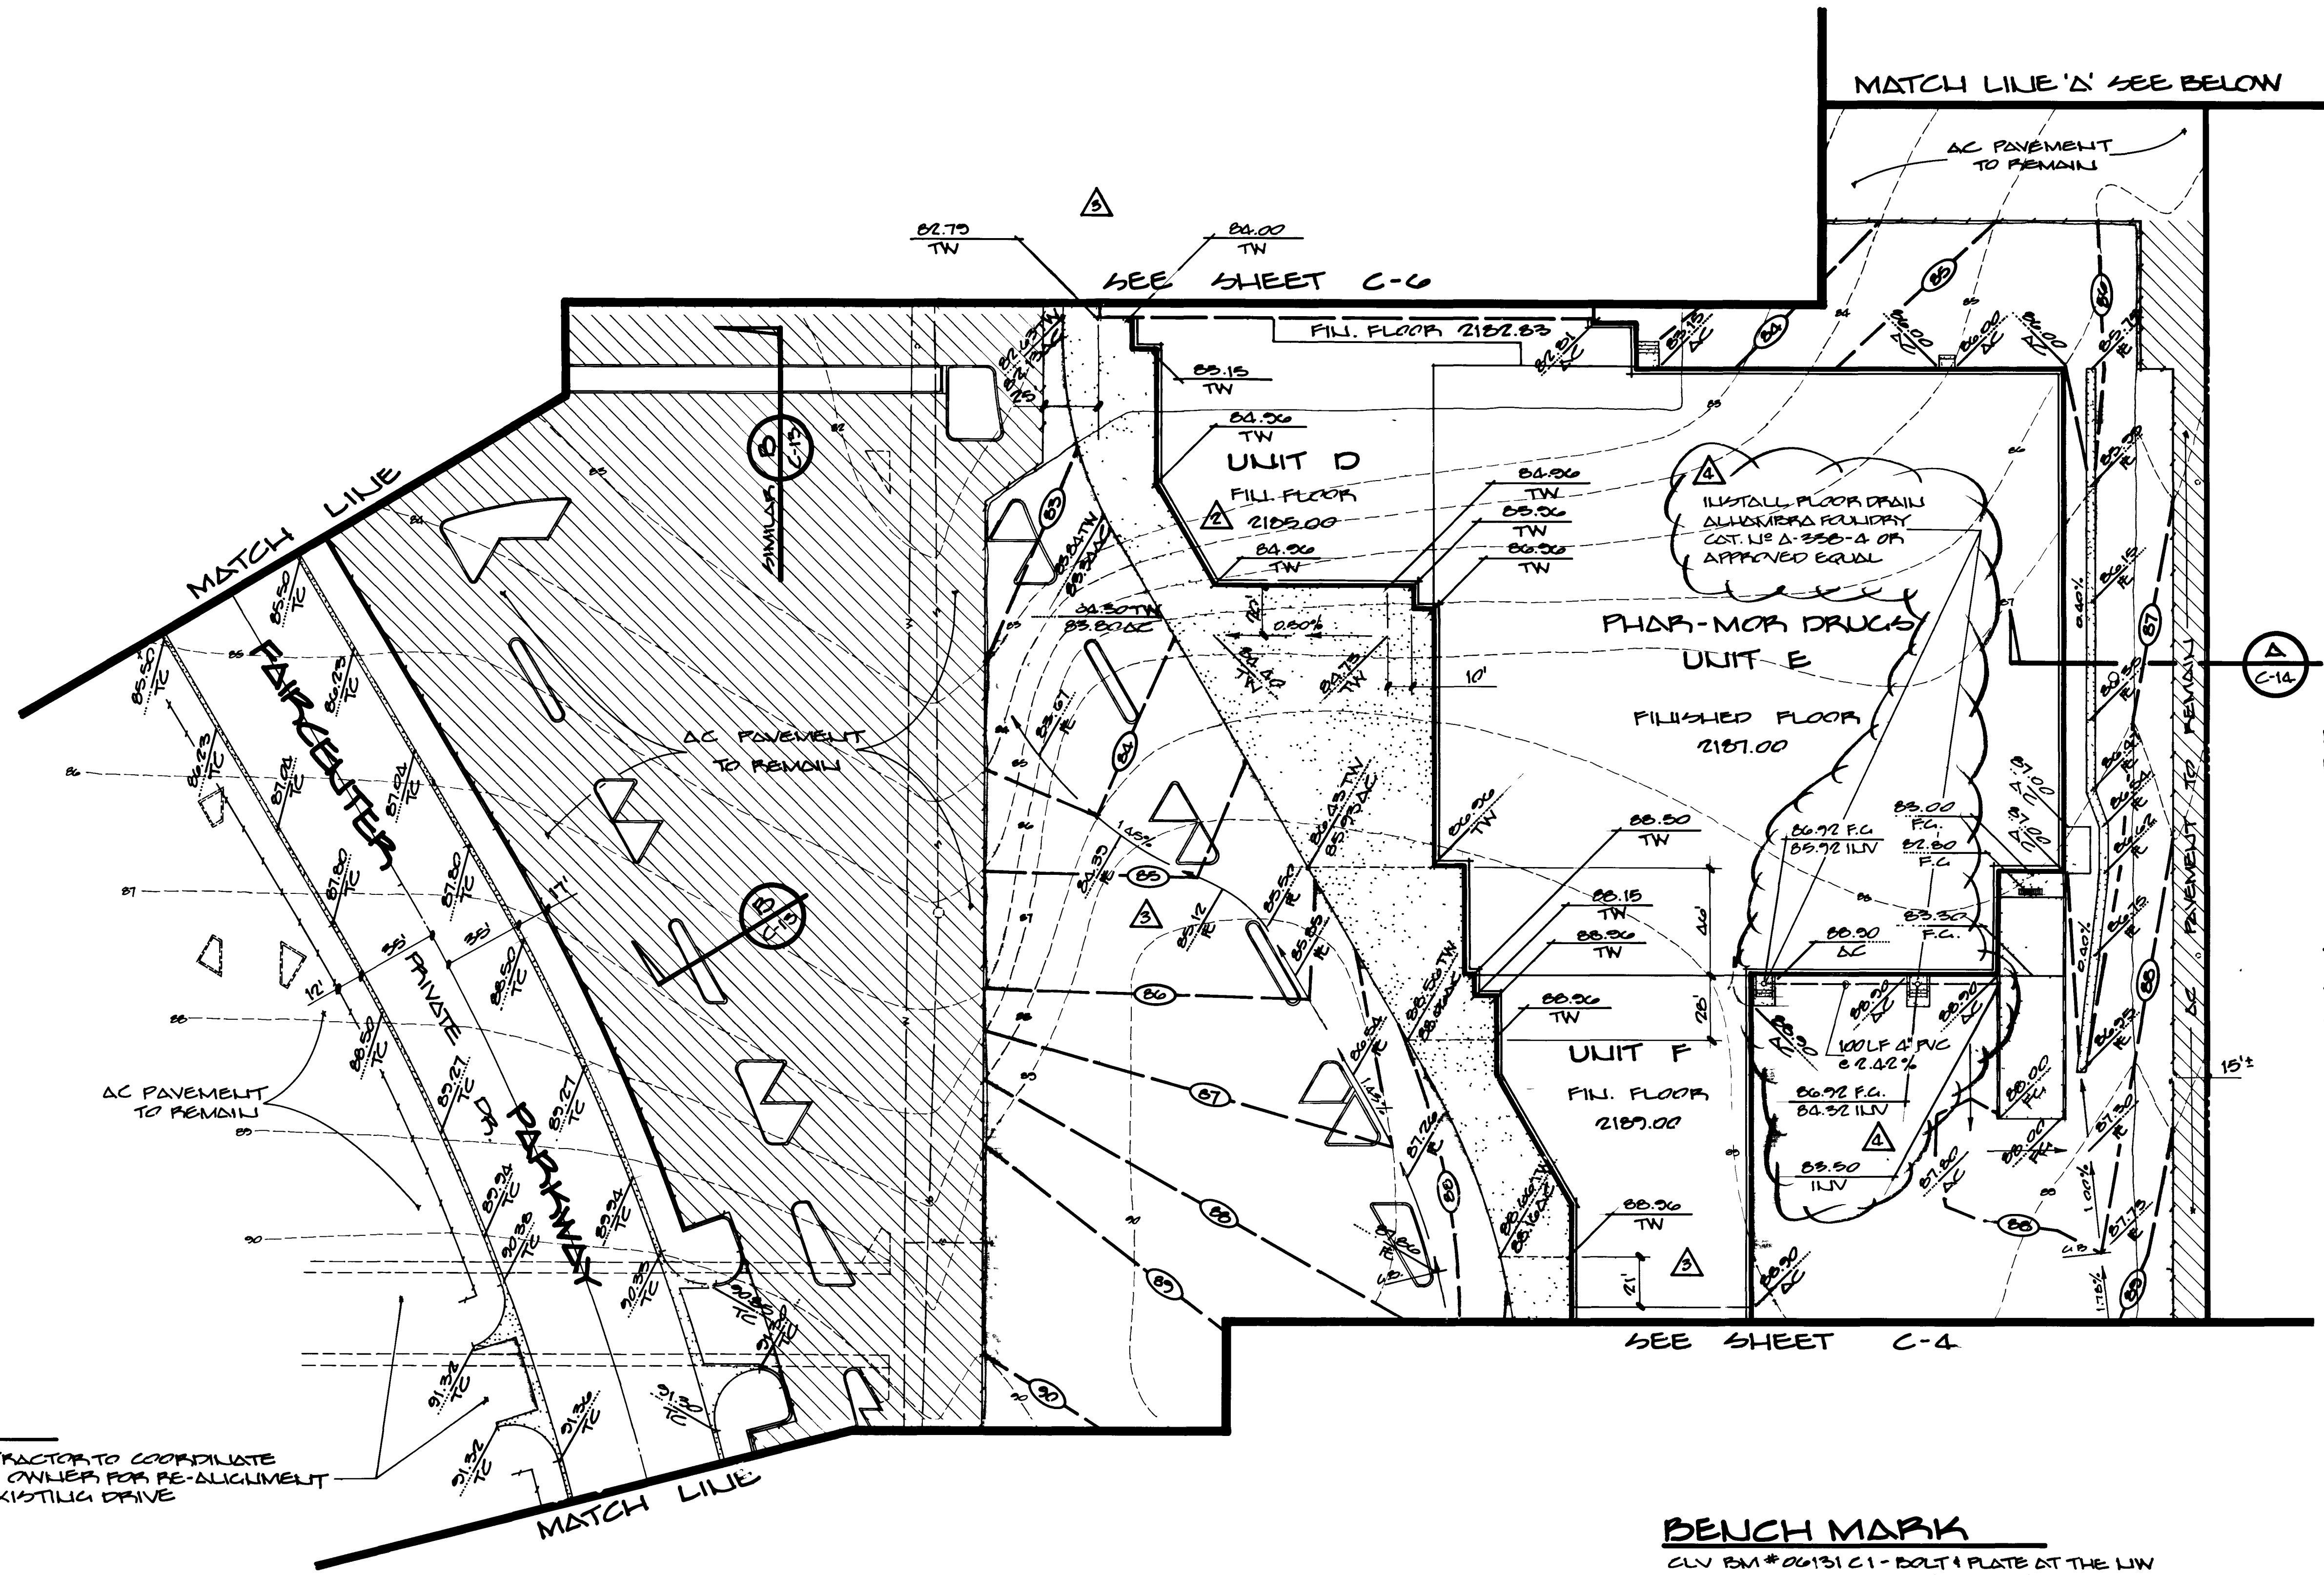

ARVILLE STREET

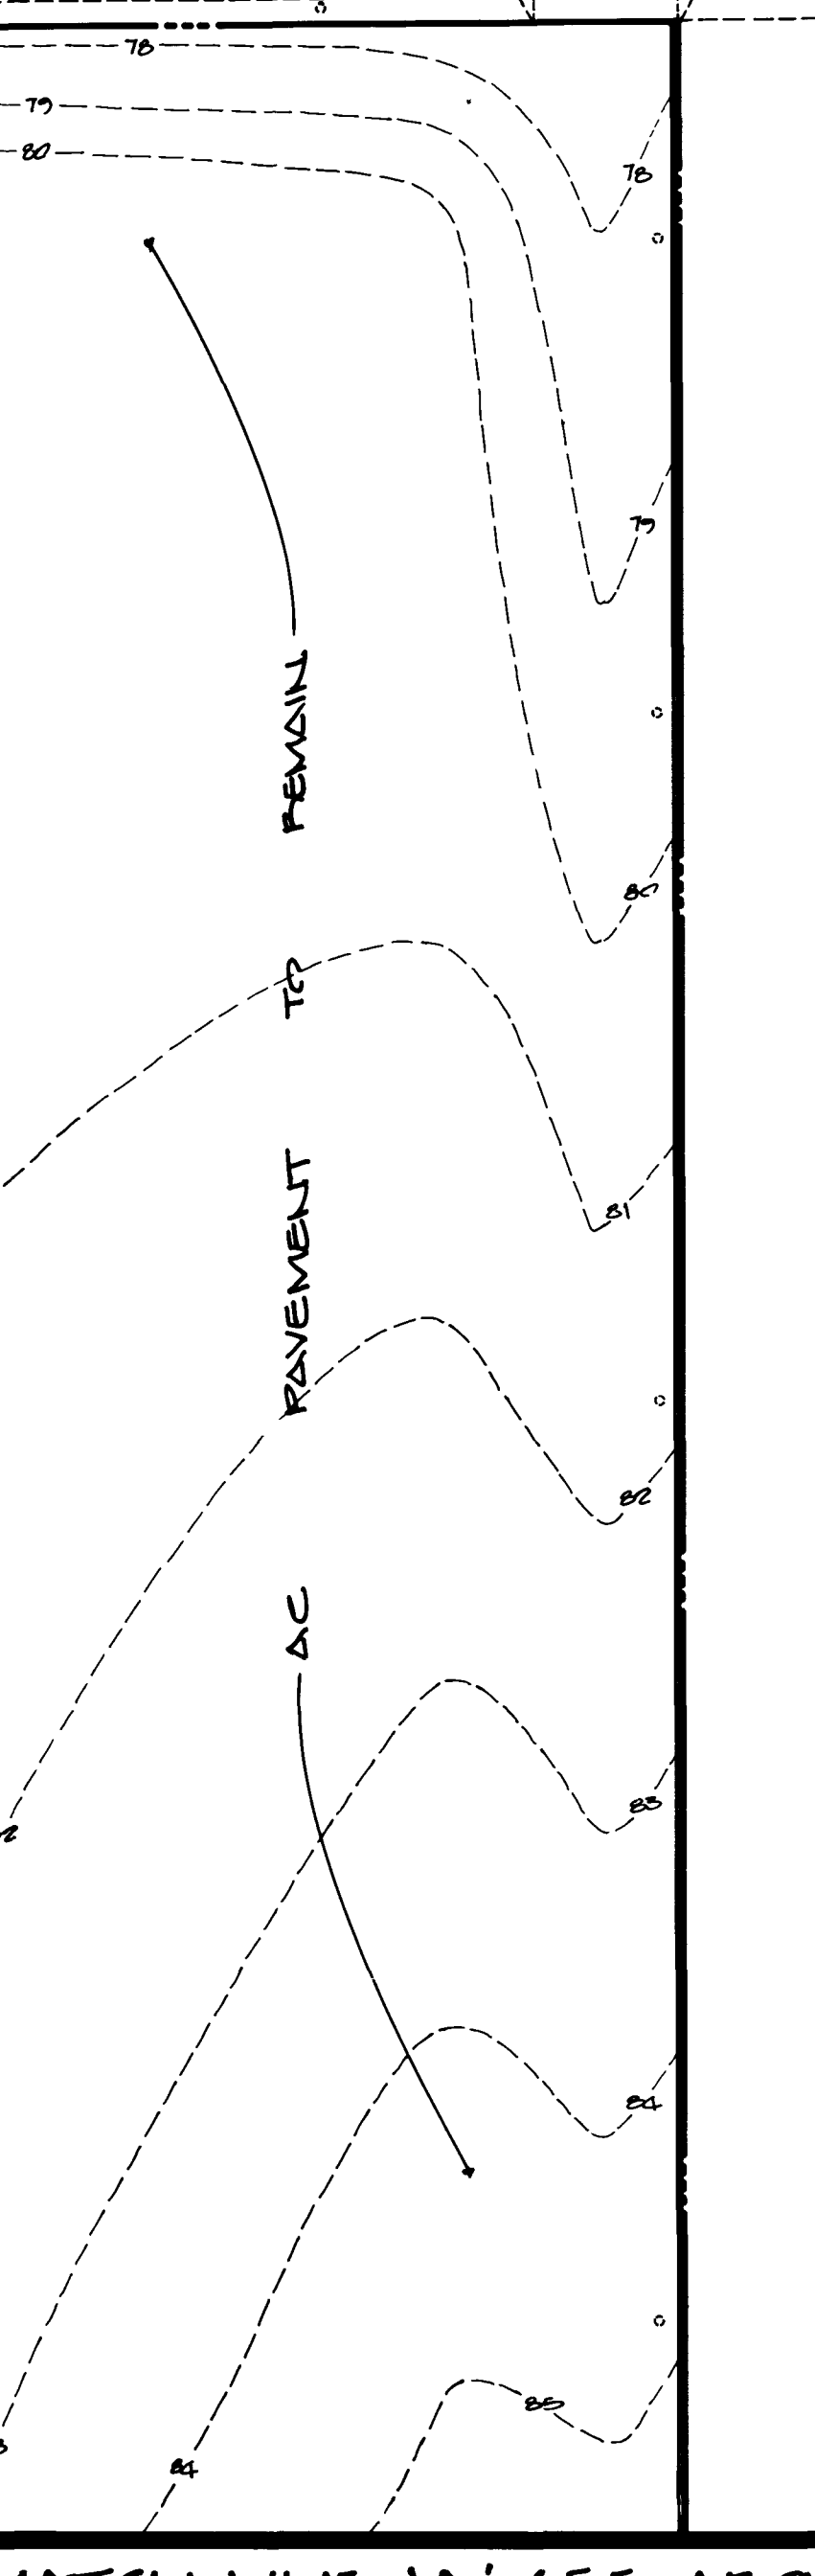


NOTE:
CONTRACTOR TO COORDINATE WITH OWNER FOR RE-ALIGNMENT OF EXISTING DRIVE

NOTE
The paving contractor shall water flow test the A.C. Pavement with the owner or authorized representative to determine any unacceptable pavement areas. Unacceptable areas shall be located and repaired by the contractor for final acceptance.

BENCH MARK
CLV RM #00131 C1 - BOLT & PLATE AT THE LNW CORNER OF CHARLESTON BLVD. & ESSEX DR. CITY OF LAS VEGAS DATUM ELEVATION 2151.41

UTILITY NOTE
The location of underground utilities shown hereon has been determined from surface evidence of their existence or from information obtained from the utility companies. The Engineer accepts no liability for the existence or non-existence of utility lines. Contractors and others using this map must confirm the location of underground lines or structures with the utility companies prior to commencing any excavation.

Call before you Dig.
1-800-227-2600
UNDERGROUND SERVICE (USA)

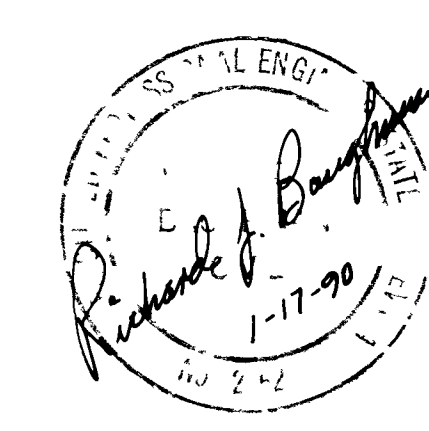

DATE	NO.	REVISIONS	APP'D
1-17-90	1	ISSUED FOR PERMITS	DES BECK ASSOC.

DATE	JAN 19, 1990	DESIGN	DAVA	SCALE	1" = 40'
DATE	JAN 19, 1990	CHECK	DAVA		

PREPARED FOR:	DES BECK ASSOC.
ENGINEER:	BAUGHMAN & TURNER
CIVIL ENGINEER:	MINING ENGINEERS
LAND SURVEYORS:	LAND SURVEYORS
OFFICE:	3325 WEST CHARLESTON BOULEVARD, LAS VEGAS, NEVADA 89103
PHONE:	702-270-8771

PROJECT:	GRADING PLAN
PROJECT NO.:	107Y-4083-1
SHEET NO.:	20 OF 31

