




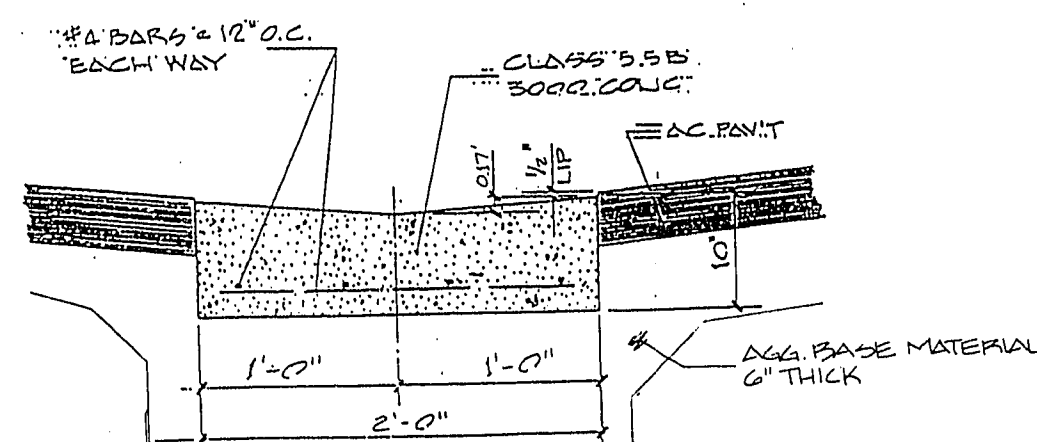

VALLEY GUTTER
NO SCALE

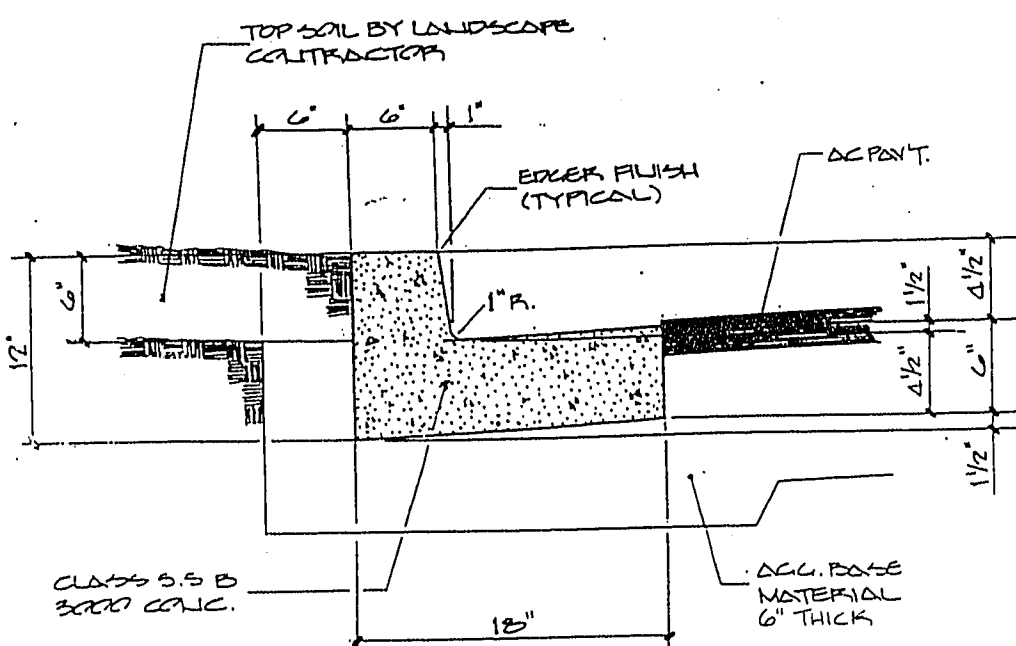

"L" TYPE CURB


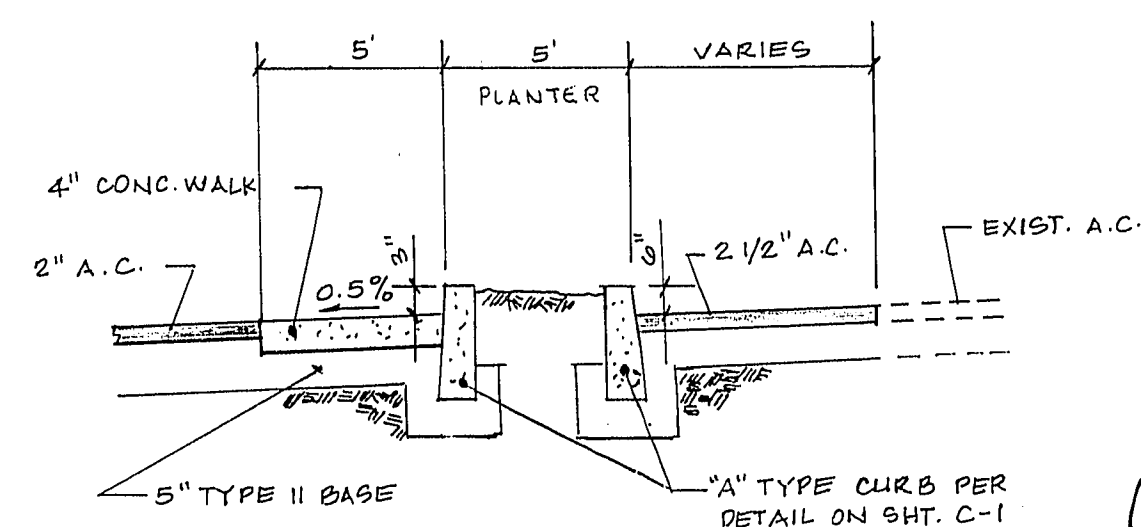


SECTION _____ (D)
NO SCALE


BENCH MARK

C.I.V. BM #06131 C1 - BOLT & PLATE AT THE
NORTHWEST CORNER OF CHARLESTON BLVD.
AND ESSEX DR.
CITY OF LAS VEGAS DATUM
ELEVATION = 2181.41


SCALE: 1" = 40'

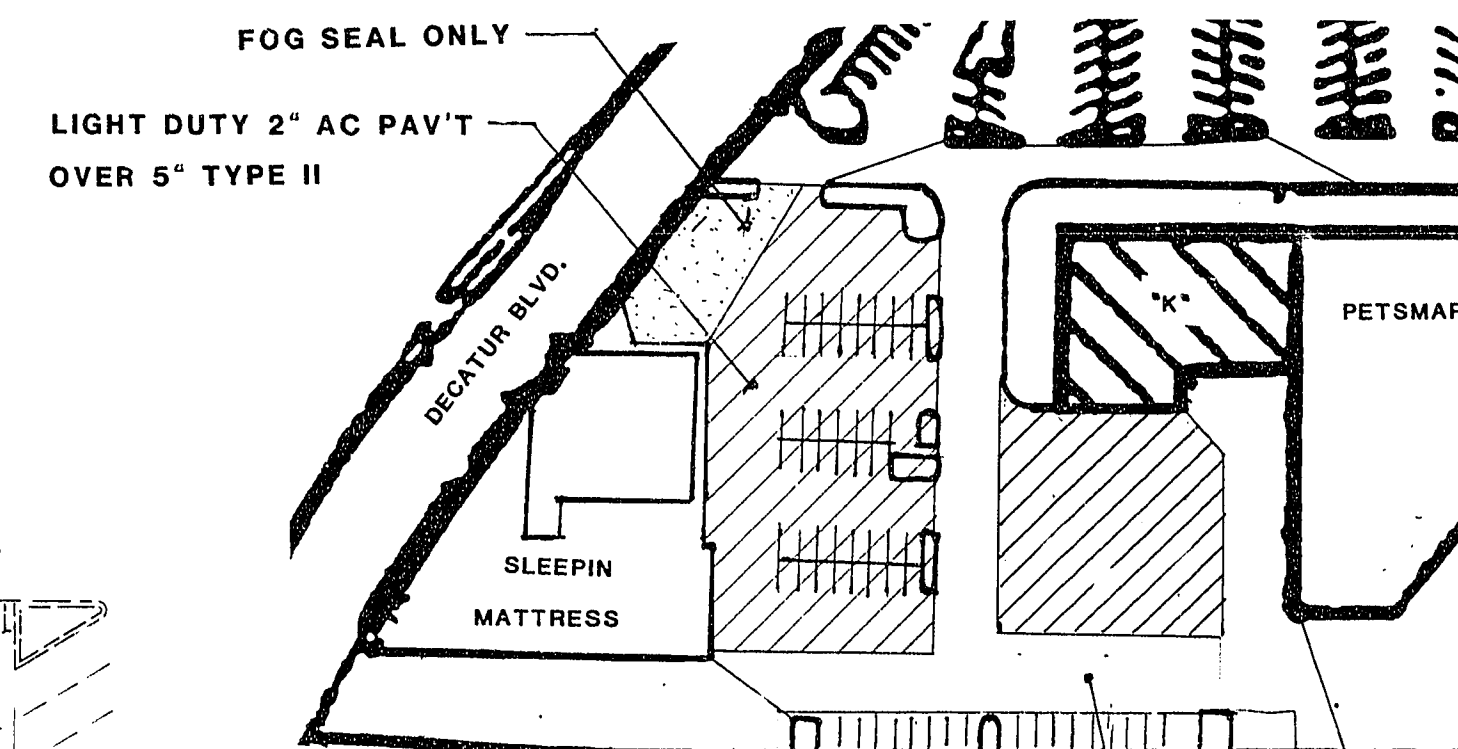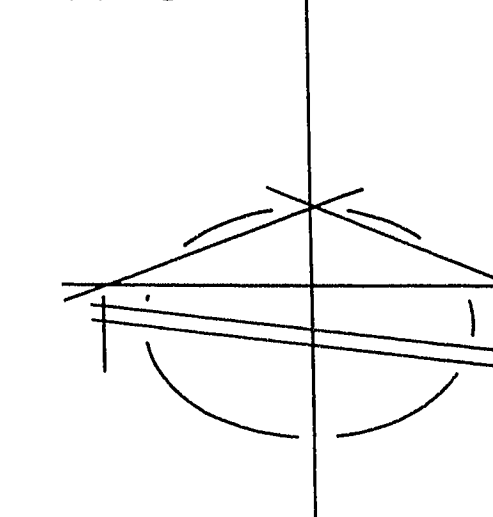

PAVING KEY
NO SCALE

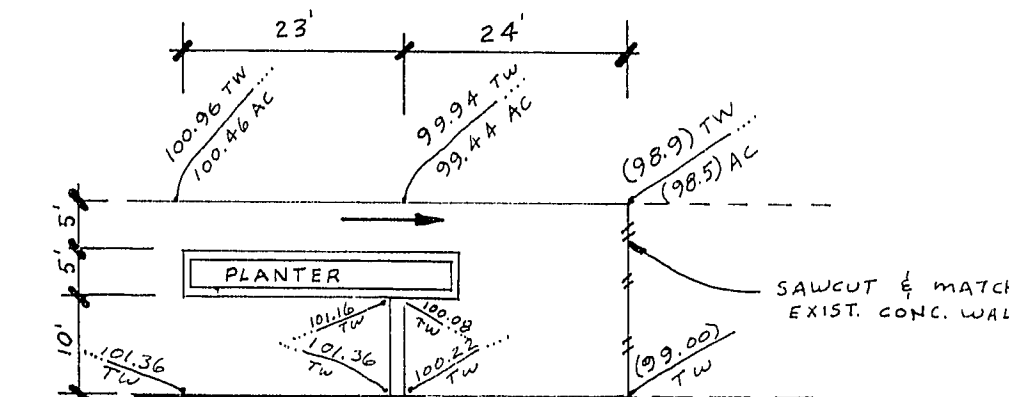

RAMP DETAIL
SCALE: 1" = 20'

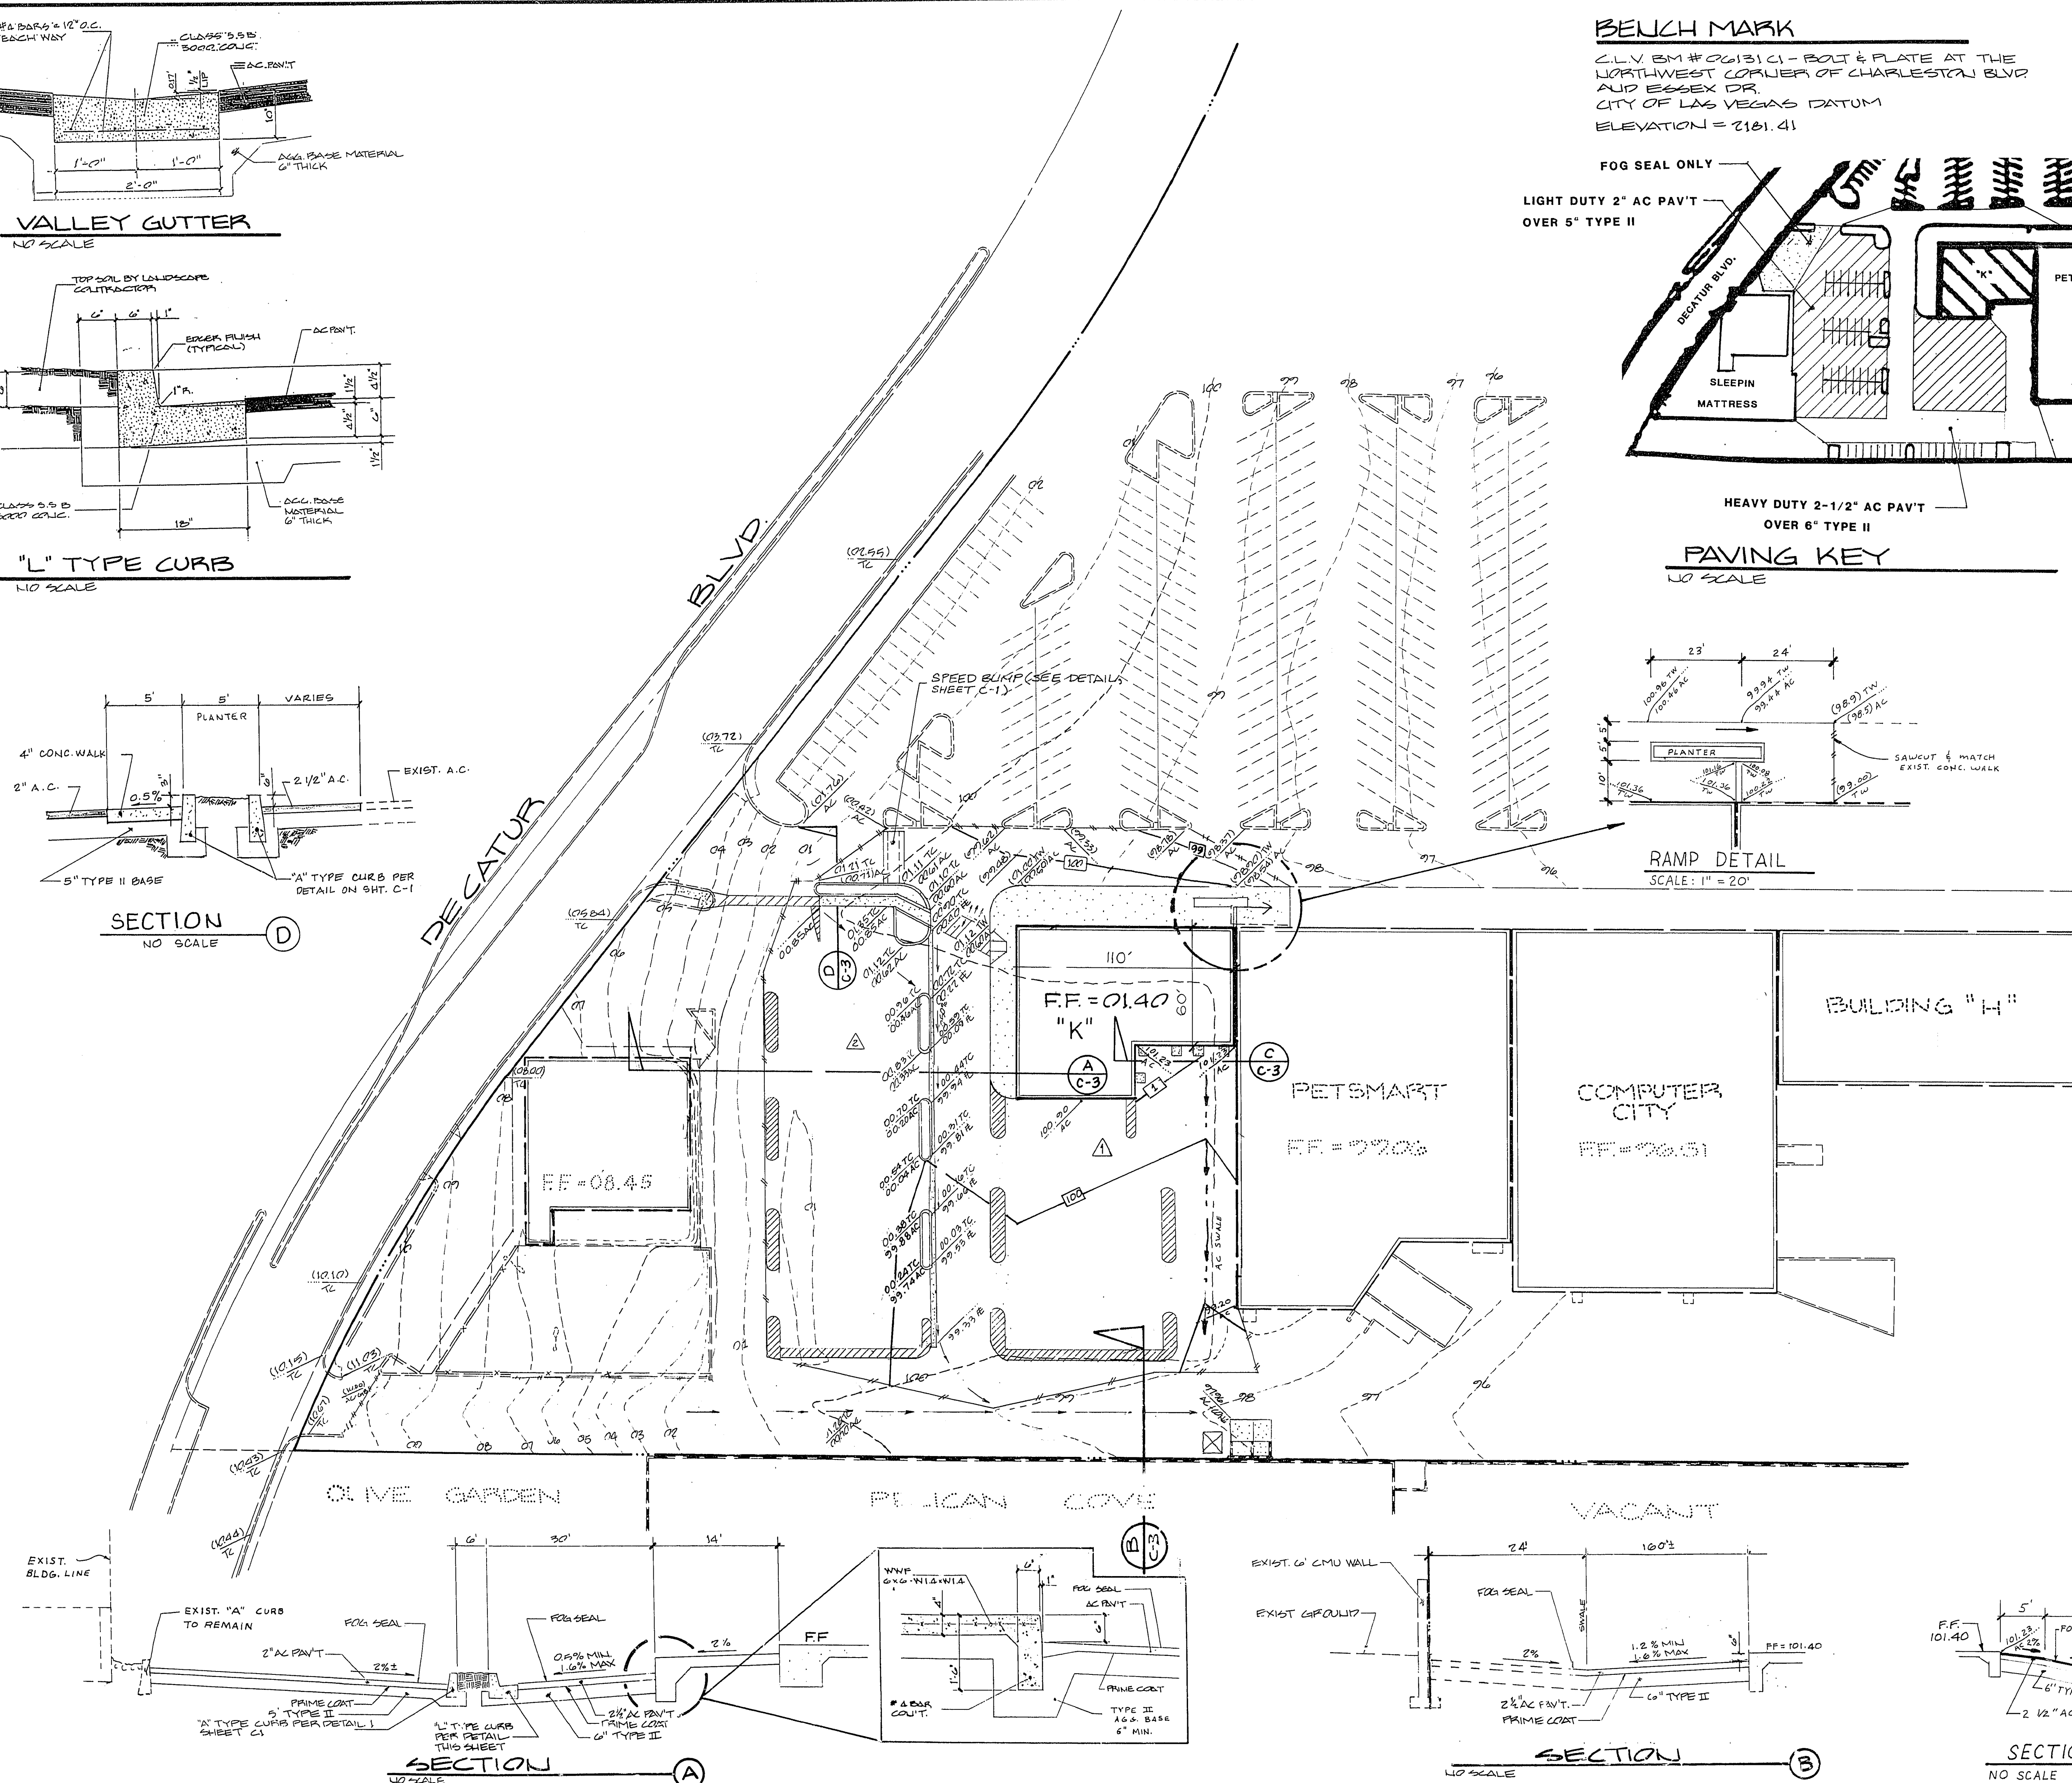

Avoid cutting underground utility lines. It's costly.

Call before you Dig.

1-800-227-2600




UNDERGROUND SERVICE ALERT III

SIGNATURE

S-78-43
DATE

James W. Lela
5/26/93

Flavia

   	GRADING PLAN SECTION 6, TOWNSHIP 21 SOUTH, RANGE 91 EAST, MERIDIAN 11 WEST CITY OF LAS VEGAS, NEVADA			BAUGHMAN & TURNER INC. CIVIL ENGINEERS LAND SURVEYORS 210 HINSON STREET LAS VEGAS, NEVADA		DATE APR. 12, 1983 DESIGN DRAWN C.F.A. CHECK		PREPARED FOR: S.E.S. PROPERTIES		REVISIONS REPAIR BUILDING LENGTH FROM SERVICE LIMITS OF NEULAC. PAV'T		APPR. 
	SHEET 4 OF 13			DATE NO 12/28/83 12/28/83		REVISIONS 1 2		REVISIONS 1 2		REVISIONS 1 2		APPR. 