

SCALE 1"=10'


LEGEND
 ● INDICATES POINT FOUND
 ○ INDICATES POINT SET AS SHOWN

NOTES:
 1) PROPERTY CORNERS ESTABLISHED FROM METES & BOUNDS DESCRIPTION FURNISHED BY WILL ROBERTS REALTY AS ABOVE
 2) BENCH MARK - CLV B.M. #0612743 ELEVATION 1918.55'
 NOTE: UTILITY INFORMATION WAS DERIVED FROM DATA FURNISHED BY UTILITY COMPANIES. CONSULTOR MUST CONFIRM LOCATION OF UTILITIES BEFORE COMMENCING EXCAVATION.

CERTIFICATE

I, RICHARD J. BAUGLIAN, A REGISTERED PROFESSIONAL ENGINEER - RLS DO HEREBY CERTIFY THAT THIS MAP IS A TRUE AND ACCURATE REPRESENTATION OF THE LANDS SHOWN HEREON. ALL POINTS FOUND OR SET ARE CORRECTLY DESIGNATED. THIS SURVEY WAS COMPLETED ON DECEMBER 16TH, 1969 AT THE INSTANCE OF ELDON ROWLEY (WILL ROBERTS REALTY). THIS SURVEY DOES NOT CONSTITUTE A SUBDIVISION AS DEFINED BY NEVADA STATE LAW.

Richard J. Bauglian
 RICHARD J. BAUGLIAN
 REGISTERED PROFESSIONAL ENGINEER
 RLS 2162

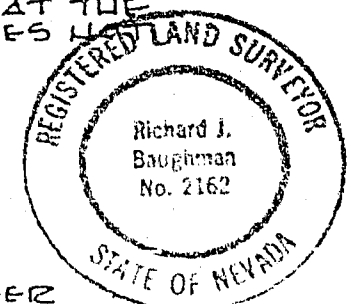

NORTH MAIN STREET
 N. 27° 53' 06" E.

PL. BK. 45 Pg. 102-05

SURVEY MAP
 A PORTION OF THE
 NE 1/4, NE 1/4, SECTION 27
 TOWNSHIP 20 SOUTH, RANGE 61 EAST
 M.D.B.#11
 CLARK COUNTY NEVADA
LEAVITT & ASSOCIATES
 CONSULTING ENGINEERS - LAND SURVEYORS
 536 EAST SAHARA AVENUE LAS VEGAS, NEVADA