


FOUNDATION PLAN
SCALE 1/8" = 1'-0"

- LEGEND:**
- (101) INDICATES PANEL NUMBERS
 - (A) INDICATES COLUMN LINES
 - (S2) INDICATES DETAIL


FOOTING SCHEDULE

COLUMN LINE	SHAPE	SIZE	THICKNESS	DET.	REMARKS
B-1,C-1,D-1,E-1, F-1,G-1	SQUARE	5'-9" SQ.	2'-4"	8	6-#4 BARS EACH WAY @ BOT.
A-2,A-3,A-5,A-6	CONTIN.	18" WIDE	12"	3	5-2
H-2,H-3,H-5,H-6	CONTIN.	18" WIDE	12"	3	5-2
A-1,H-7	TRIANGLE	8'-2" x 8'-2"	24"	7	5-3
A-7,H-1	TRIANGLE	8'-2" x 8'-2"	24"	7	5-3
B-4,C-4,D-4,E-4, F-4,G-4	SQUARE	5'-9" SQ.	2'-4"	6	6-#4 BARS EACH WAY @ BOT.
B-7,C-7,D-7,E-7, F-7,G-7	SQUARE	5'-9" SQ.	2'-4"	8	5-3

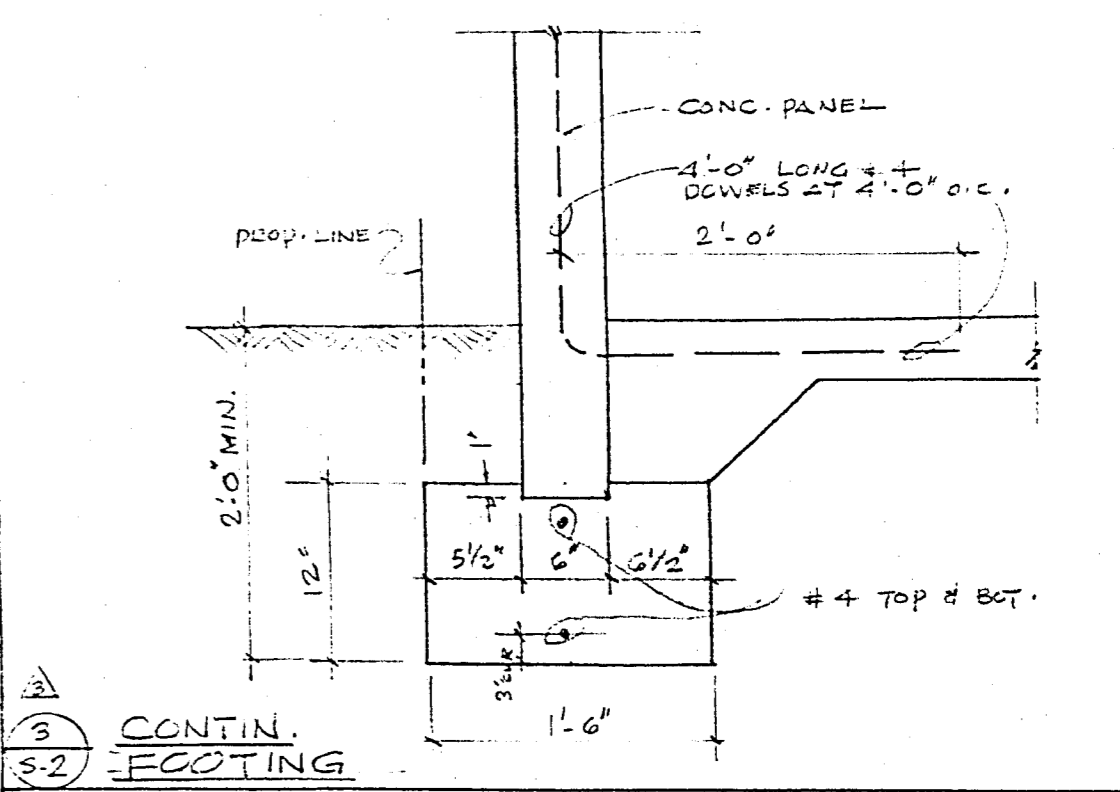


FOOTING SIZING TABLE

H'	B'	T'	V'	B'	F'
1'-4"	1'-2"	10"	NONE	1-#3 ONLY	NONE
1'-4"	1'-2"	10"	#3 @ 32" O.C.	1-#4 TOP & BOT.	NONE
2'-0"	1'-11"	12"	#3 @ 24" O.C.	1-#4 TOP & BOT.	NONE
2'-8"	2'-6"	12"	#4 @ 32" O.C.	1-#4 TOP	#4 @ 32" O.C.
3'-4"	2'-10"	12"	#4 @ 24" O.C.	2-#4	#4 @ 24" O.C.

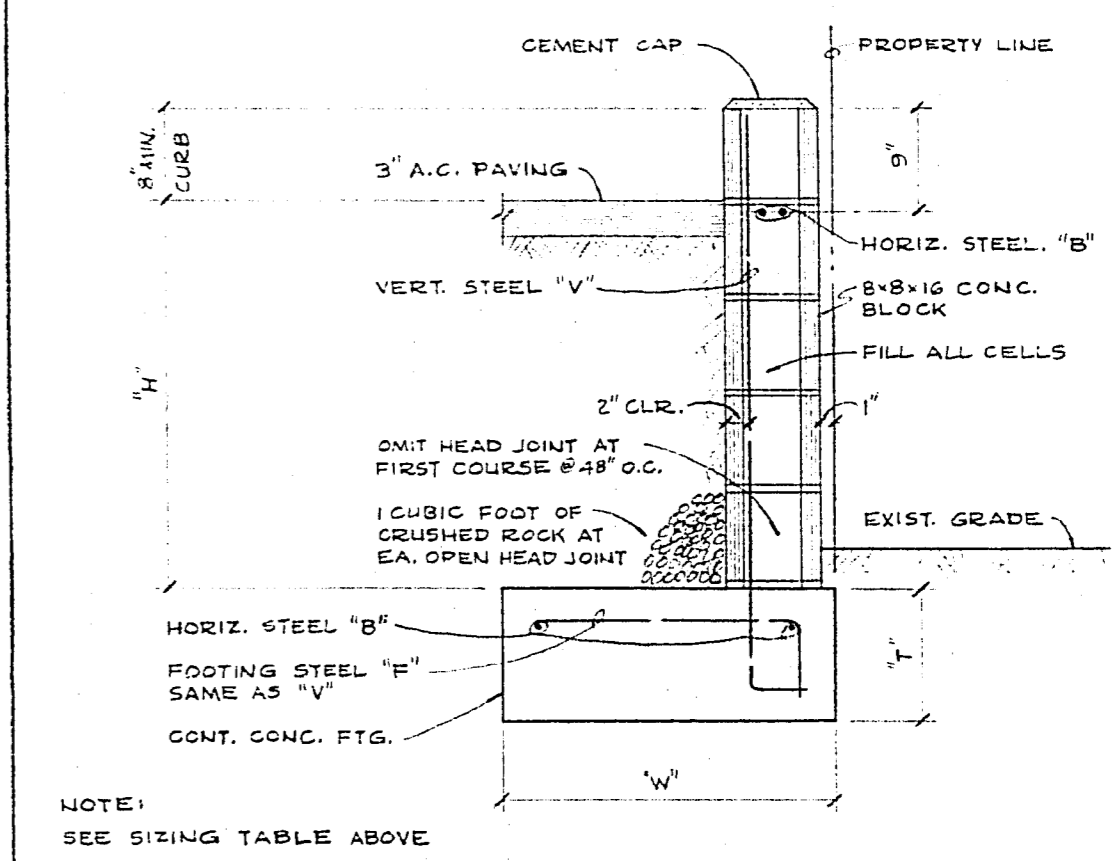

RETAINING WALL SIZING TABLE

H'	B'	T'	V'	B'	F'
1'-4"	1'-2"	10"	NONE	1-#3 ONLY	NONE
1'-4"	1'-2"	10"	#3 @ 32" O.C.	1-#4 TOP & BOT.	NONE
2'-0"	1'-8"	12"	#3 @ 24" O.C.	1-#4 TOP & BOT.	NONE
2'-8"	2'-4"	12"	#4 @ 32" O.C.	1-#4 TOP	#4 @ 32" O.C.
2'-8"	2'-4"	12"	#4 @ 32" O.C.	2-#4	#4 @ 32" O.C.

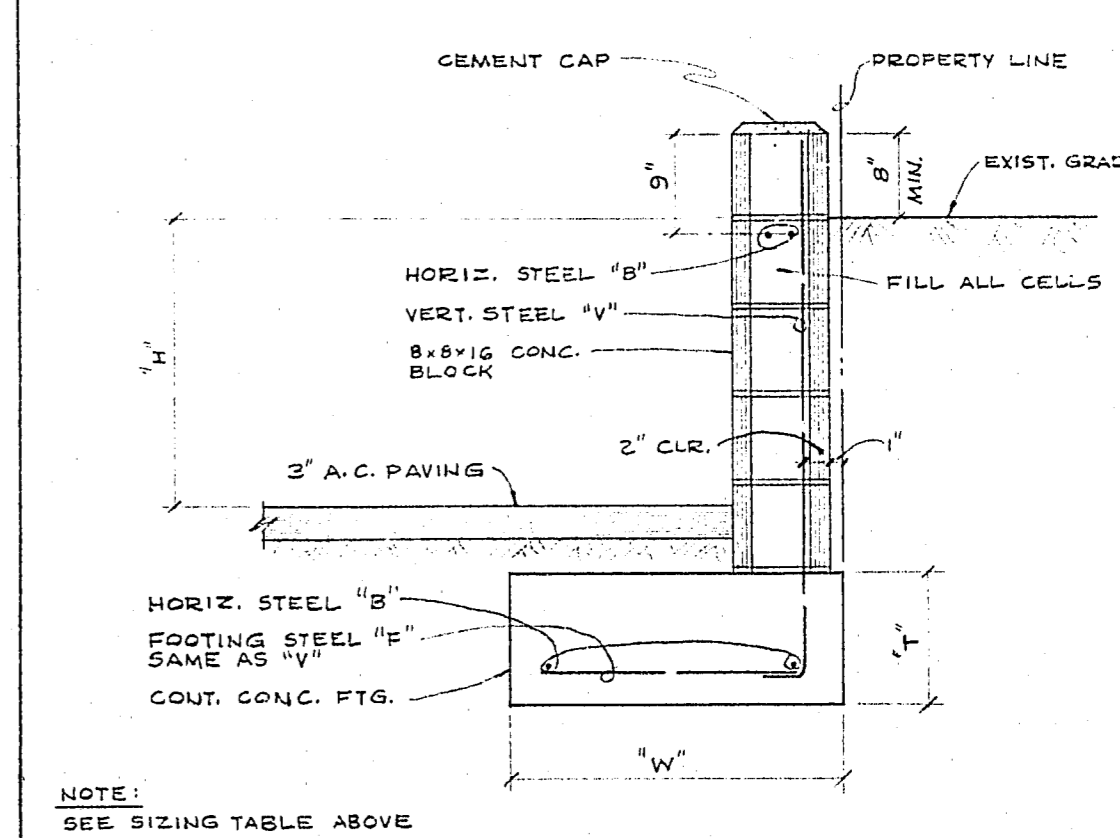

RETAINING WALL DETAIL
SCALE 3/4" = 1'-0"

WHOLESALE, RETAIL DISTRIBUTION CENTER
FOR
SMART AND FINAL IRIS CO.
NORTH MAIN STREET, LAS VEGAS, NEVADA

THESE DRAWINGS ARE THE PROPERTY OF JACK H. MACDONALD ARCHITECTS AND ENGINEERS. NO PART OF THESE DRAWINGS IS TO BE REPRODUCED OR TRANSMITTED IN ANY FORM OR BY ANY MEANS, ELECTRONIC OR MECHANICAL, WITHOUT THE WRITTEN CONSENT OF JACK H. MACDONALD ARCHITECTS AND ENGINEERS.

JACK H. MACDONALD
ARCHITECTS AND ENGINEERS
321 S. SAN VICENTE BLVD. LOS ANGELES 90048 272-3131

REVISIONS: REVISE FOOTINGS AND LINES A, H, AND J PLAN & DET. SIZE 7-30-70 BY R.S. DATE 7-30-70
REVISION REV. FOUNDATION PLAN / FOOTING SCHEDULE DATE 8-10-70 BY R.S. DATE 8-10-70
DRAWN BY C.S. CHECKED APPROVED

SHEET NO. 521-228