



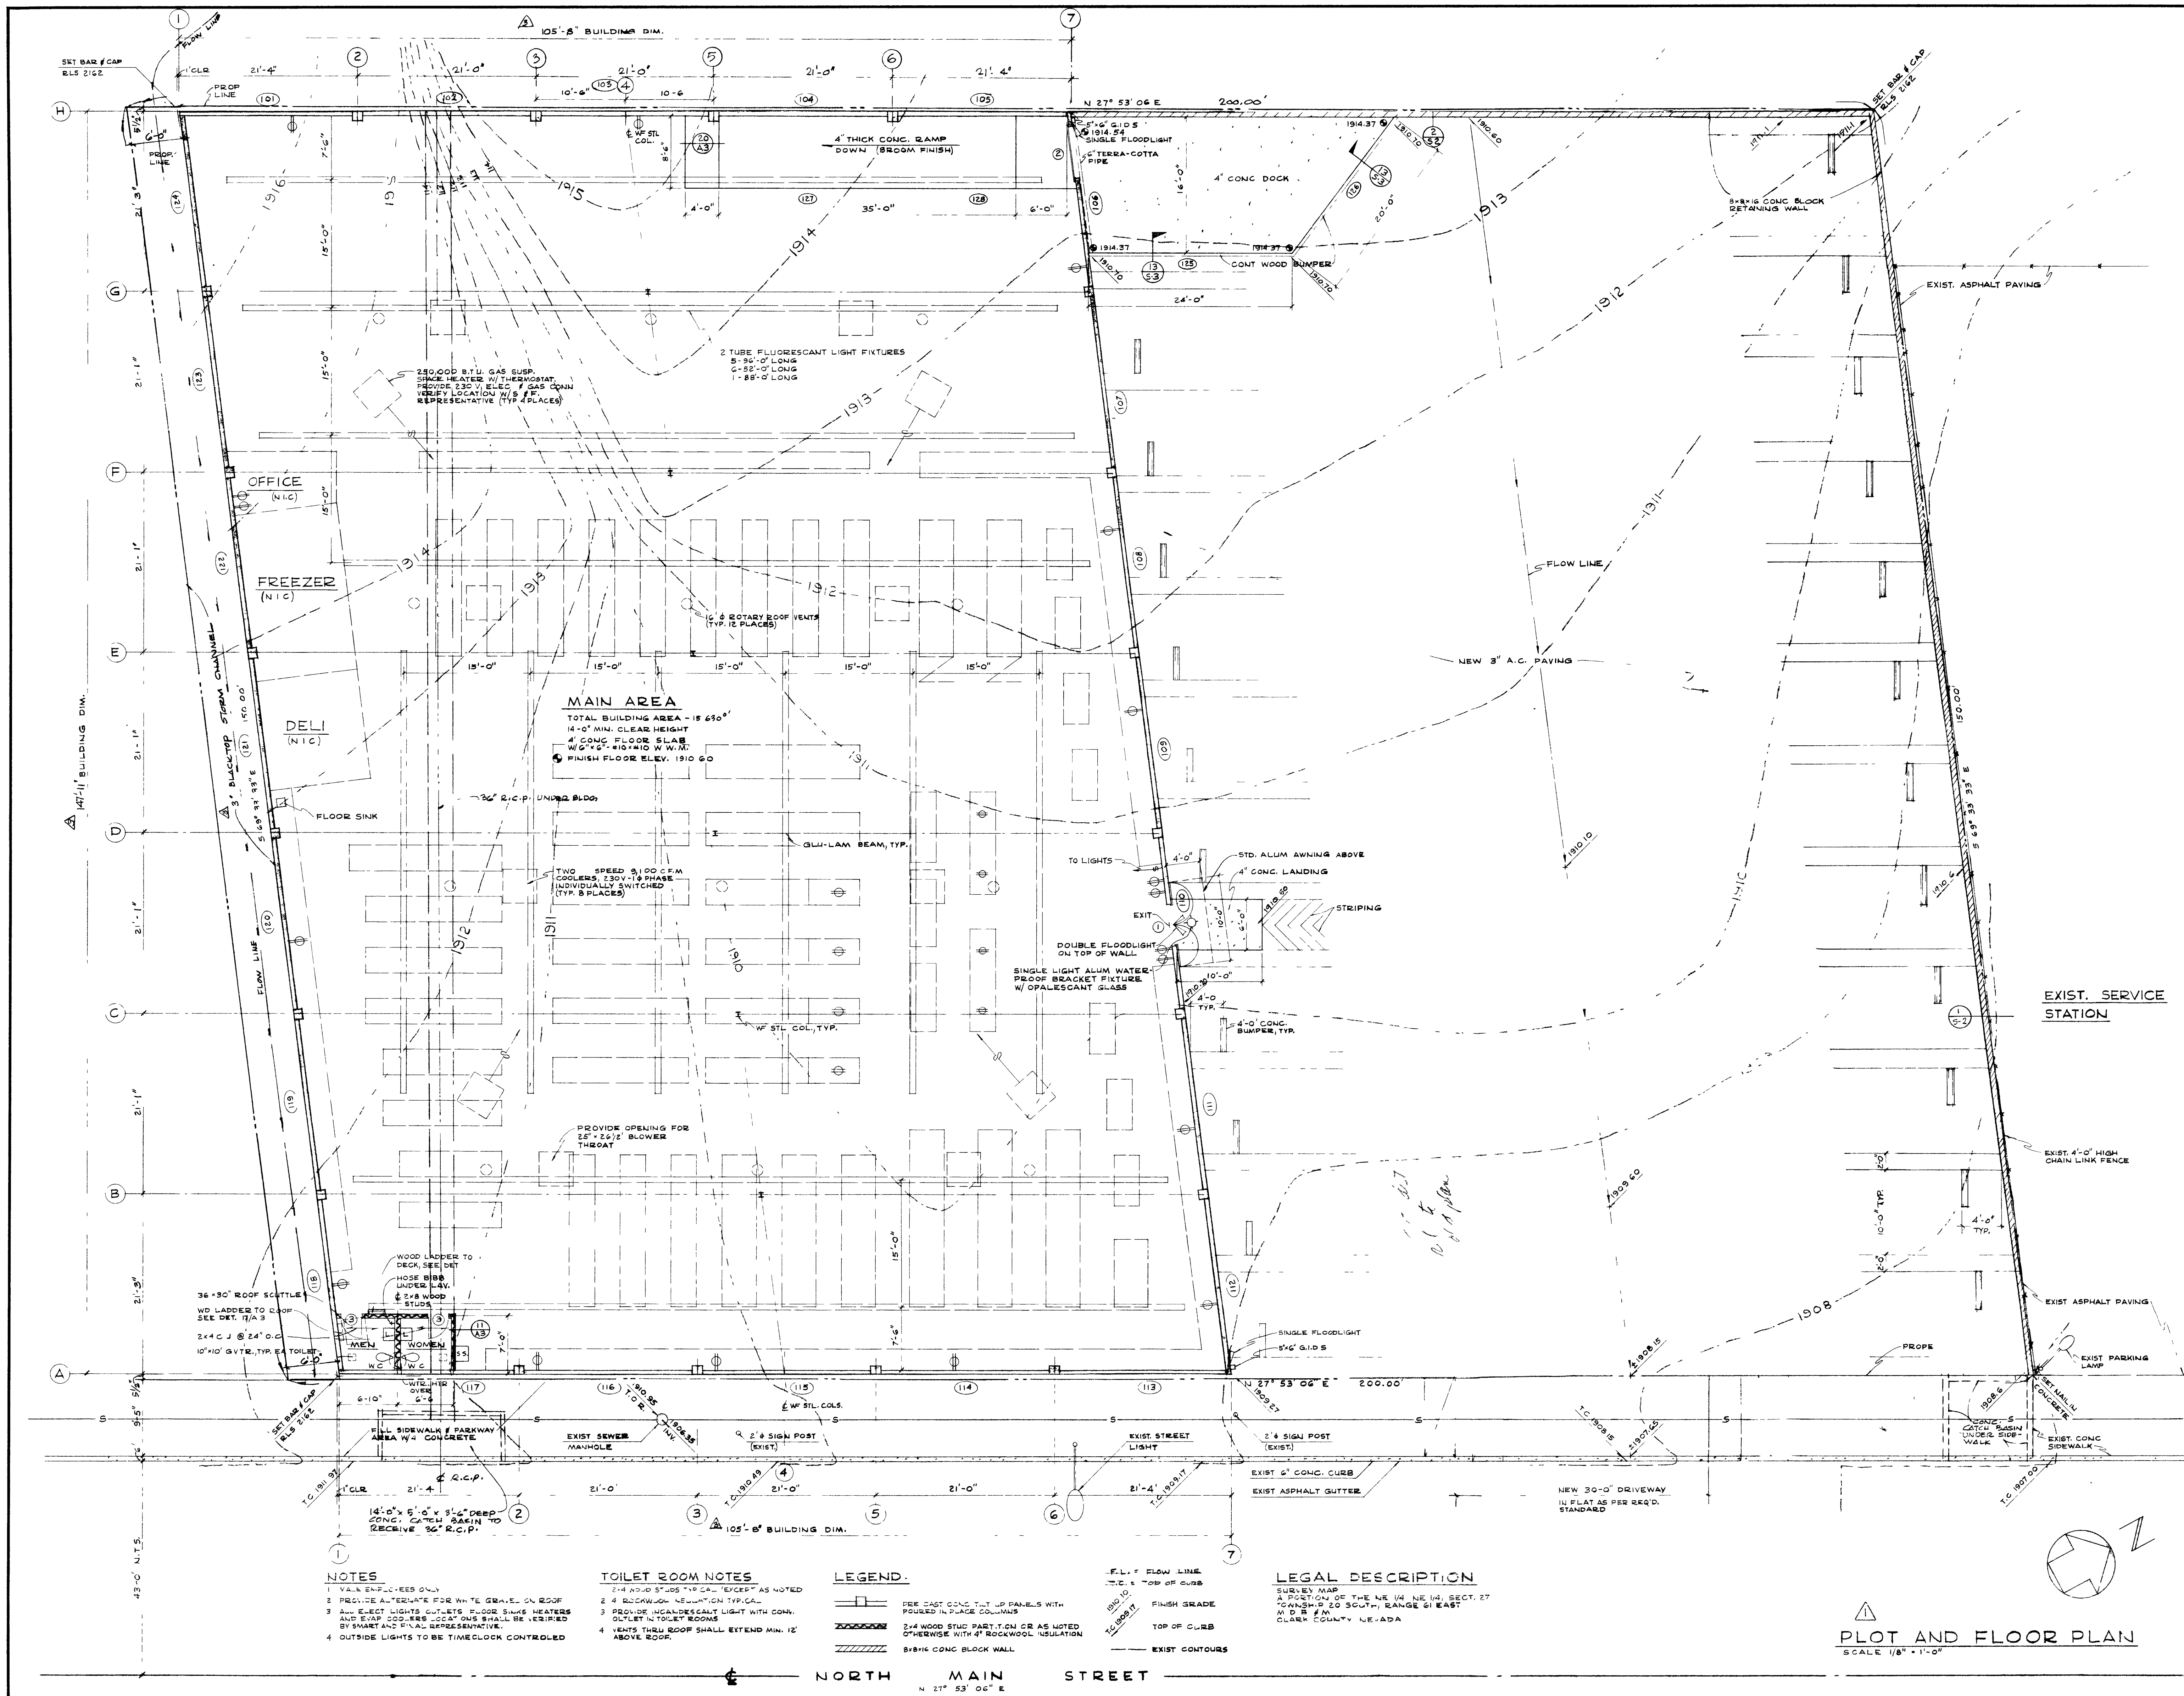

WHOLESALE, RETAIL DISTRIBUTION CENTER FOR SMART AND FINAL IRIS CO. NORTH MAIN STREET, LAS VEGAS, NEVADA	
SHEET NO. A-1	DATE 2-20-70
CHECKED R.S.I.	APPROVED R.S.I.
JOB NO. 2064	
REVISION REV. PLOT # FLOOR PLAN PER S.F.F.	
DATE: 8-10-70 BY: R.S.I.	
DRAWN BY R.S.I.	
DESIGN, BUILD SIZE, & LOCATION - ADD DRAINAGE PLAN, T-30-70, R.L.E.	

JACK H. MACDONALD ARCHITECTS AND ENGINEERS 321 S. SAN VICENTE BLVD. LOS ANGELES 90048 272-3131	THESE DRAWINGS ARE THE EXCLUSIVE PROPERTY OF JACK H. MACDONALD ARCHITECTS AND MAY NOT BE REPRODUCED OR IN ANY MANNER WITHOUT WRITTEN CONSENT OF SAID ARCHITECT.
--	---

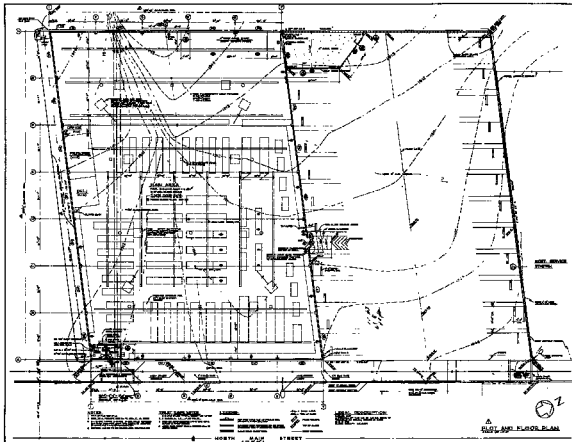



△
PLOT AND FLOOR PLAN

← NORTH
MAIN STREET

JACK W. MACDONALD
ARCHITECTS AND ENGINEERS

A-1