


WILDWOOD MANOR

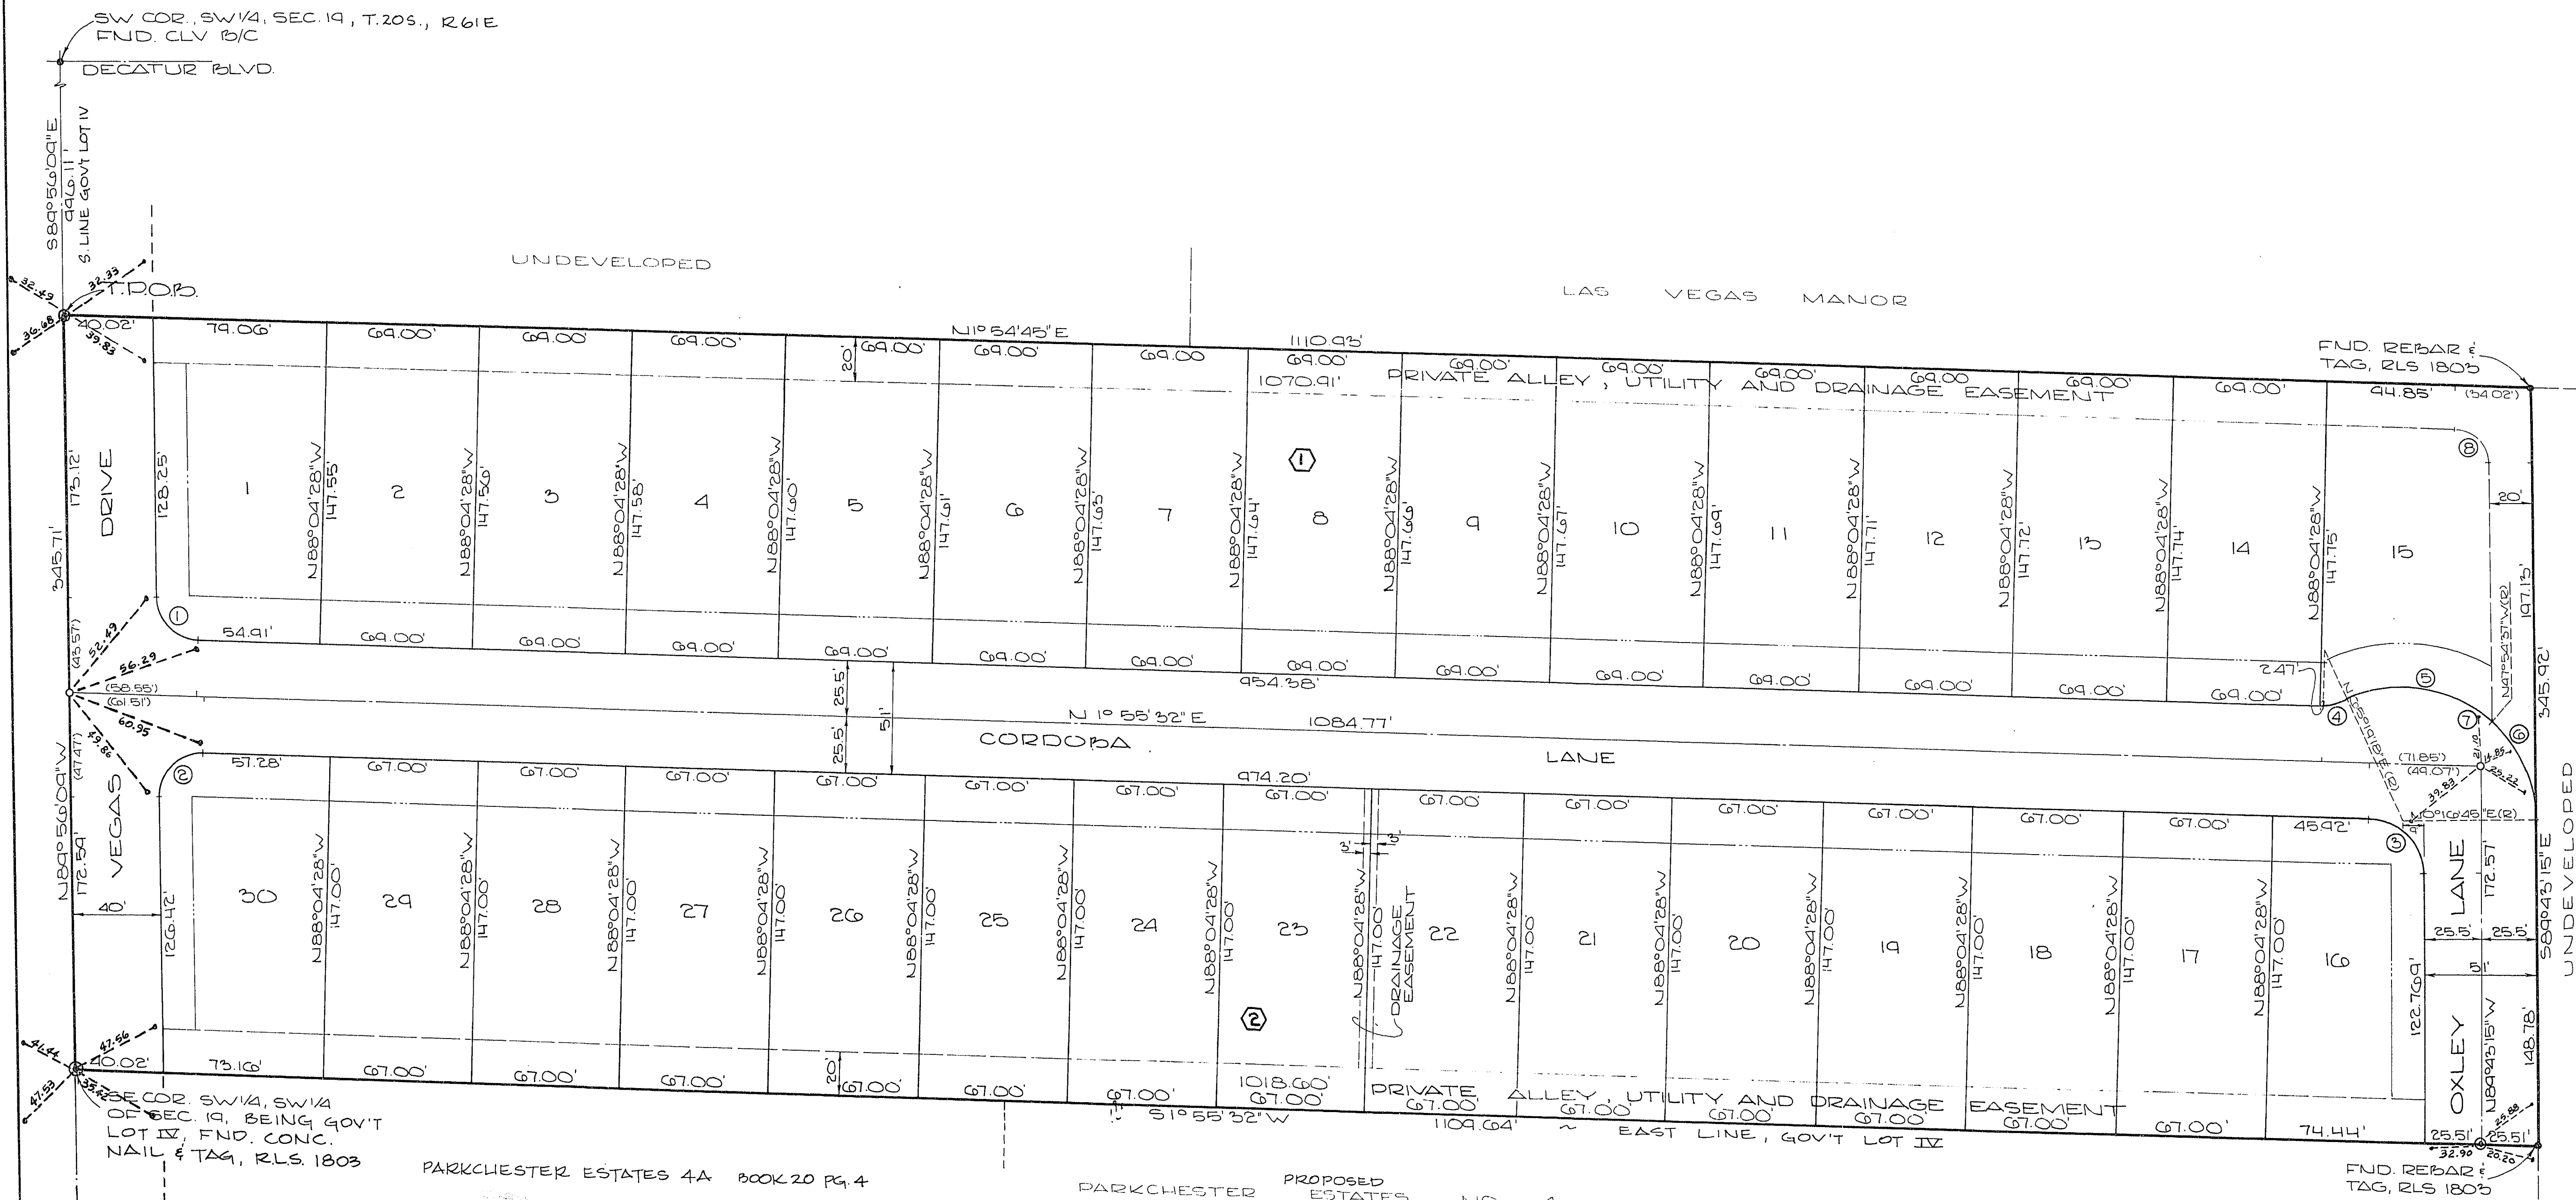

SURVEYOR'S CERTIFICATE:

I, Jerry E. Barnson, a Registered Land Surveyor, do hereby certify that the monuments have been set & the ties established as shown hereon.

Jerry E. Barnson 2/5/79
Jerry E. Barnson R.L.S.
Nevada Cert. No. 4046 Date

- LEGEND**
- 1) LOT NUMBER
 - 2) CURVE NUMBER
 - 3) SET BRASS CAP IN CONC. MON. RLS 4046
 - 4) FND. MON. AS INDICATED
 - 5) BUILDING SETBACK LINE
 - 6) 20' FRONT
 - 7) 15' SIDE
 - 8) BLOCK NUMBER
 - 9) SET 5/8" REBAR WITH AL. CAP RLS 4046
 - 10) SET BRASS NAIL IN LEAD IN TOP OF CURB

CURVE DATA				
NO.	Δ	R	L	T
1	88°08'19"	20.00'	30.77'	19.56'
2	91°51'41"	20.00'	32.07'	20.66'
3	88°21'13"	25.00'	58.58'	24.29'
4	26°36'14"	25.00'	11.61'	6.91'
5	66°46'08"	60.00'	69.92'	39.54'
6	48°11'22"	60.00'	50.46'	26.83'
7	114°57'27"	60.00'	120.58'	94.10'
8	68°22'00"	15.00'	25.13'	14.58'

NORTH 1" = 40'