


MONUMENT TIE MAP
WINDCHIME — PHASE I

(A PORTION OF LOT 3, PARCEL MAP — F.57, PG. 90)
A PORTION OF THE SOUTHEAST QUARTER (SE 1/4) OF THE SOUTHWEST QUARTER (SW 1/4)
OF SECTION 20, TOWNSHIP 20 SOUTH, RANGE 61 EAST, M.D.M.,
CITY OF LAS VEGAS, CLARK COUNTY, NEVADA

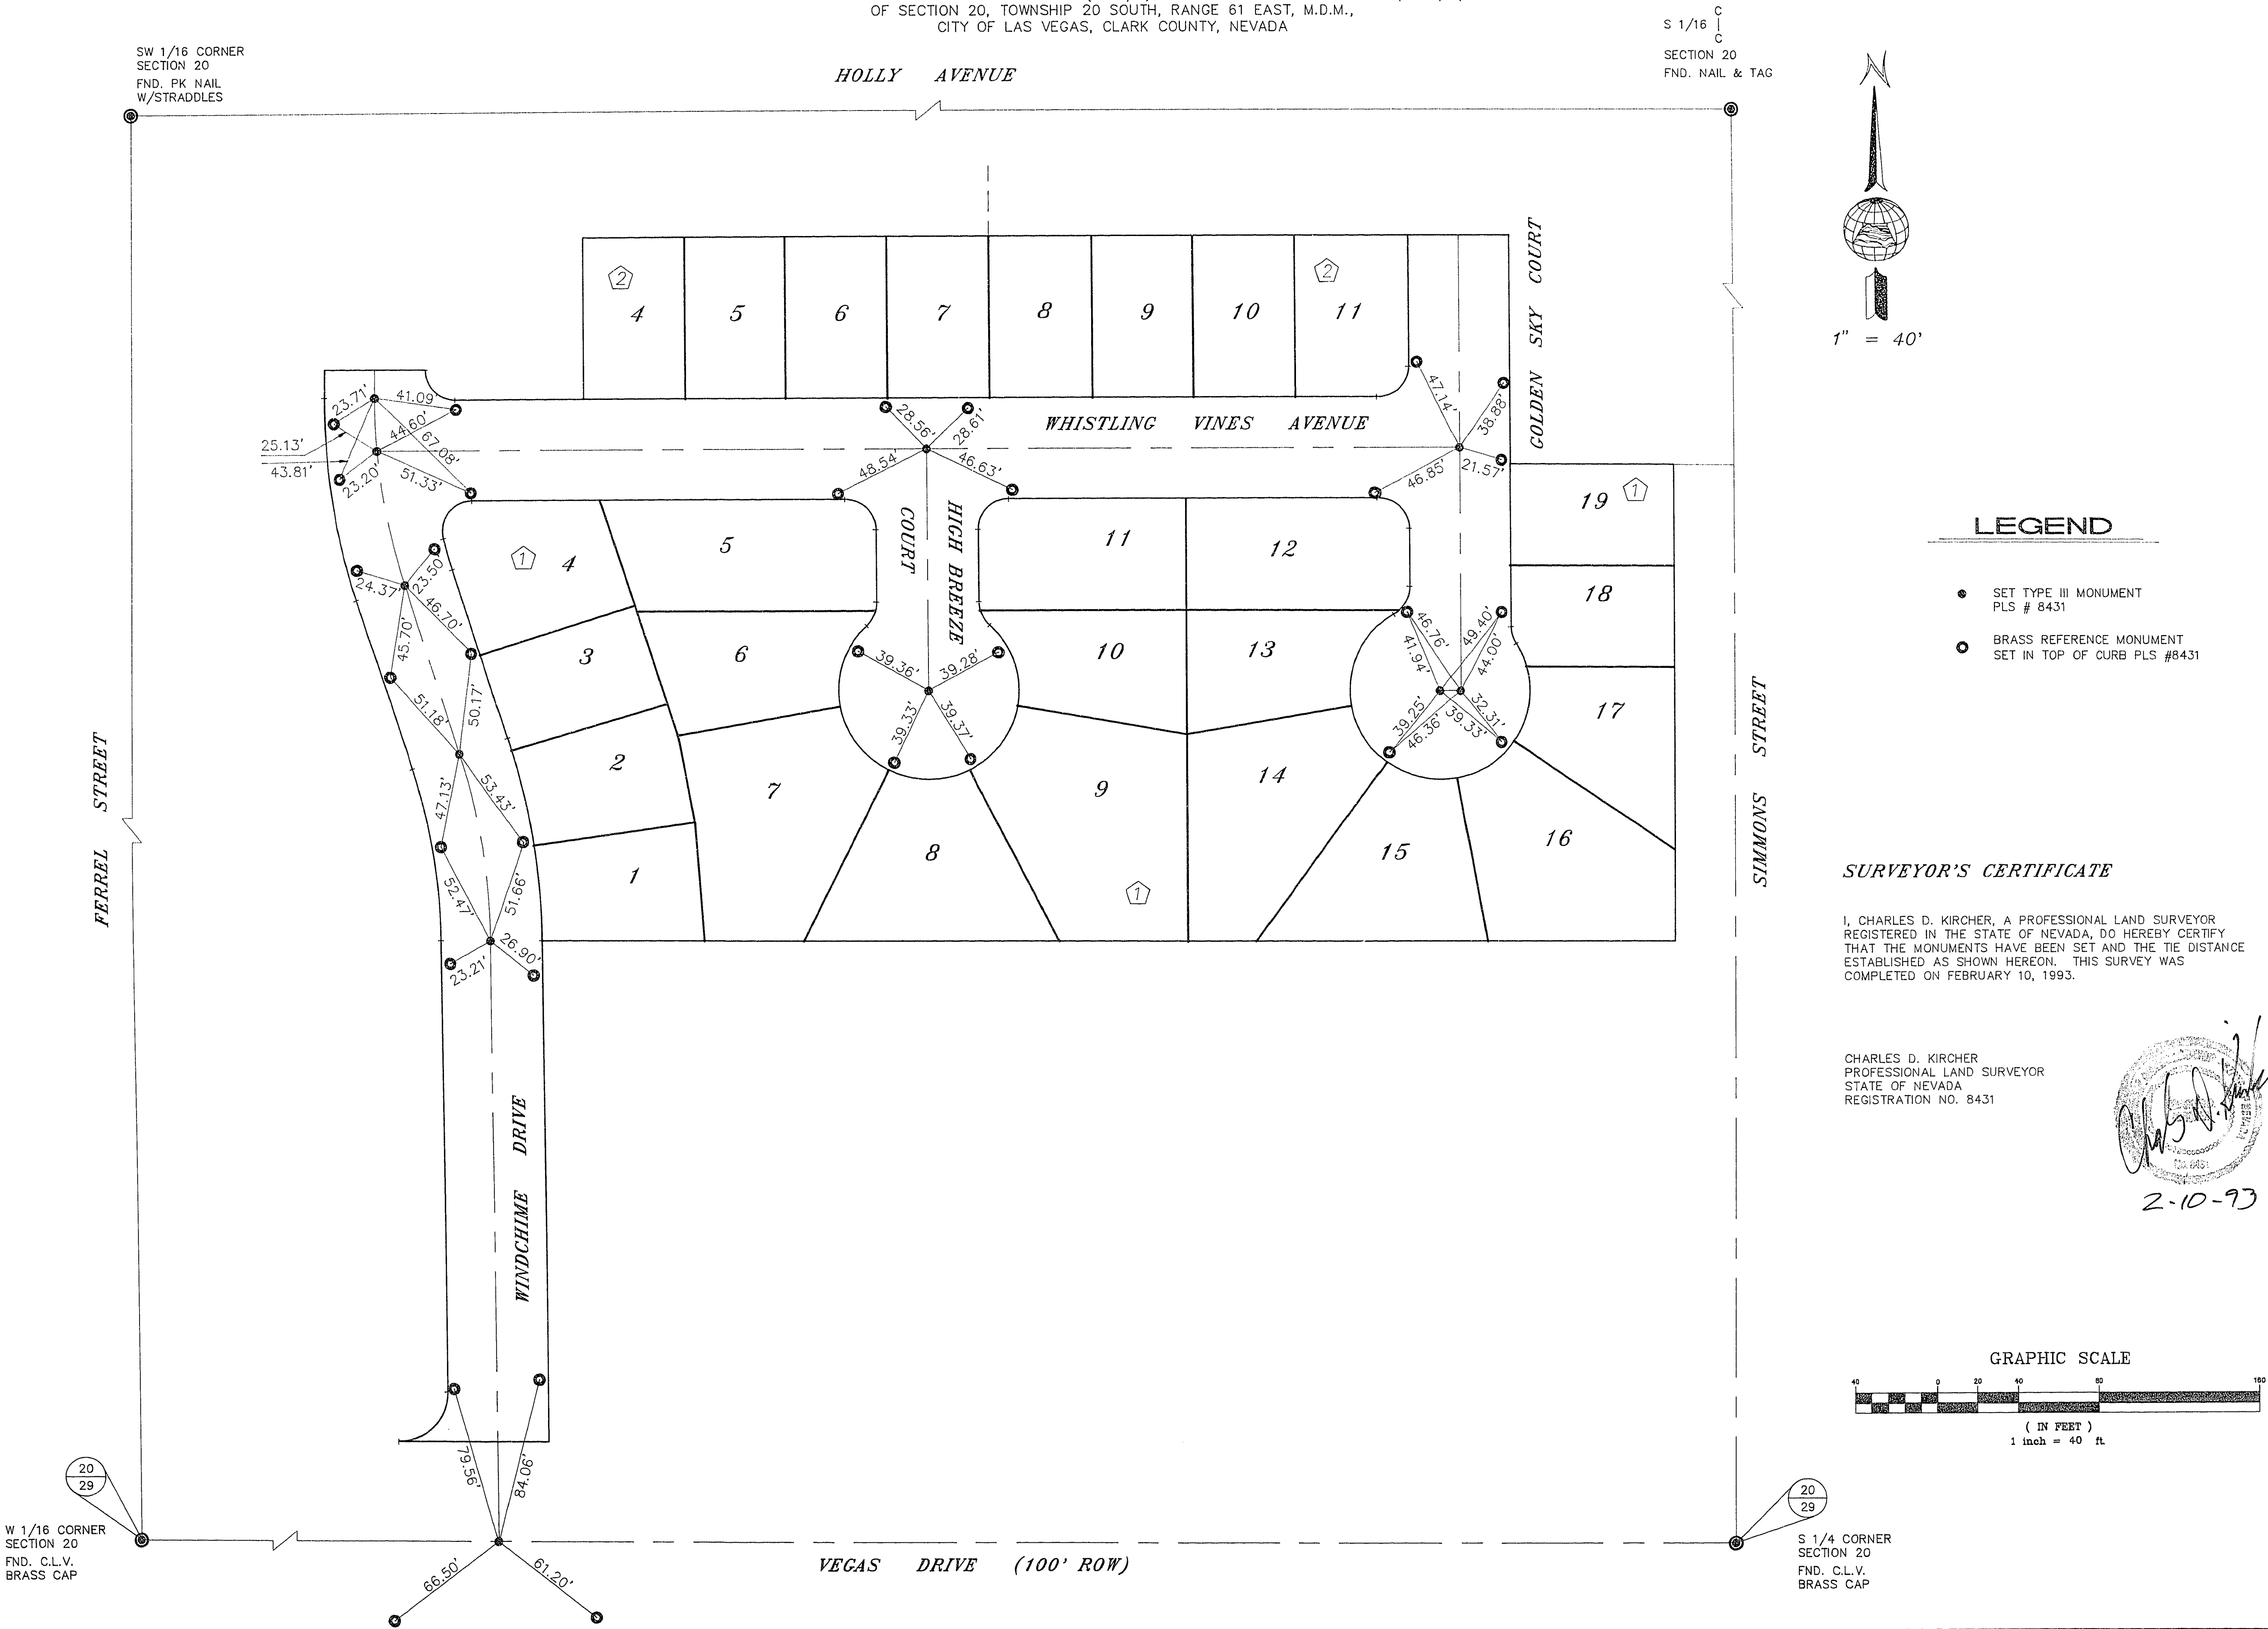

LEGEND


- SET TYPE III MONUMENT
PLS # 8431
- BRASS REFERENCE MONUMENT
SET IN TOP OF CURB PLS #8431

SURVEYOR'S CERTIFICATE

I, CHARLES D. KIRCHER, A PROFESSIONAL LAND SURVEYOR
REGISTERED IN THE STATE OF NEVADA, DO HEREBY CERTIFY
THAT THE MONUMENTS HAVE BEEN SET AND THE TIE DISTANCE
ESTABLISHED AS SHOWN HEREON. THIS SURVEY WAS
COMPLETED ON FEBRUARY 10, 1993.

CHARLES D. KIRCHER
PROFESSIONAL LAND SURVEYOR
STATE OF NEVADA
REGISTRATION NO. 8431

2-10-93

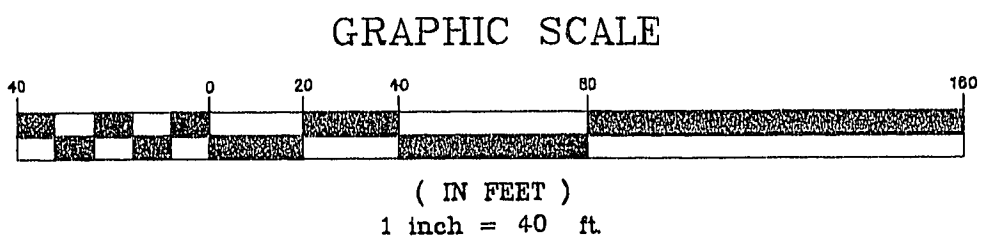

Job Number	Drawn by	Scale	File No.	Date
7089.401	Checked by	1" = 40'		
Sheet Number				
1 OF 1				

REVISIONS	No.	Date	Appr.	Date

Church Engineering of Nevada, Inc.
Consulting Engineers
Planners
Surveyors
6600 W. Charleston Blvd.
Suite 140
Las Vegas, NV 89102
(702) 890-0244

DURABLE HOMES

MONUMENT TIE MAP
WINDCHIME
PHASE I

11-6-2015 058-4219-1