
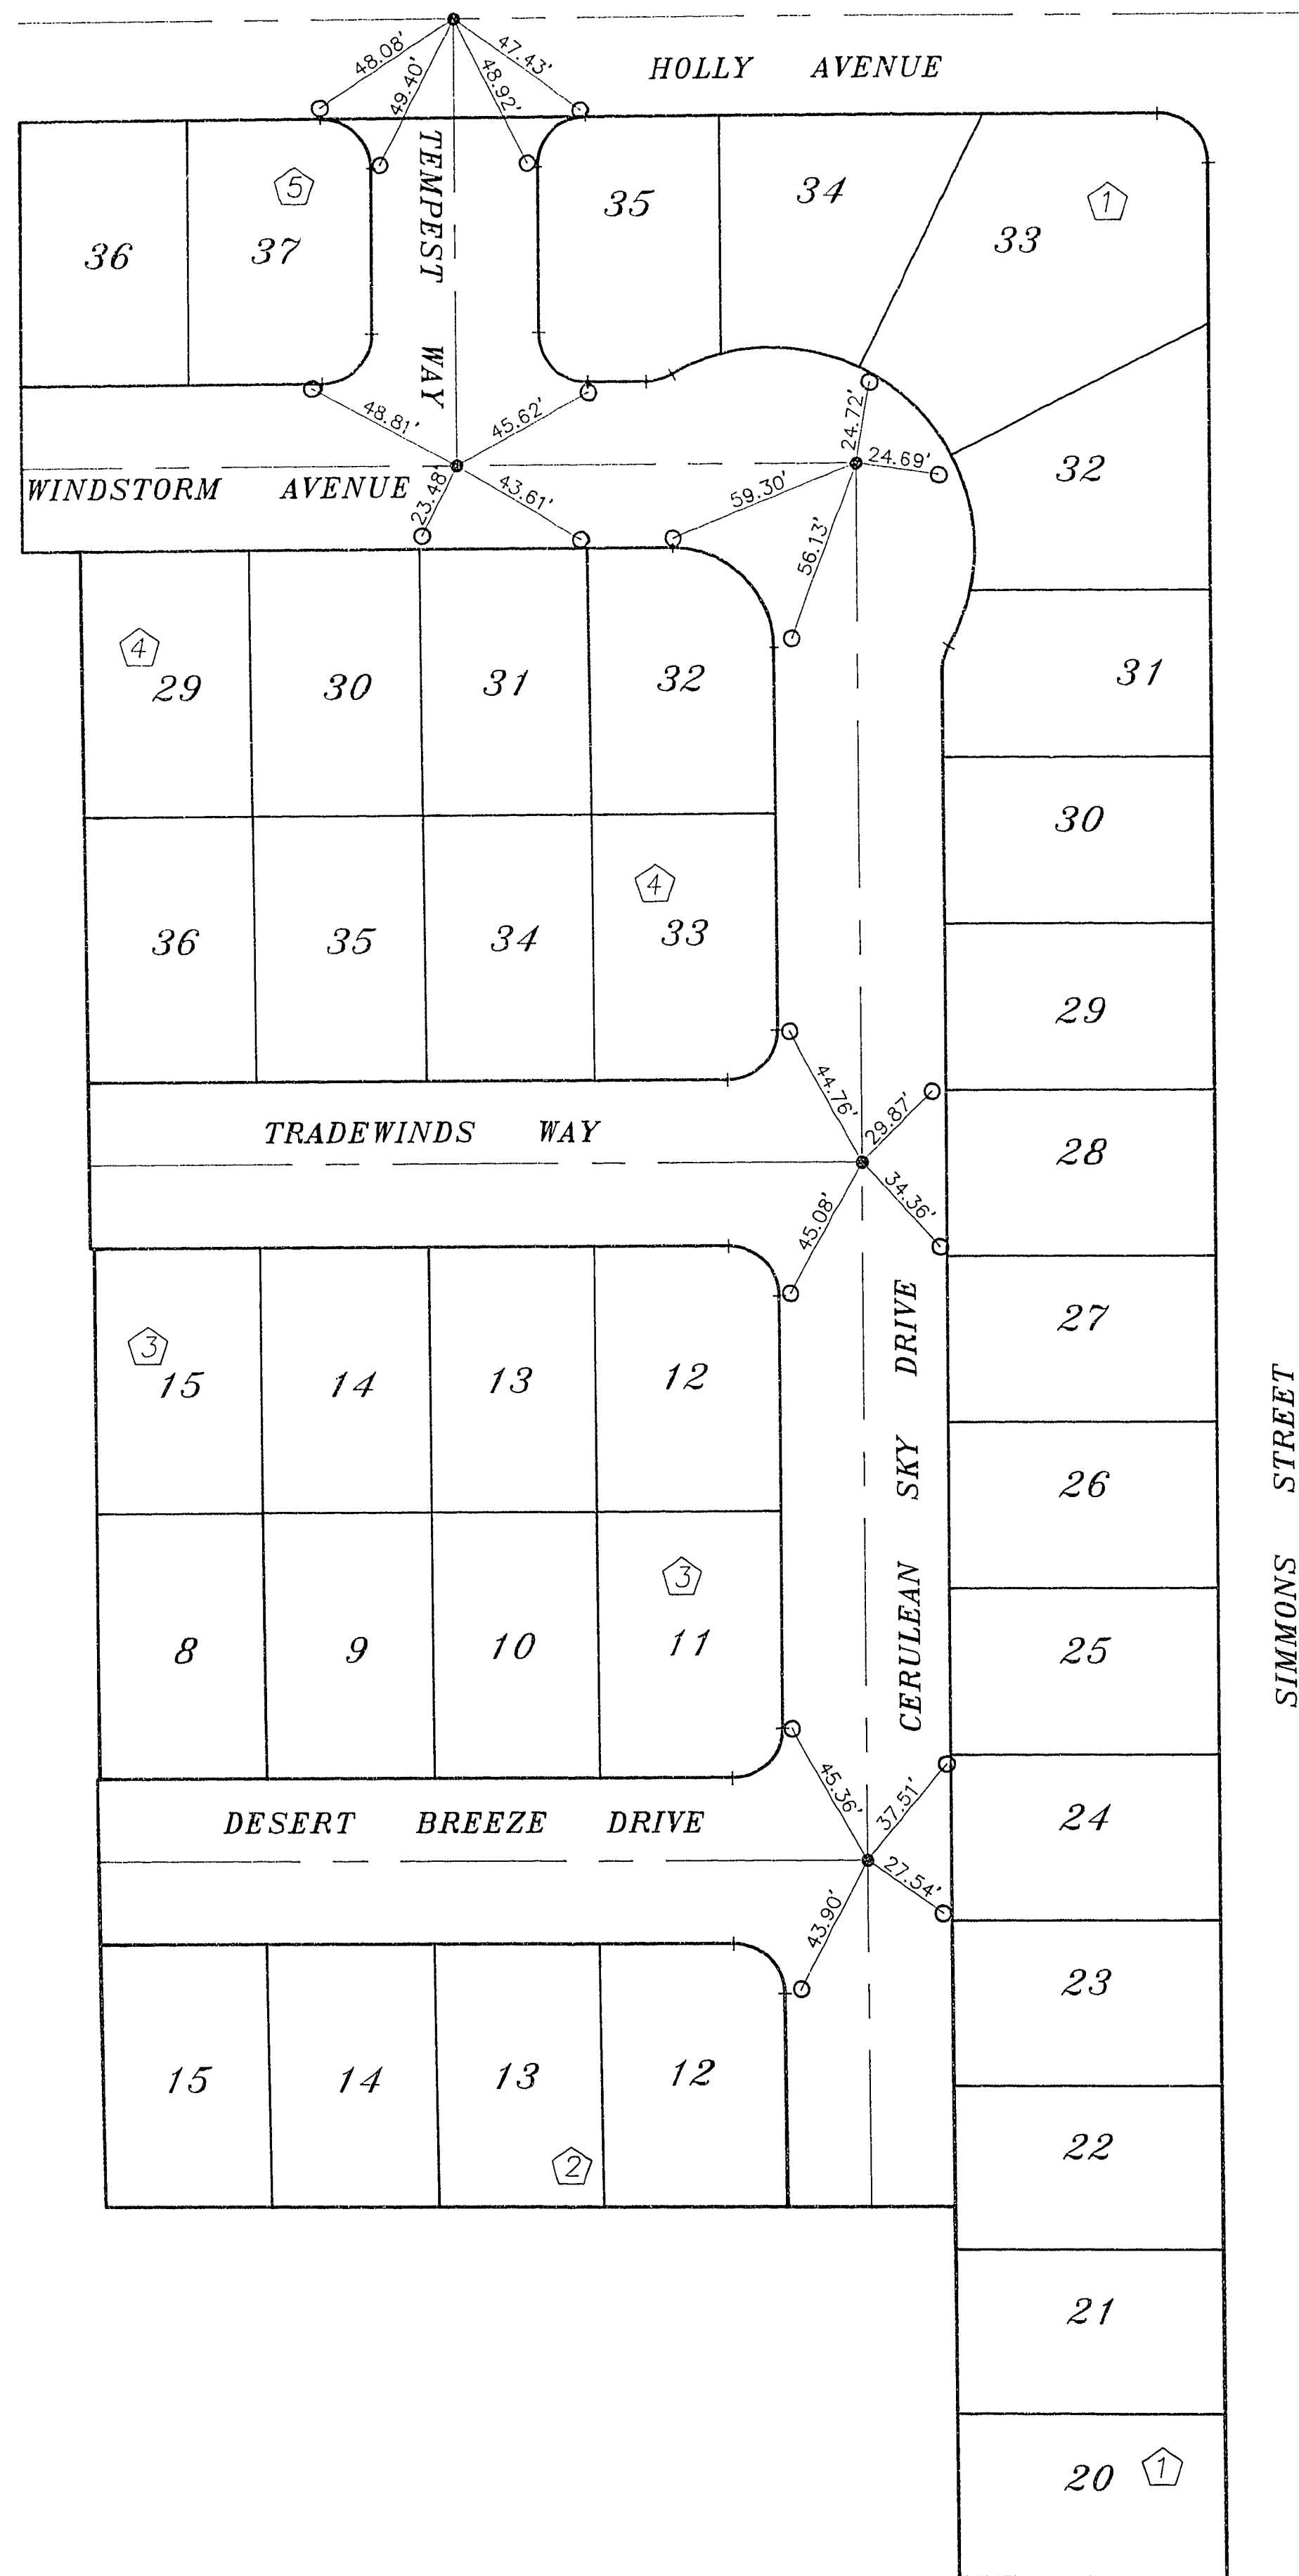


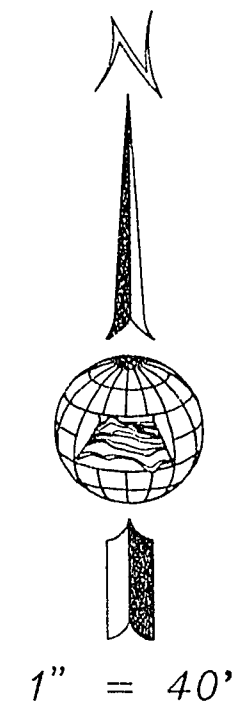

MONUMENT TIE MAP
WINDCHIME — PHASE 2

(BOOK 54 OF PLATS, PAGE 30)
A PORTION OF THE SOUTHEAST QUARTER (SE 1/4) OF THE SOUTHWEST QUARTER (SW 1/4)
OF SECTION 20, TOWNSHIP 20 SOUTH, RANGE 61 EAST, M.D.M.,
CITY OF LAS VEGAS, CLARK COUNTY, NEVADA


LEGEND

- SET TYPE III MONUMENT
PLS # 8431
- BRASS REFERENCE MONUMENT
SET IN TOP OF CURB PLS #8431
- 21 LOT NUMBER
- ① BLOCK NUMBER

SURVEYOR'S CERTIFICATE

I, CHARLES D. KIRCHER, A PROFESSIONAL LAND SURVEYOR
REGISTERED IN THE STATE OF NEVADA, DO HEREBY CERTIFY
THAT THE MONUMENTS HAVE BEEN SET AND THE TIE DISTANCE
ESTABLISHED AS SHOWN HEREON. THIS SURVEY WAS
COMPLETED ON JULY, 6, 1993.

CHARLES D. KIRCHER
PROFESSIONAL LAND SURVEYOR
STATE OF NEVADA
REGISTRATION NO. 8431

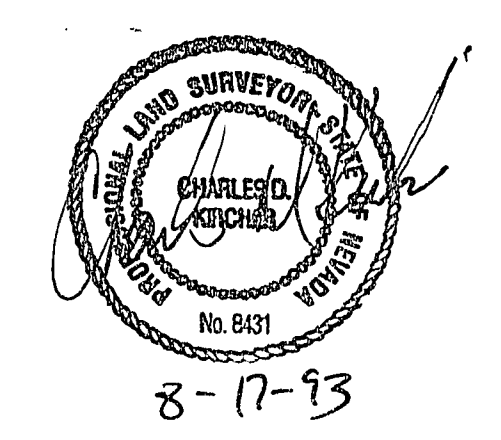

Job Number 7089-401	Drawn by BT	Scale 1" = 40'	Date 9/16/93	Sheet Number 1 OF 1	Checked by CDK	File No.	DURABLE HOMES	MONUMENT TIE MAP WINDCHIME PHASE 2	Church Engineering of Nevada, Inc. 6600 E. Charleston Blvd. Suite 140 Las Vegas, NV 89102 (702) 878-6244	No.	REVISIONS	Date	Int.	Appr.	Date
------------------------	----------------	-------------------	-----------------	------------------------	-------------------	----------	---------------	--	--	-----	-----------	------	------	-------	------

11-6-214 058-4219-2