


WINDCHIME – PHASE 3

(BOOK 54 OF PLATS, PAGE 30)

(A PORTION OF LOT 3, PARCEL MAP - F. 57, PG. 90)

A PORTION OF THE SOUTHEAST QUARTER (SE 1/4) OF THE SOUTHWEST QUARTER (SW 1/4)
OF SECTION 20, TOWNSHIP 20 SOUTH, RANGE 61 EAST, M.D.M.,
CITY OF LAS VEGAS, CLARK COUNTY, NEVADA

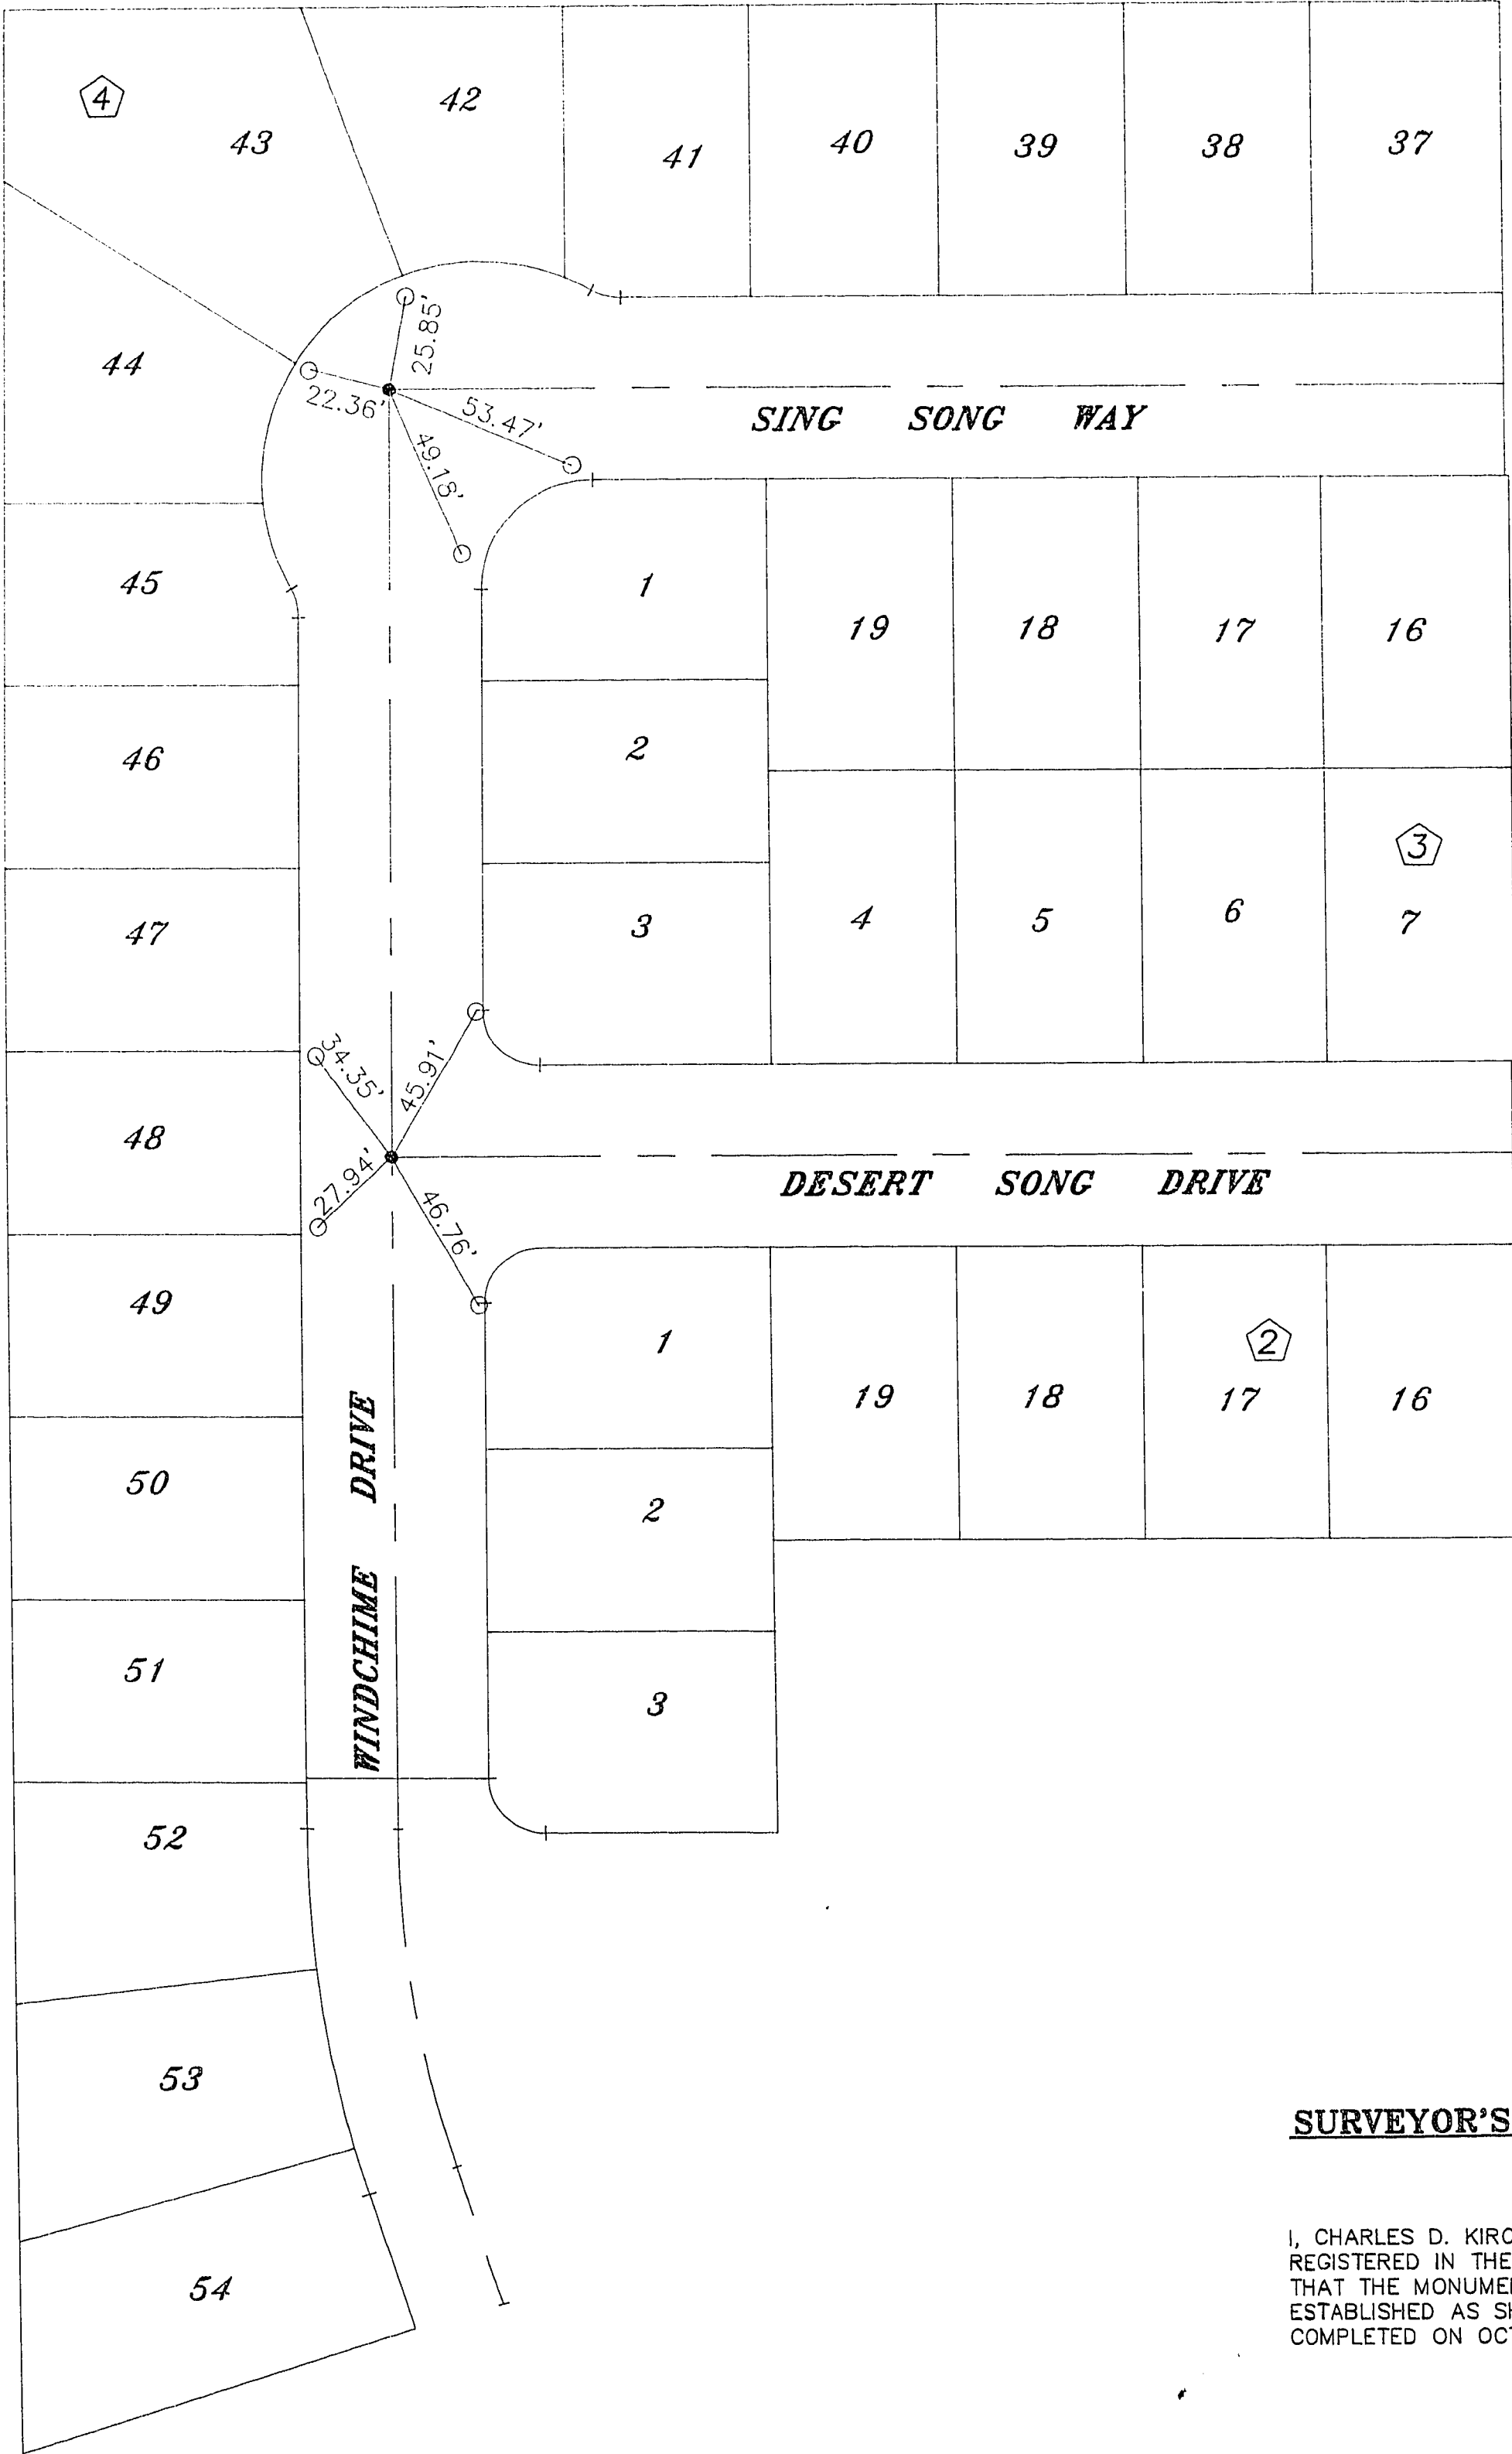

LEGEND

- SET TYPE III MONUMENT
PLS # 8431
- BRASS REFERENCE MONUMENT
SET IN TOP OF CURB PLS #8431


21 LOT NUMBER

① BLOCK NUMBER


SURVEYOR'S CERTIFICATE

I, CHARLES D. KIRCHER, A PROFESSIONAL LAND SURVEYOR
REGISTERED IN THE STATE OF NEVADA, DO HEREBY CERTIFY
THAT THE MONUMENTS HAVE BEEN SET AND THE TIE DISTANCE
ESTABLISHED AS SHOWN HEREON. THIS SURVEY WAS
COMPLETED ON OCTOBER 12, 1993.

CHARLES D. KIRCHER
PROFESSIONAL LAND SURVEYOR
STATE OF NEVADA
REGISTRATION NO. 8431

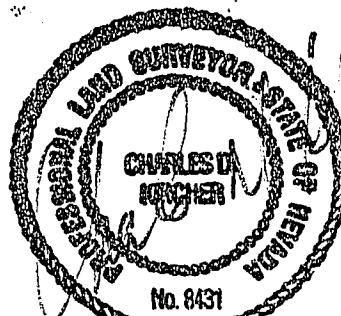

10-28-9.

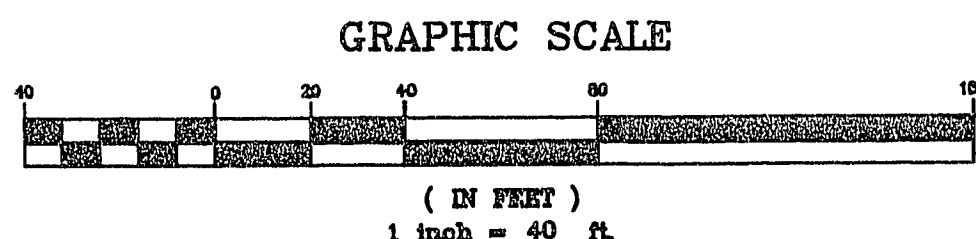

Job Number 7089.401	Drawn by BT	Scale AS SHOWN	DURABLE HOMES	MONUMENT TIE MAP WINDCHIME PHASE 3	 Consulting Engineers Planners Surveyors 8600 W. Charleston Blvd. Suite 140 Las Vegas, Nv. 89102 (702) 698-6244	Church Engineering of Nevada, Inc. No.	REVISIONS	Date Init. Appr.	Date
	Checked by CDK	File No.							
Sheet Number	Date								
OF 1	2004/02								