


MONUMENT TIE MAP

WINDCHIME — PHASE 4

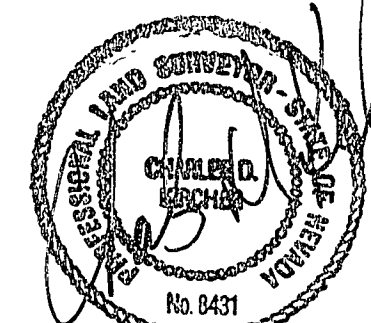

(IN FEET)
1 inch = 40 ft.

058-4219-4