


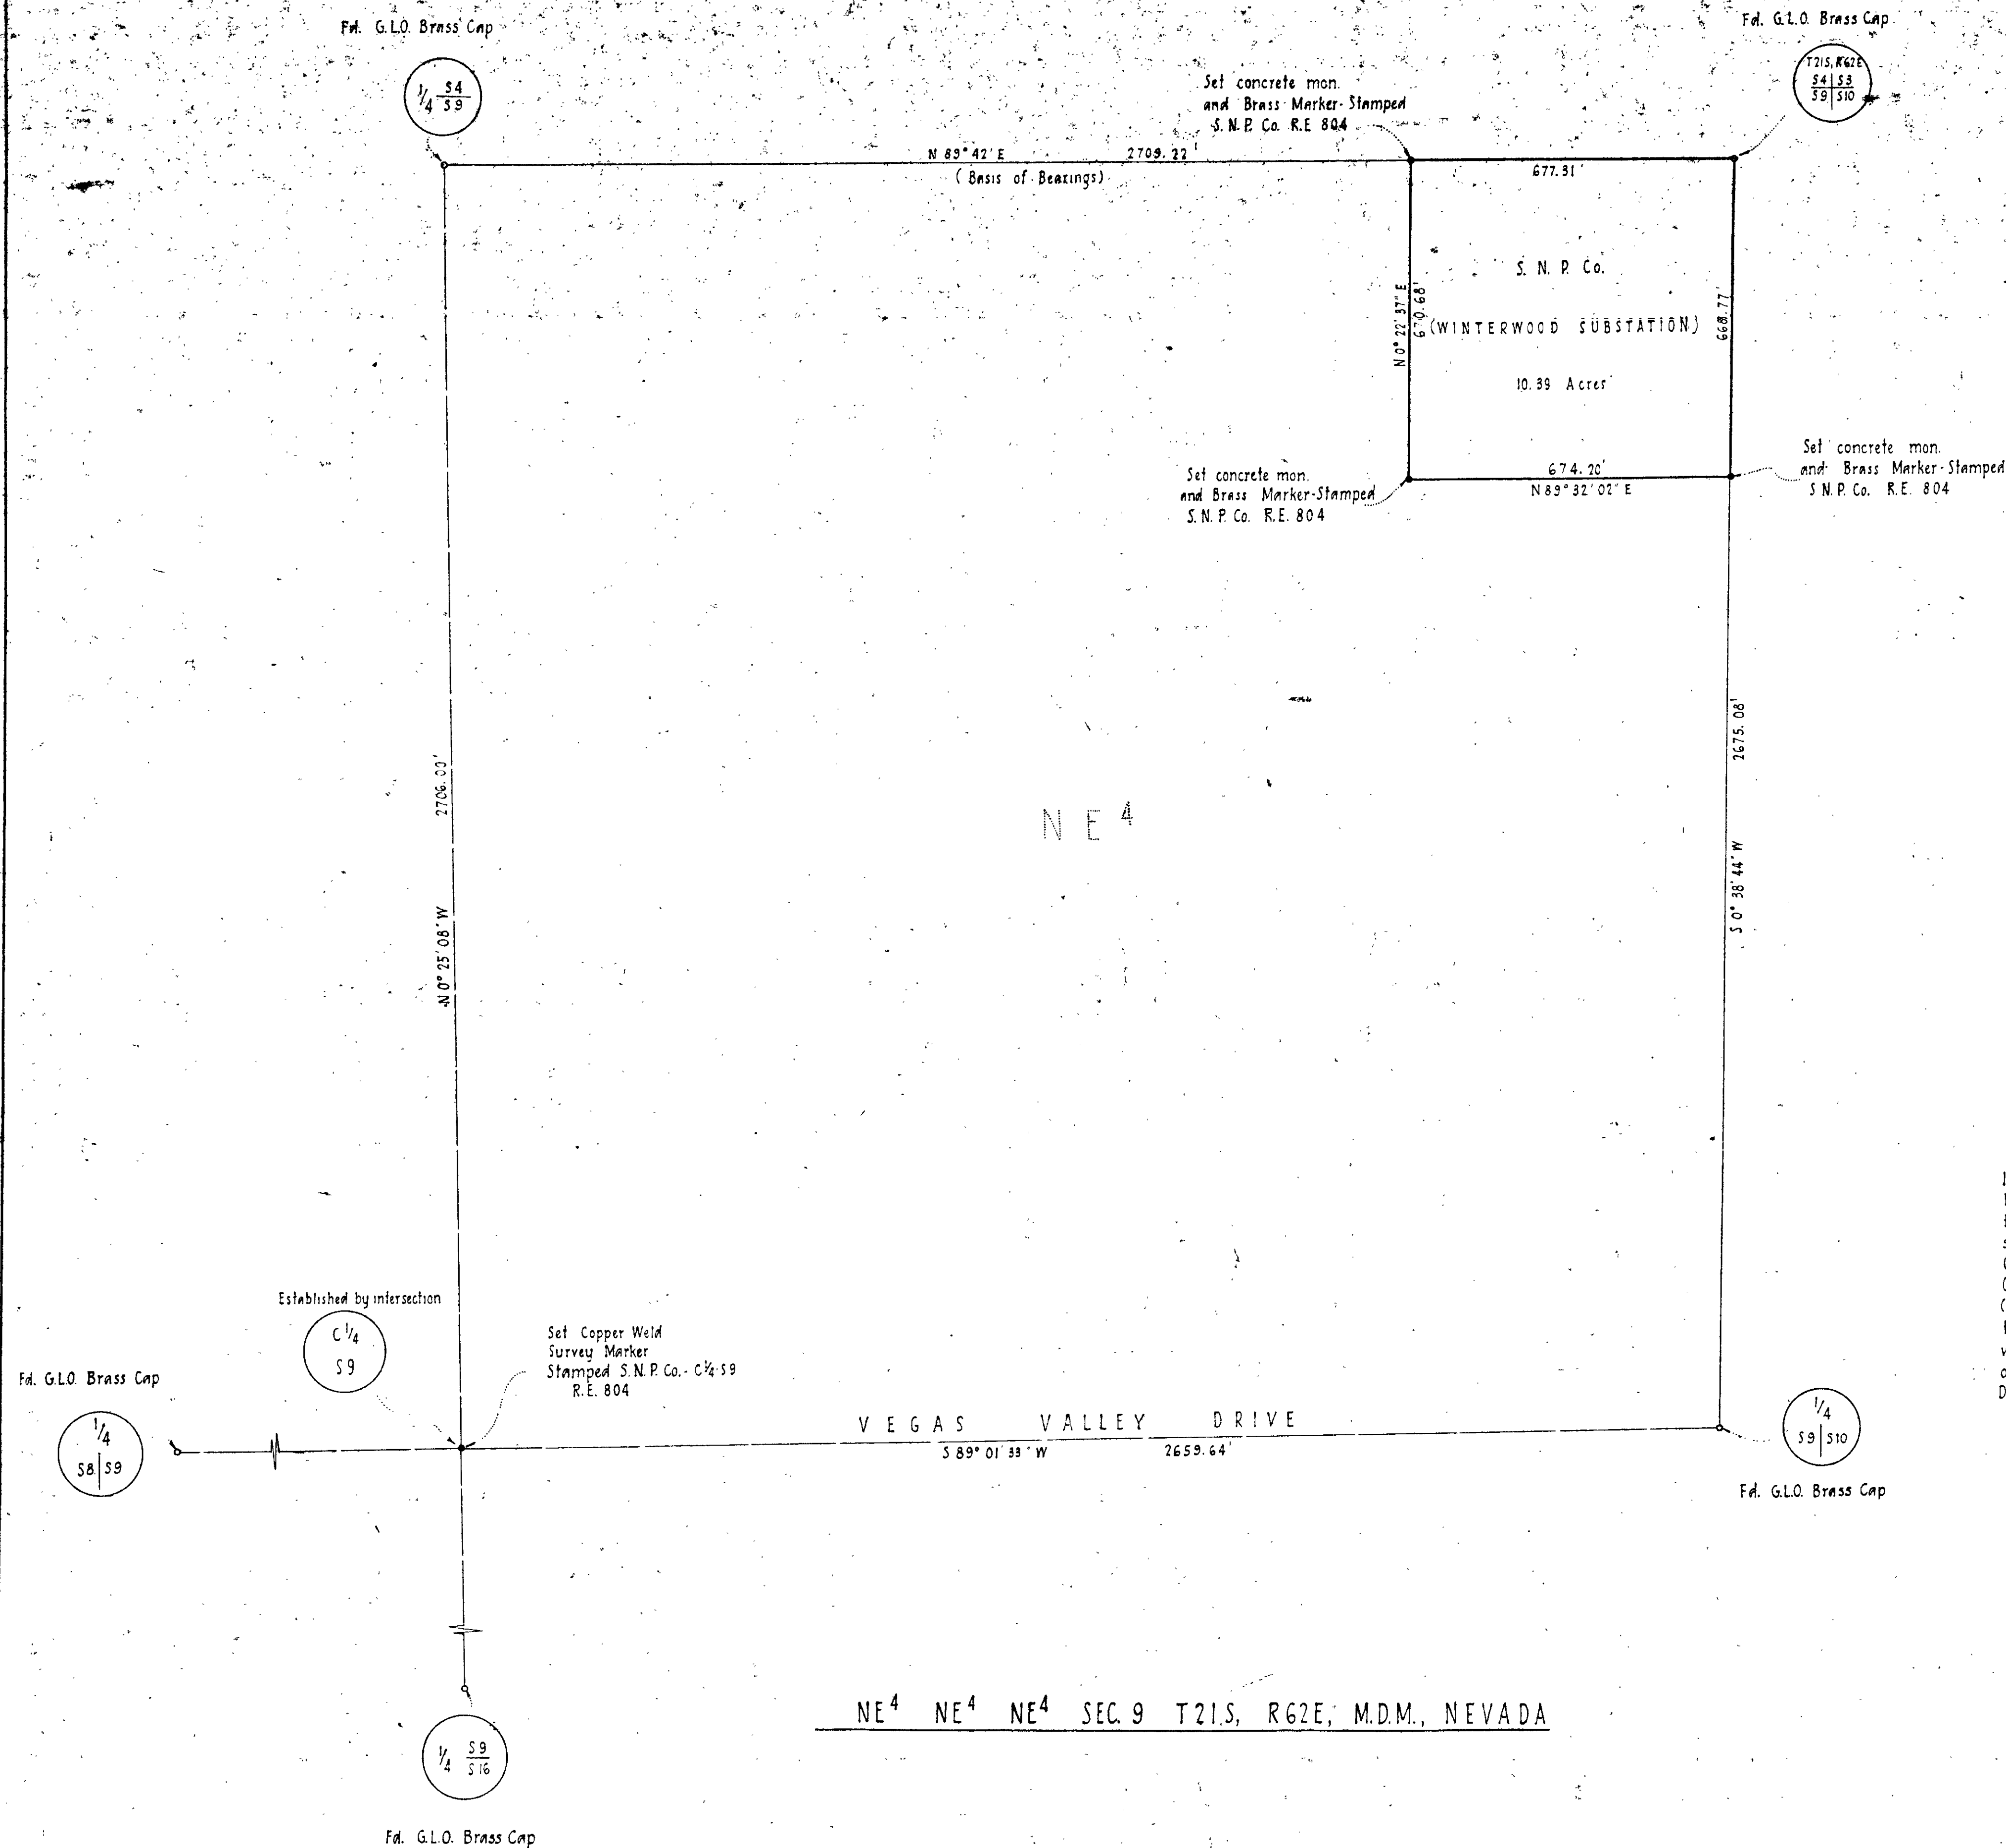

Scale: 1" = 200'

Basis of Bearings - North line of Northeast Quarter, Section 9, Township 21 South, Range 62 East, M.D.M., North 89° 42' East as established by General Land Office - Dependent Resurvey - 1943.

CERTIFICATE

I, Embree D. Wilson, a duly registered Professional Engineer and Licensed Land Surveyor of the State of Nevada do hereby certify that this map is a true and correct plat of the lands surveyed under my supervision at the instance of the Southern Nevada Power Co., a Nevada Corporation; that this survey was made in order to establish the Northeast Quarter (NE⁴) of the Northeast Quarter (NE⁴) of the Northeast Quarter (NE⁴) of Sec. 9, Township 21 South, Range 62 East, Mount Diablo Meridian; that points found and points set are as shown on the plat; that the survey was executed in accordance with requirements of Law and regulations of the Bureau of Land Management and that this survey was completed December 20, 1956.

Embree D. Wilson
Registered Eng. & Land Surveyor, Nev. # 804

NE⁴ NE⁴ NE⁴ SEC. 9 T21S, R62E, M.D.M., NEVADA

NO. 101310
FILED AT THE REQUEST OF
Southern Nevada Power Co.
Dated 3-14-57 at 11:36 A.M.
PAGE 95
Prof. Eng. Survey
CLARK COUNTY, NEVADA, RECORD
PAUL C. O'MALLEY, RECORDER
Fee \$1.22

101310
FILED AT THE REQUEST OF
Southern Nevada Power Co.
Dated 3-14-57 at 11:36 A.M.
11-23

RECORD OF SURVEY MAP

NE⁴ OF NE⁴ OF NE⁴
SEC. 9, T21S, R62E, M.D.M.

FOR

SOUTHERN NEVADA POWER CO.

CLARK COUNTY

NEVADA