

ENGINEERS CERTIFICATE

I, F. J. Gould, City Surveyor, Henderson, Clark County Nevada do hereby certify that this map is a true and accurate plot of Section 2, Township 22 South Range 62 East, M.D.B. and M. surveyed by me or under my direction and the same is true correct to the best of my knowledge and belief.


F. J. Gould
 City Surveyor, Nevada Registration No. 615

APPROVALS

Approved this 31st day of January 1961, by the City Council of the City of Henderson, Clark County, Nevada.

[Signature]
 Mayor

ATTEST *[Signature]*
 City Clerk

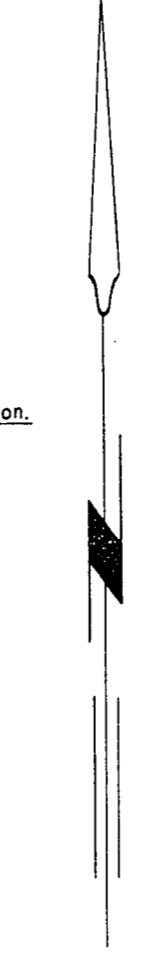

SCALE
 1" = 300'

This is not a Subdivision.

BASIS OF BEARINGS = COLORADO RIVER COMMISSION 1942

- Legend**
- ◆ Found G. L. O. Brass Cap Section Corner
 - Set C. 1/4 Cor. Monument
 - Found 1/4 Cor. Monument
 - Set 1/16 Cor. Monument

No. 279308
 FILED AT THE REQUEST OF
City of Henderson
 Date 3-1-61 at 2:26 P.M.
 Fee 11.00 PAGE 6
 CLERK OF DISTRICT COURT NO. 346
 CLARK COUNTY, NEVADA, RECORDS
 PAUL C. O'WALLEY, RECORDER
 Fee \$ dh PEH Deputy

RECORD OF SURVEY MAP
 OF SECTION 2, T. 22 S.,
 R. 62 E. M. D. B. & M.
 FOR THE CITY OF HENDERSON
 CLARK COUNTY, NEVADA