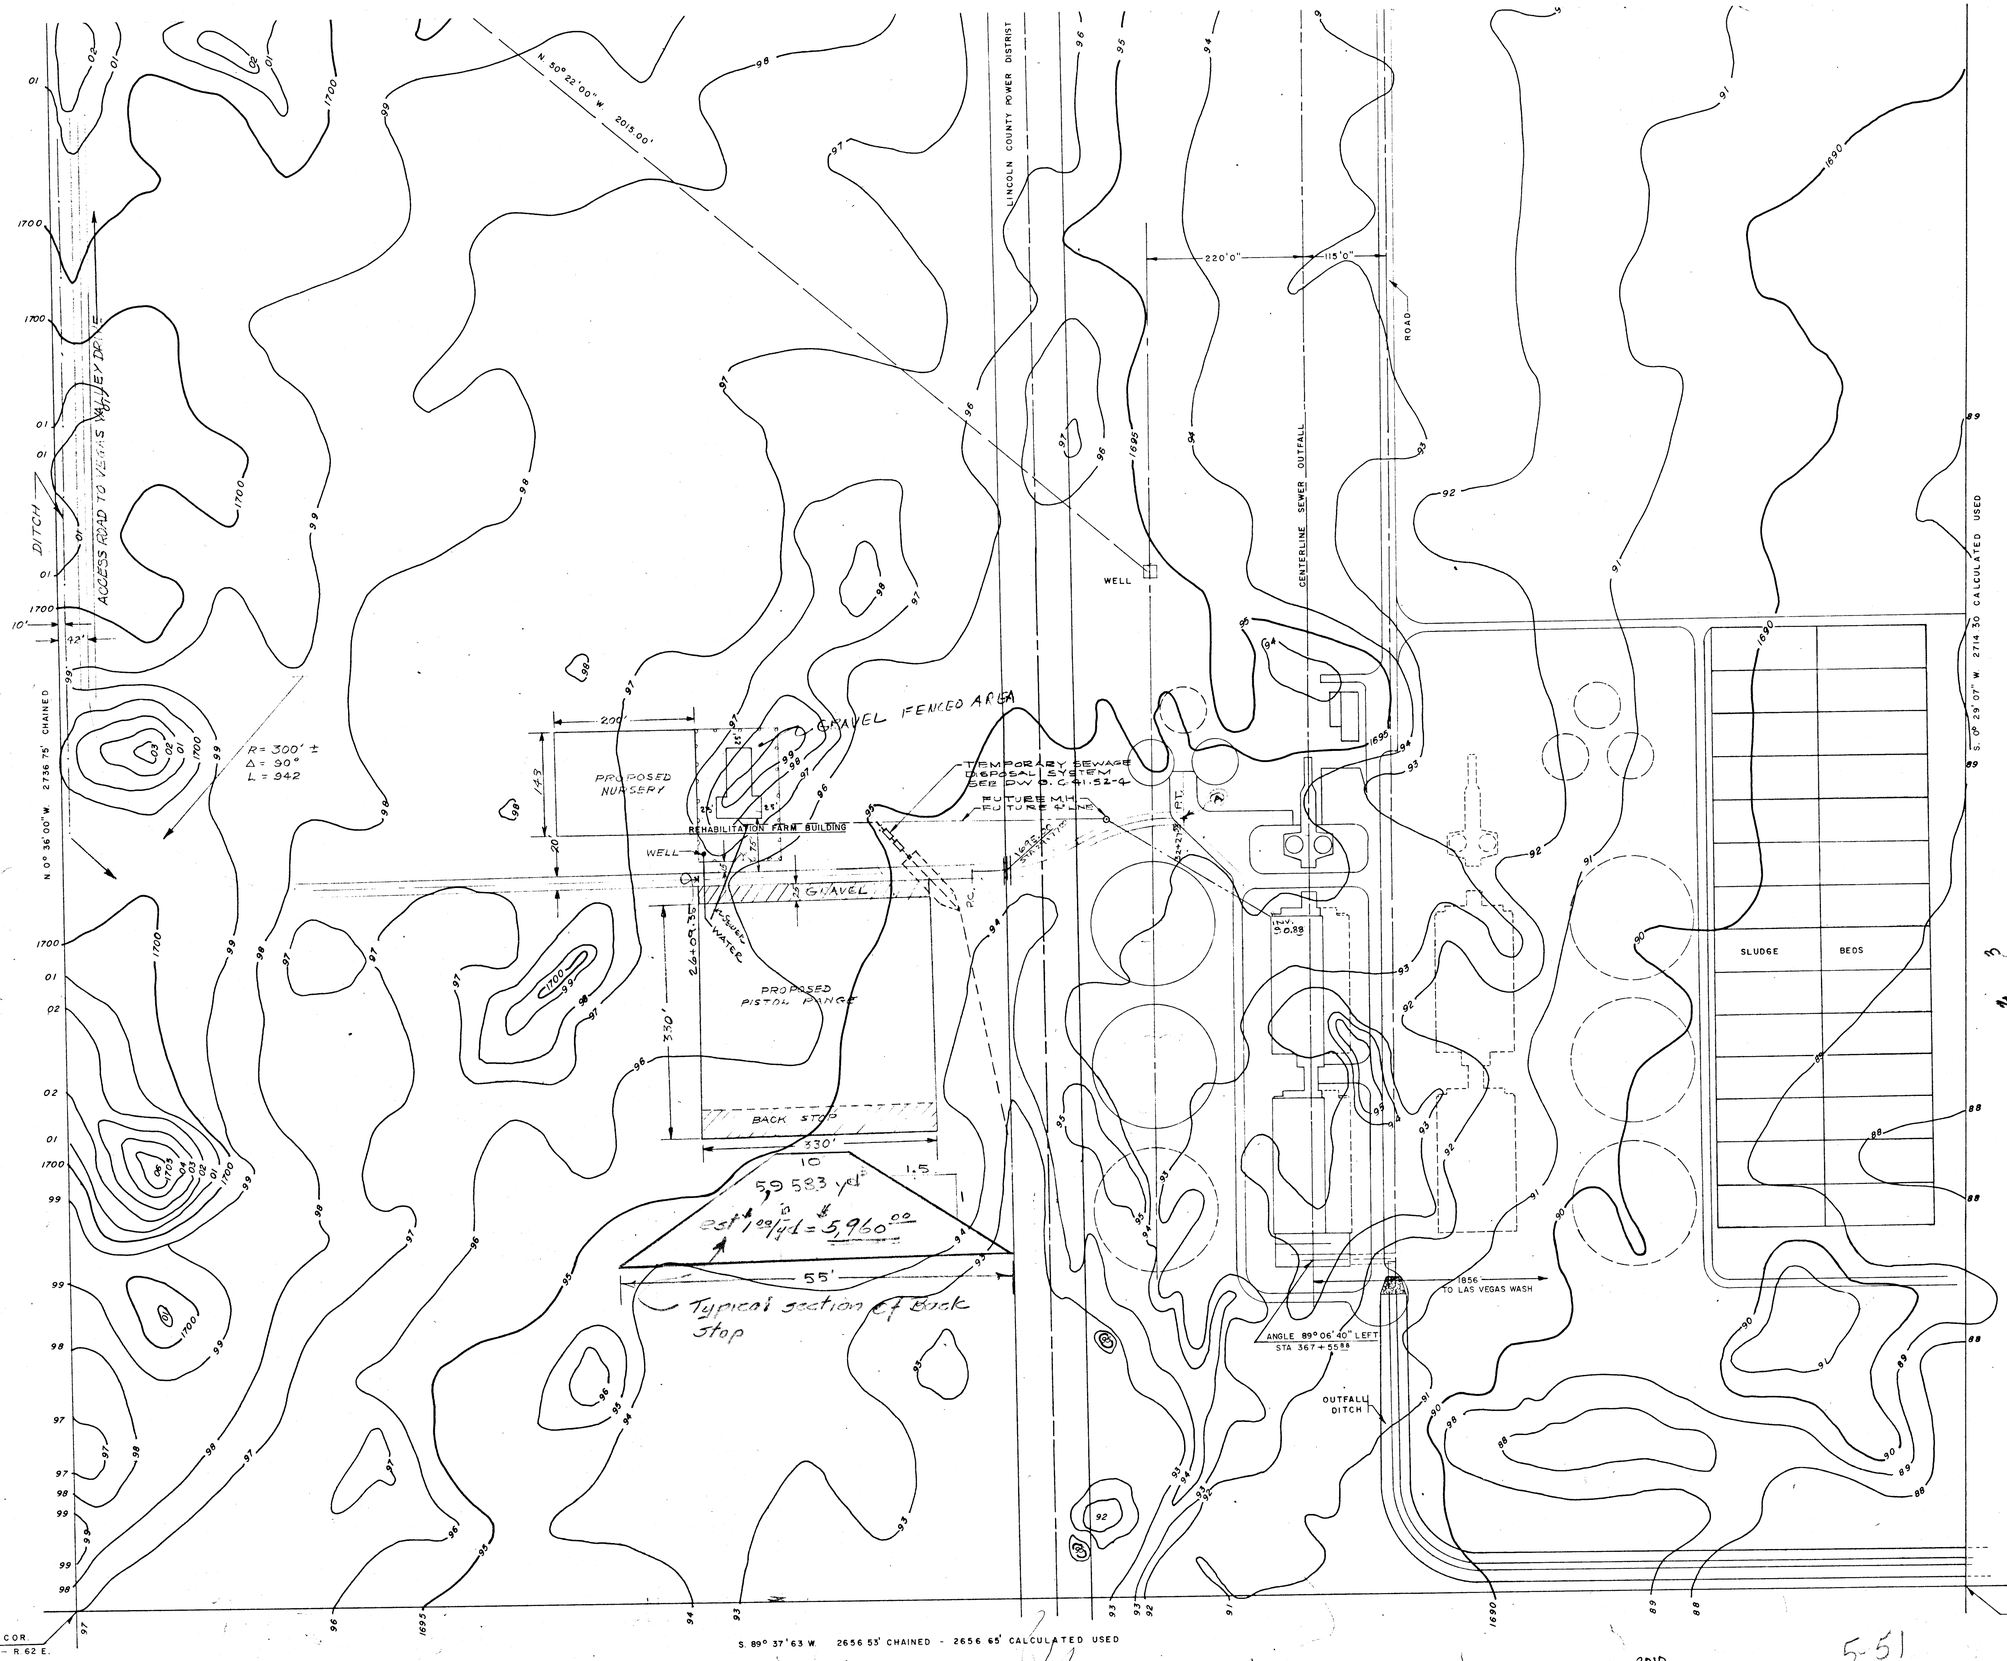

1698.0 inv. elev.

File Copy
Returned from DCA
no action
7-6-57

PRELIMINARY

3010

5-51

642-5
~~641.52-5~~