
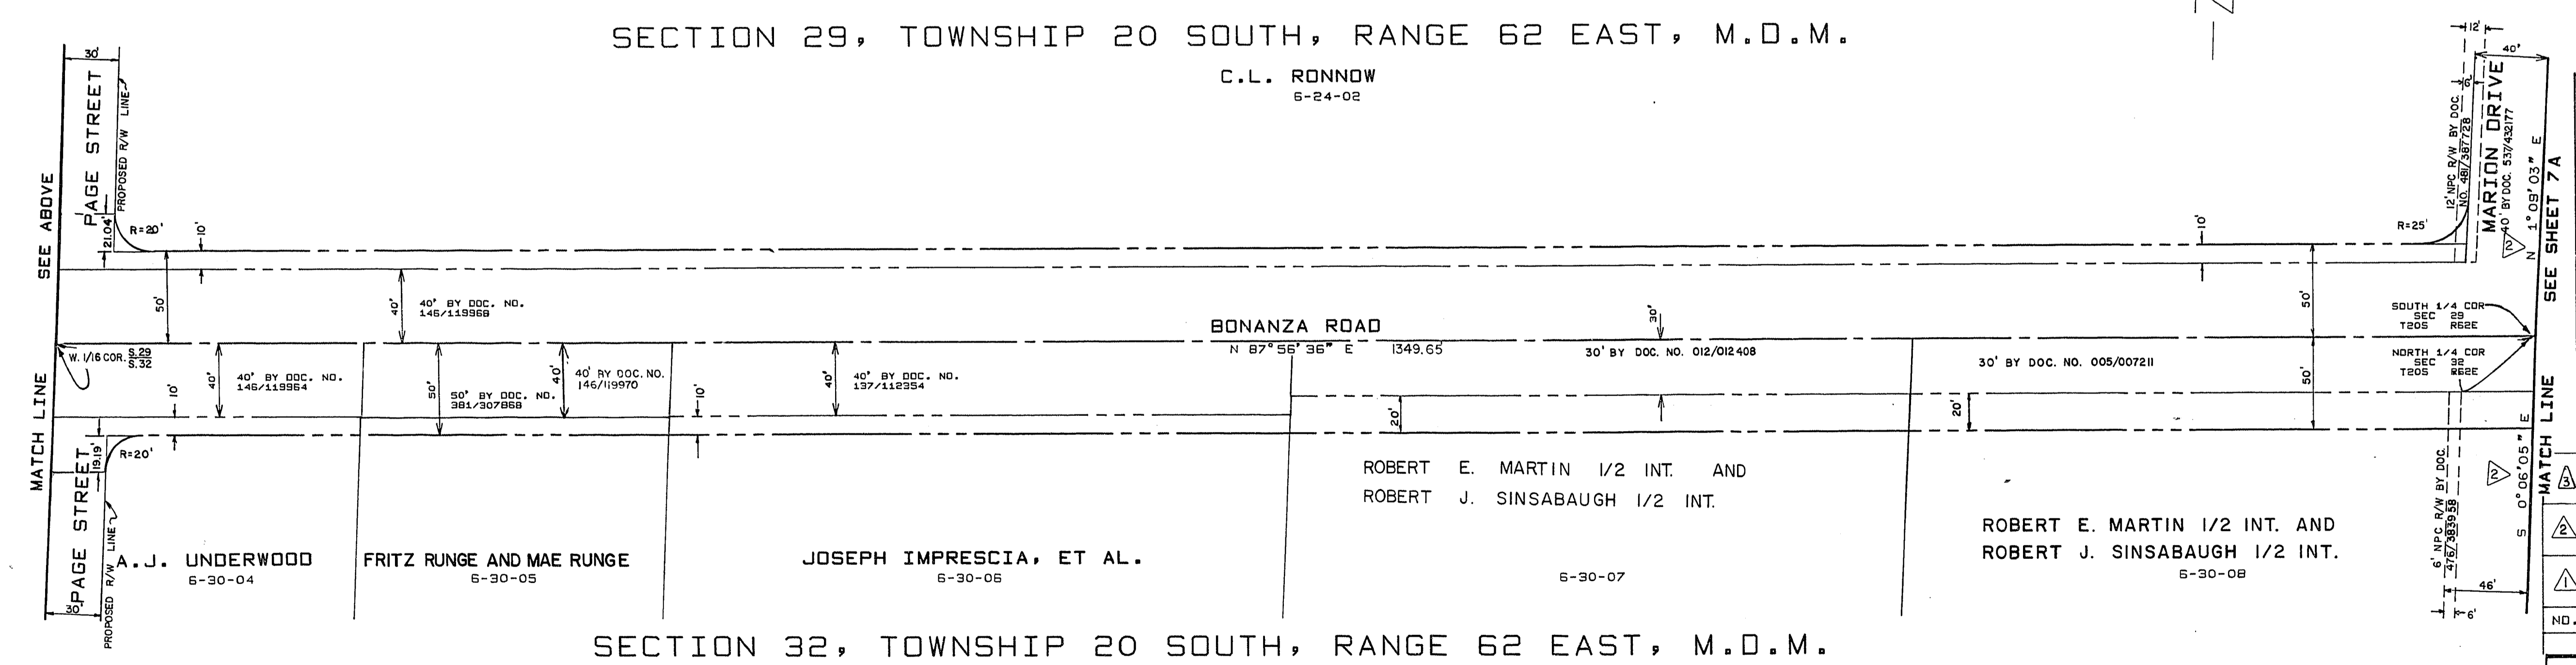


13-5-44

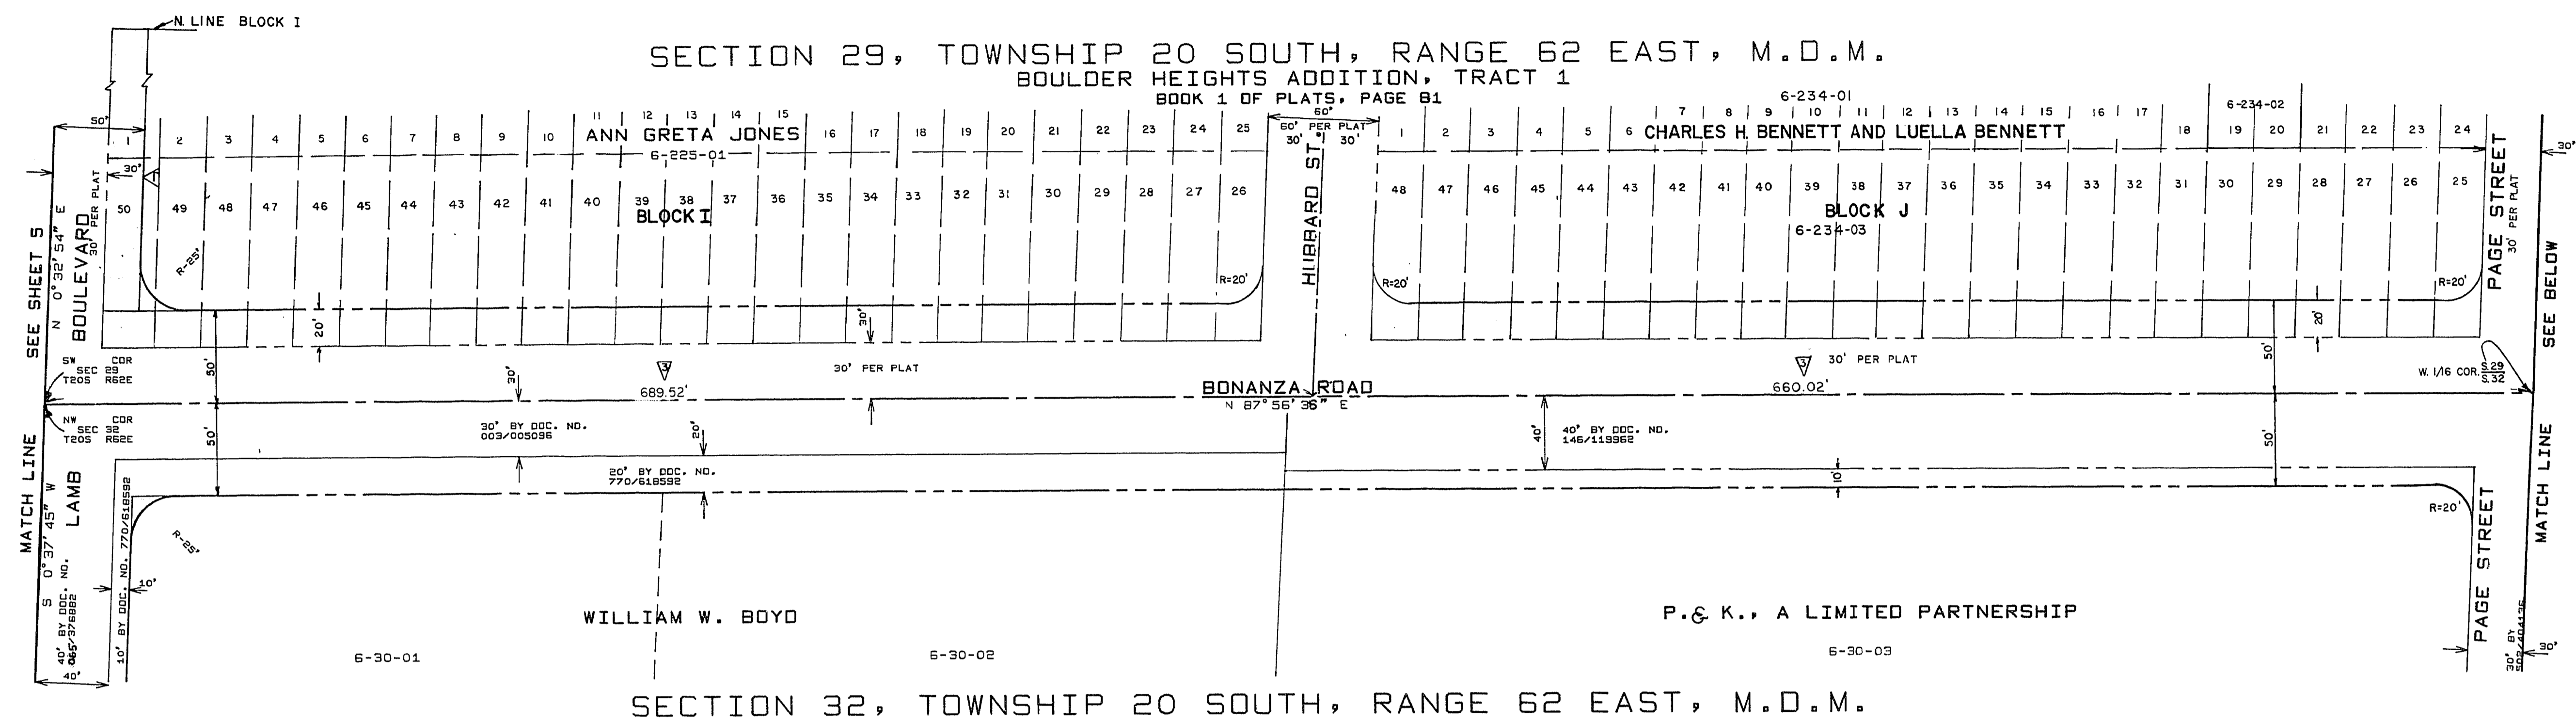

PROPERTY SCHEDULE		REMARKS
GRANTOR	AREA	DOC./DATE
ANN GRETA JONES	16295 SQ FT	384710 5/14/74
CHARLES H. AND LUELLE BENNETT	12374 SQ FT	384708 5/14/74
WILLIAM W. BOYD	120 SQ FT	375177 4/10/74
P. & K., A LIMITED PARTNERSHIP	6543 SQ FT	418159 8/20/74
C. L. RONNOW	13962 SQ FT	375171 4/10/74
A. J. UNDERWOOD	2341 SQ FT	376604 6/26/74
JOSEPH IMPRESCIA, ET AL.	3374 SQ FT	424941 10/24/74
ROBERT E. MARTIN, ET AL.	6749 SQ FT	377856 4/19/74
ROBERT E. MARTIN, ET AL.	6749 SQ FT	375743 4/26/74

**BASIS OF BEARINGS**

THE SOUTH LINE OF THE SOUTHEAST QUARTER OF SECTION 30, TOWNSHIP 20 SOUTH, RANGE 62 EAST, M.D.M., BEARING SOUTH 89° 45' 11" EAST AS PER MAP ON FILE IN RECORD OF SURVEY FILE 14 PAGE 95 IN THE OFFICE OF THE COUNTY

NO.	DESCRIPTION	BY	DATE	APPROVAL
1	CORRECTED DISTANCES TO HUBBARD ST. PRORATED PER SUBDIVISION	D.G.	7/14/75	
2	REALIGNMENT OF PORTIONS OF BONANZA ROAD	S.D.B.	4-24-75	
3	ADDITION R/W REQUIRED FOR TRANSITIONS	S.D.B.	3-23-75	

**CITY OF LAS VEGAS NEVADA**  
 DEPARTMENT OF PUBLIC WORKS  
 SERVICES DIVISION

**RIGHT OF WAY BONANZA ROAD**  
 25TH STREET TO NELLIS BLVD.

W.O. NO. 7671	F.B.K. NO. 66-19X	DATE	DRAWING NO.
SC. (H) 1" = 50'	SC. (V) 1" = 20'		
DES. R.C.K.			FILE NO.
DR. CALCOMP 61B			115-340
APPROVED BY DIRECTOR OF PUBLIC WORKS			SHEET 6 OF 7

NO.	DESCRIPTION	BY	DATE	APPROVAL
1	UPDATE PROPERTY SCHEDULE	MWB	25 JUN. 84	

APPROVED

DATE

BY

DATE

D.P.W.

ENGR.

FIELD

R/W

SEW.

SUBD.

TRAFF.

CHK.