

93091p

00749

MONUMENT TIE MAP

ROSEWALK - UNIT 2

A PORTION OF THE NE 1/4 OF THE NW1/4 OF SECTION 29, T.20 S., R.62 E., M.D.M.,
CITY OF LAS VEGAS, CLARK COUNTY, NEVADA.

COURSE TABLE

LINE	DIRECTION	DISTANCE
L1	S75°37'02"E	23.70'
L2	N02°15'35"E (R)	4.50'
L3	S87°44'25"E	11.67'
L4	N78°30'06"E (R)	16.00'

CURVE TABLE


CURVE	RADIUS	LENGTH	TANGENT	DELTA
C1	15.00'	23.56'	15.00'	90°00'00"
C2	25.00'	12.65'	6.48'	28°59'05"
C3	45.50'	22.66'	11.57'	28°32'10"
C4	45.50'	71.83'	45.86'	90°26'55"
C5	45.50'	60.55'	35.70'	76°14'31"
C6	45.50'	56.24'	32.35'	70°49'22"
C7	25.00'	24.90'	13.59'	57°03'53"
C8	25.00'	10.46'	5.31'	23°58'33"
C9	25.00'	14.44'	7.43'	33°05'20"
C10	15.00'	23.56'	15.00'	90°00'00"
C11	15.00'	23.61'	15.05'	90°11'55"
C12	15.00'	23.51'	14.95'	89°48'05"

RADIAL LINE TABLE

R1	S63°16'30"W	PRC
R2	N88°11'20"W	
R3	N54°39'04"W	


I, STEPHEN P. GURLIDES, A PROFESSIONAL LAND SURVEYOR IN THE STATE OF NEVADA, DO HEREBY CERTIFY THAT THE MONUMENTS HAVE BEEN SET AND THE TIE DISTANCE ESTABLISHED AS SHOWN HEREON. THIS SURVEY WAS COMPLETED ON 11-6-95

STEPHEN P. GURLIDES
NEVADA CERTIFICATION NO. 9105

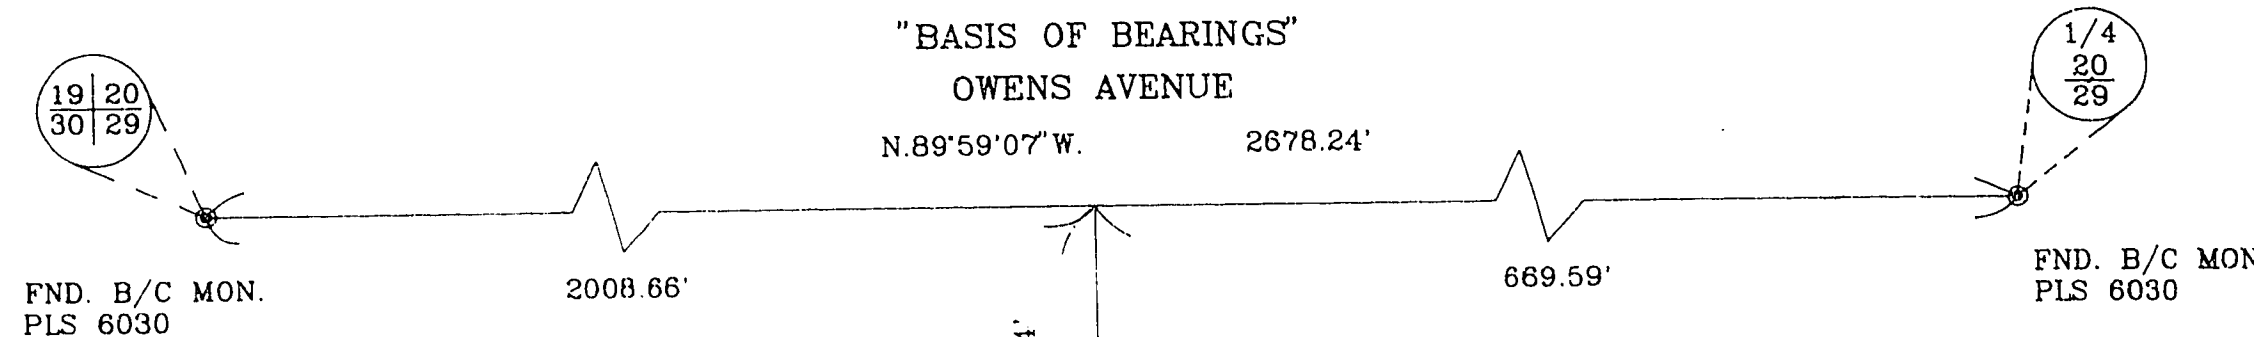

EXIST. ROSEWALK UNIT 1
BK. 57 PG. 70

FND. TYPE III MON.,
PLS 9105

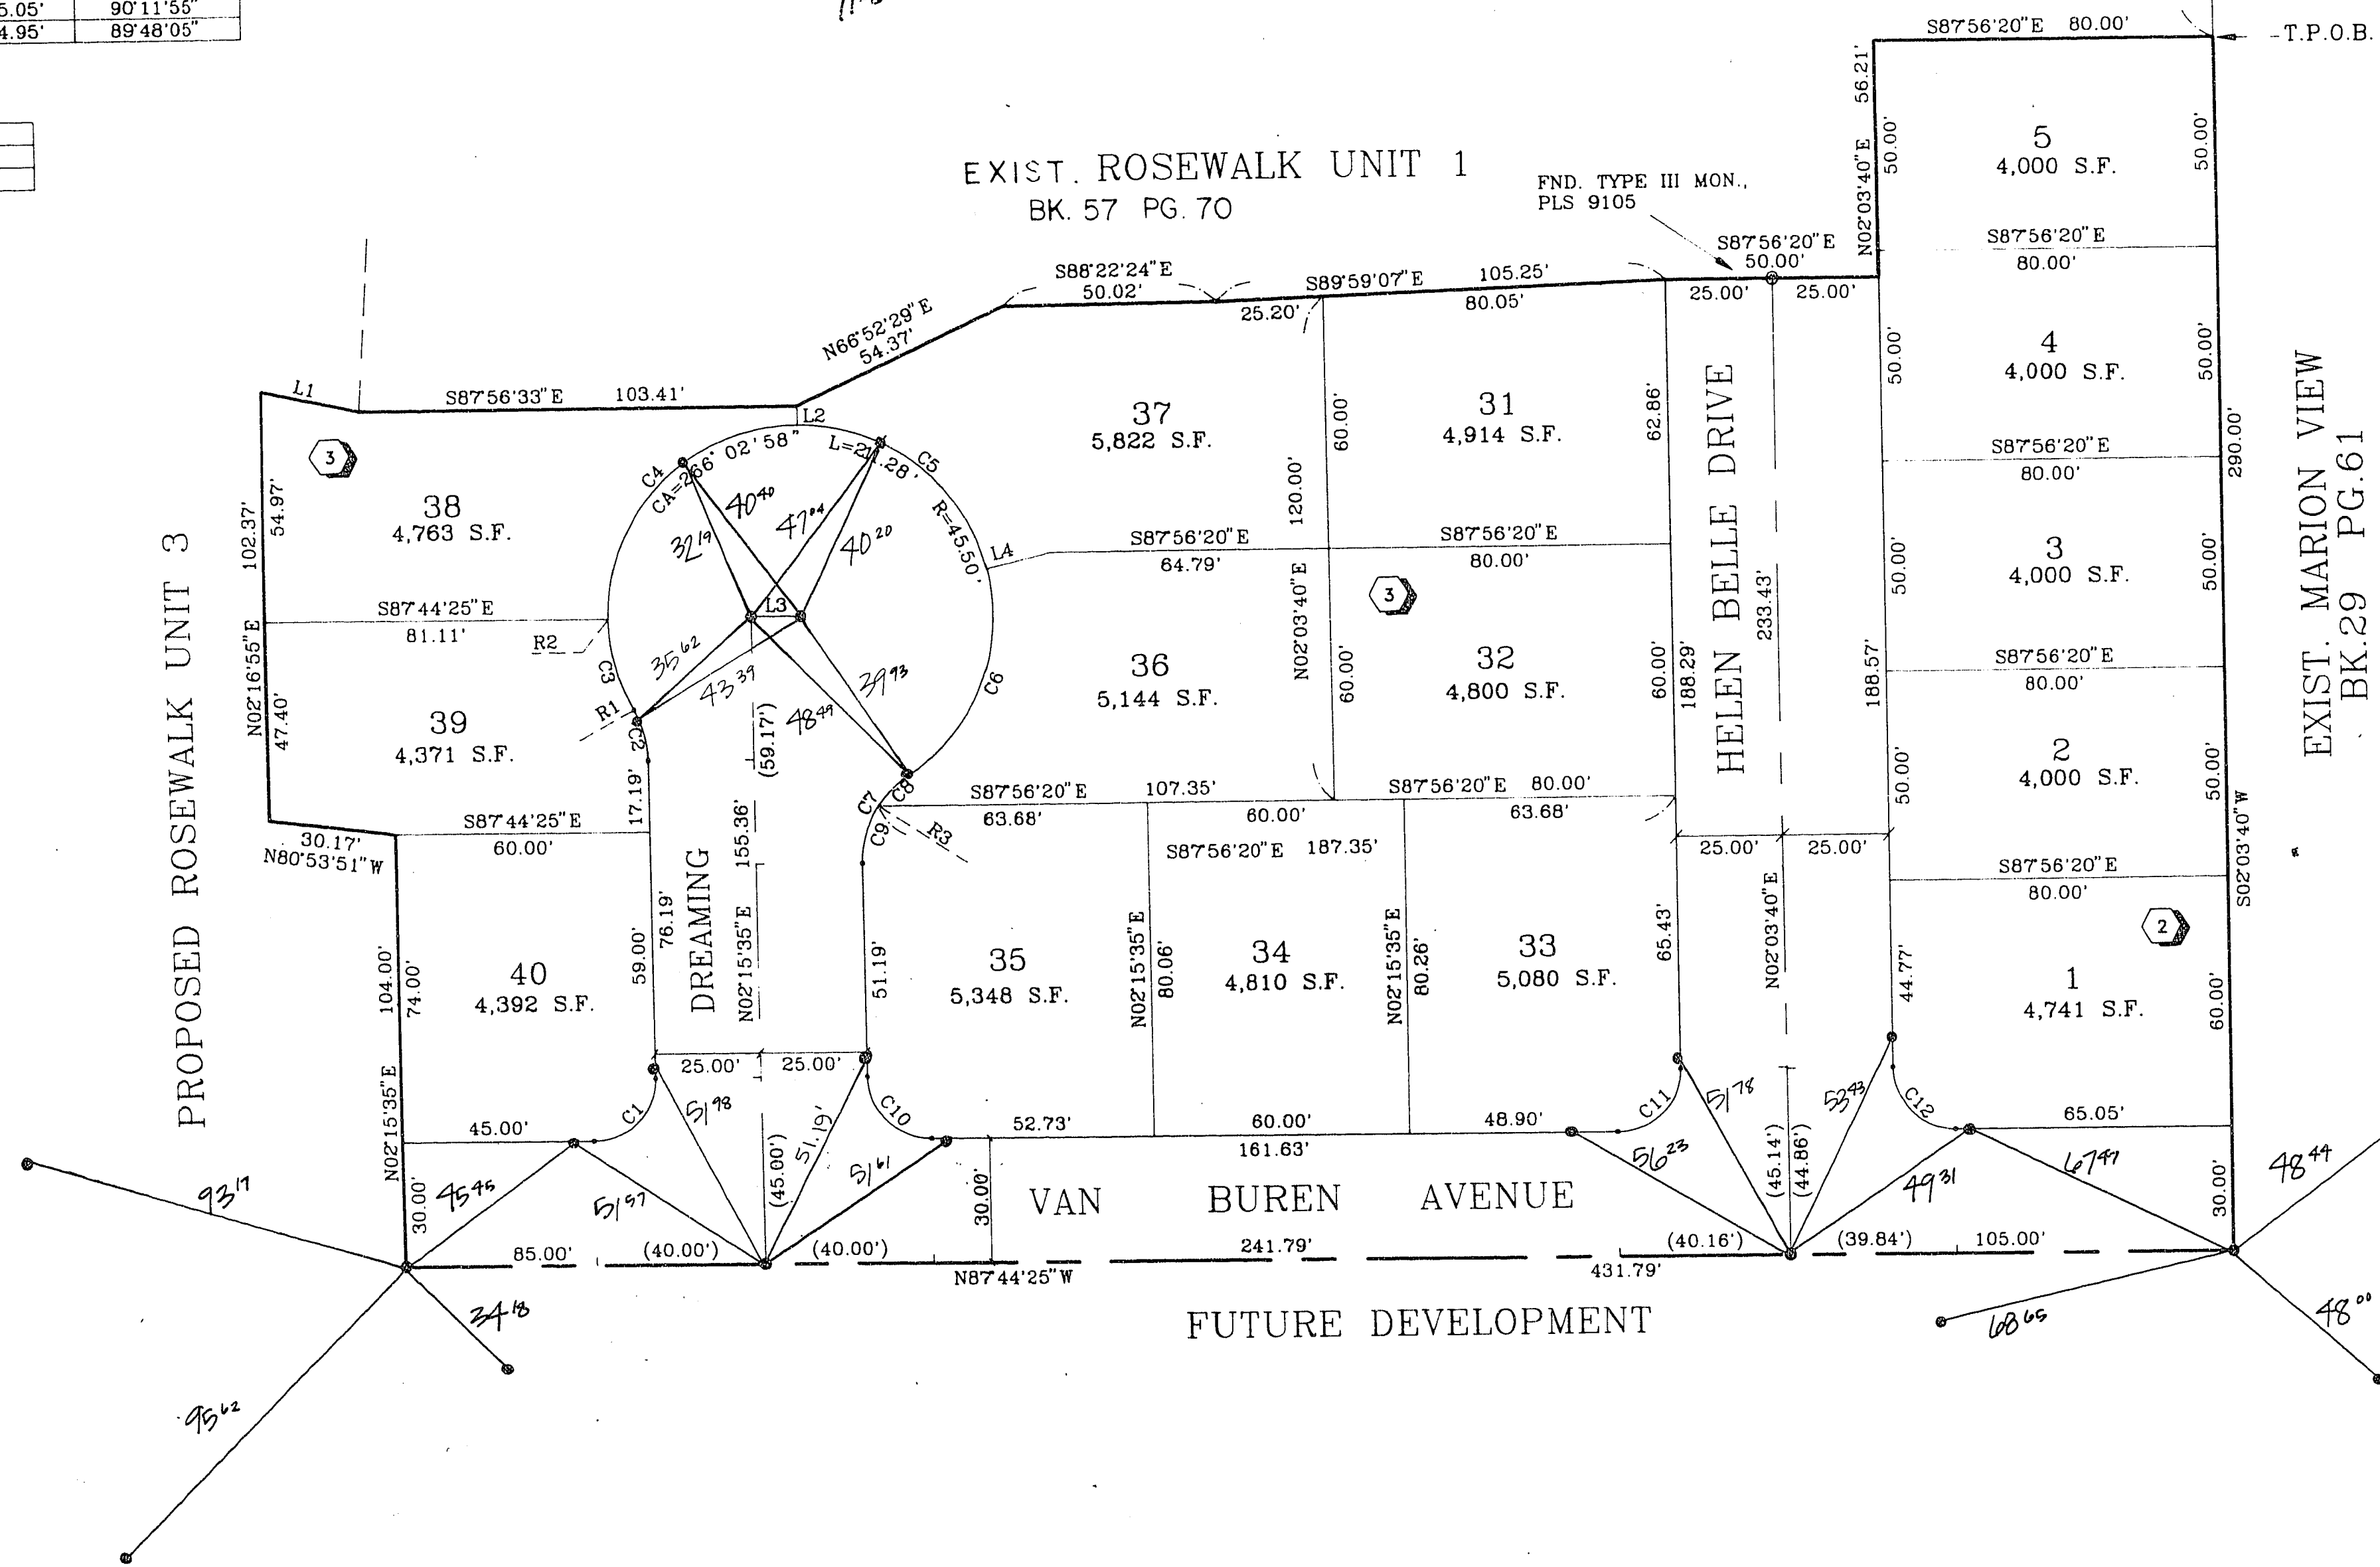

LEGEND

- T.P.O.B. TRUE POINT OF BEGINNING
- 2 LOT NUMBER / TOTAL LOTS = 15
- 3 BLOCK NUMBER
- L4 COURSE NUMBER
- C5 CURVE NUMBER
- FOUND POINT AS INDICATED
- SET TYPE III MONUMENT, PLS 9105
- (R) RADIAL LINE
- R2 RADIAL BEARING NUMBER

ACT	DATE	BY	REVISION

NOTE: PURSUANT TO NRS 278.371, ALL REAR LOT CORNERS SHALL BE SET WITH A NAIL & TAG. PLS 9105 ON BLOCK WALLS AND ALL FRONT OR SIDE CORNERS ADJOINING RIGHT-OF-WAY SHALL BE MARKED BY THE SAWCUTTING OF THE BACK OF CURBS ON THE PROLONGATION OF THE PROPERTY LINES.

W.O. 4417-2
SHEET 2 OF 2

T.Z.

Book 58 Page 42
11-6-89 058-4276-2