


940203

01332

MONUMENT TIE MAP

ROSEWALK - UNIT 6
A PORTION OF THE NE1/4 OF THE NW1/4 OF SECTION 29, T.20S., R.62E., M.D.M.,
CITY OF LAS VEGAS, CLARK COUNTY, NEVADA.

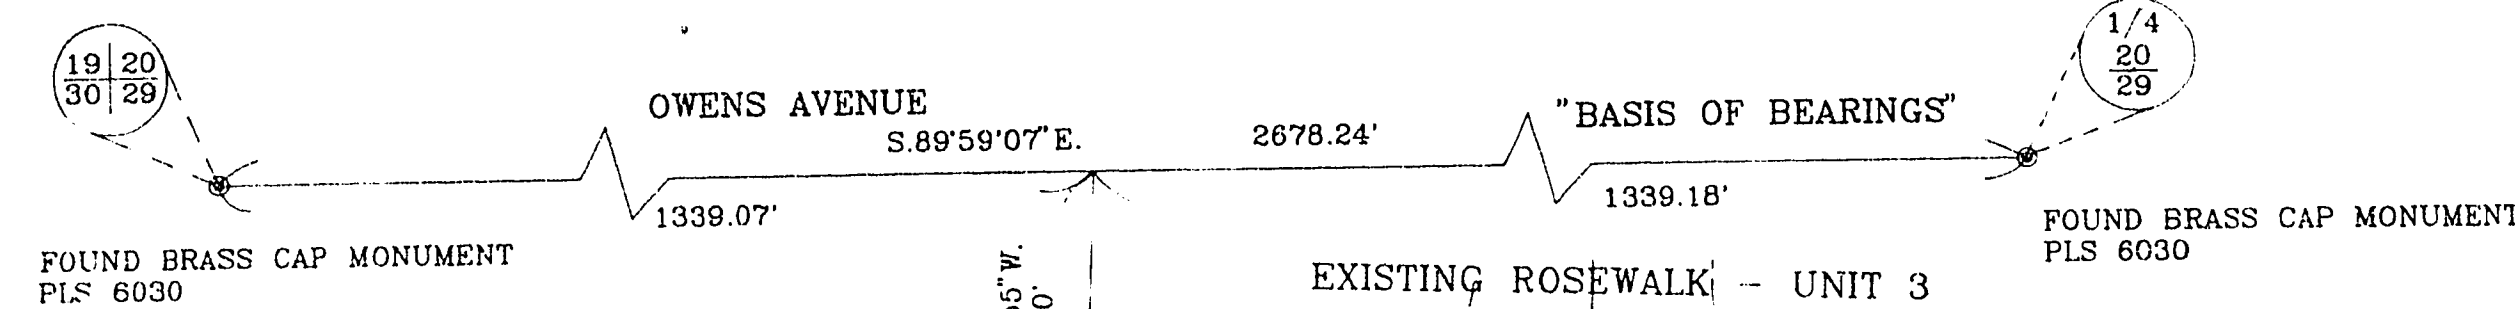

I, STEPHEN P. GURLIDES, A PROFESSIONAL LAND SURVEYOR IN THE STATE OF NEVADA, DO HEREBY CERTIFY THAT THE MONUMENTS HAVE BEEN SET AND THE TIE DISTANCE ESTABLISHED AS SHOWN HEREON. THIS SURVEY WAS COMPLETED ON

STEPHEN P. GURLIDES
NEVADA CERTIFICATION NO. 9105

COURSE	TABLE	
LINE	DIRECTION	DISTANCE
L1	S87°56'20"E	25.00'
L2	S88°44'38"W	2.23'
L3	N87°56'20"W	8.42'


RADIAL	LINE	DIRECTION
R1	PRC	N59°38'45"W
R2	PRC	S26°00'41"E

CURVE	RADIUS	LENGTH	TANGENT	DELTA
C1	15.00'	23.57'	15.01'	90°01'19"
C2	25.00'	12.25'	6.25'	28°04'21"
C3	60.00'	153.27'	198.51'	148°21'56"
C4	25.00'	12.25'	6.25'	28°04'21"
C5	60.00'	39.26'	20.36'	37°29'33"
C6	60.00'	41.16'	21.43'	39°18'28"
C7	60.00'	42.10'	21.96'	40°12'00"
C8	60.00'	30.75'	15.72'	29°21'56"
C9	25.00'	39.37'	25.10'	90°13'14"
C10	15.00'	23.56'	14.99'	89°58'41"

NOTE

PURSUANT TO NRS 278.371 ALL REAR LOT CORNERS SHALL BE SET WITH A NAIL AND TAG "PLS 9105" ON BLOCK WALLS AND ALL FRONT OR SIDE LOT CORNERS ADJOINING RIGHT-OF-WAY SHALL BE MARKED BY THE SAWCUTTING OF THE BACK OF CURBS ON THE PROLONGATION OF THE PROPERTY LINES.

ACT	DATE	BY	REVISION

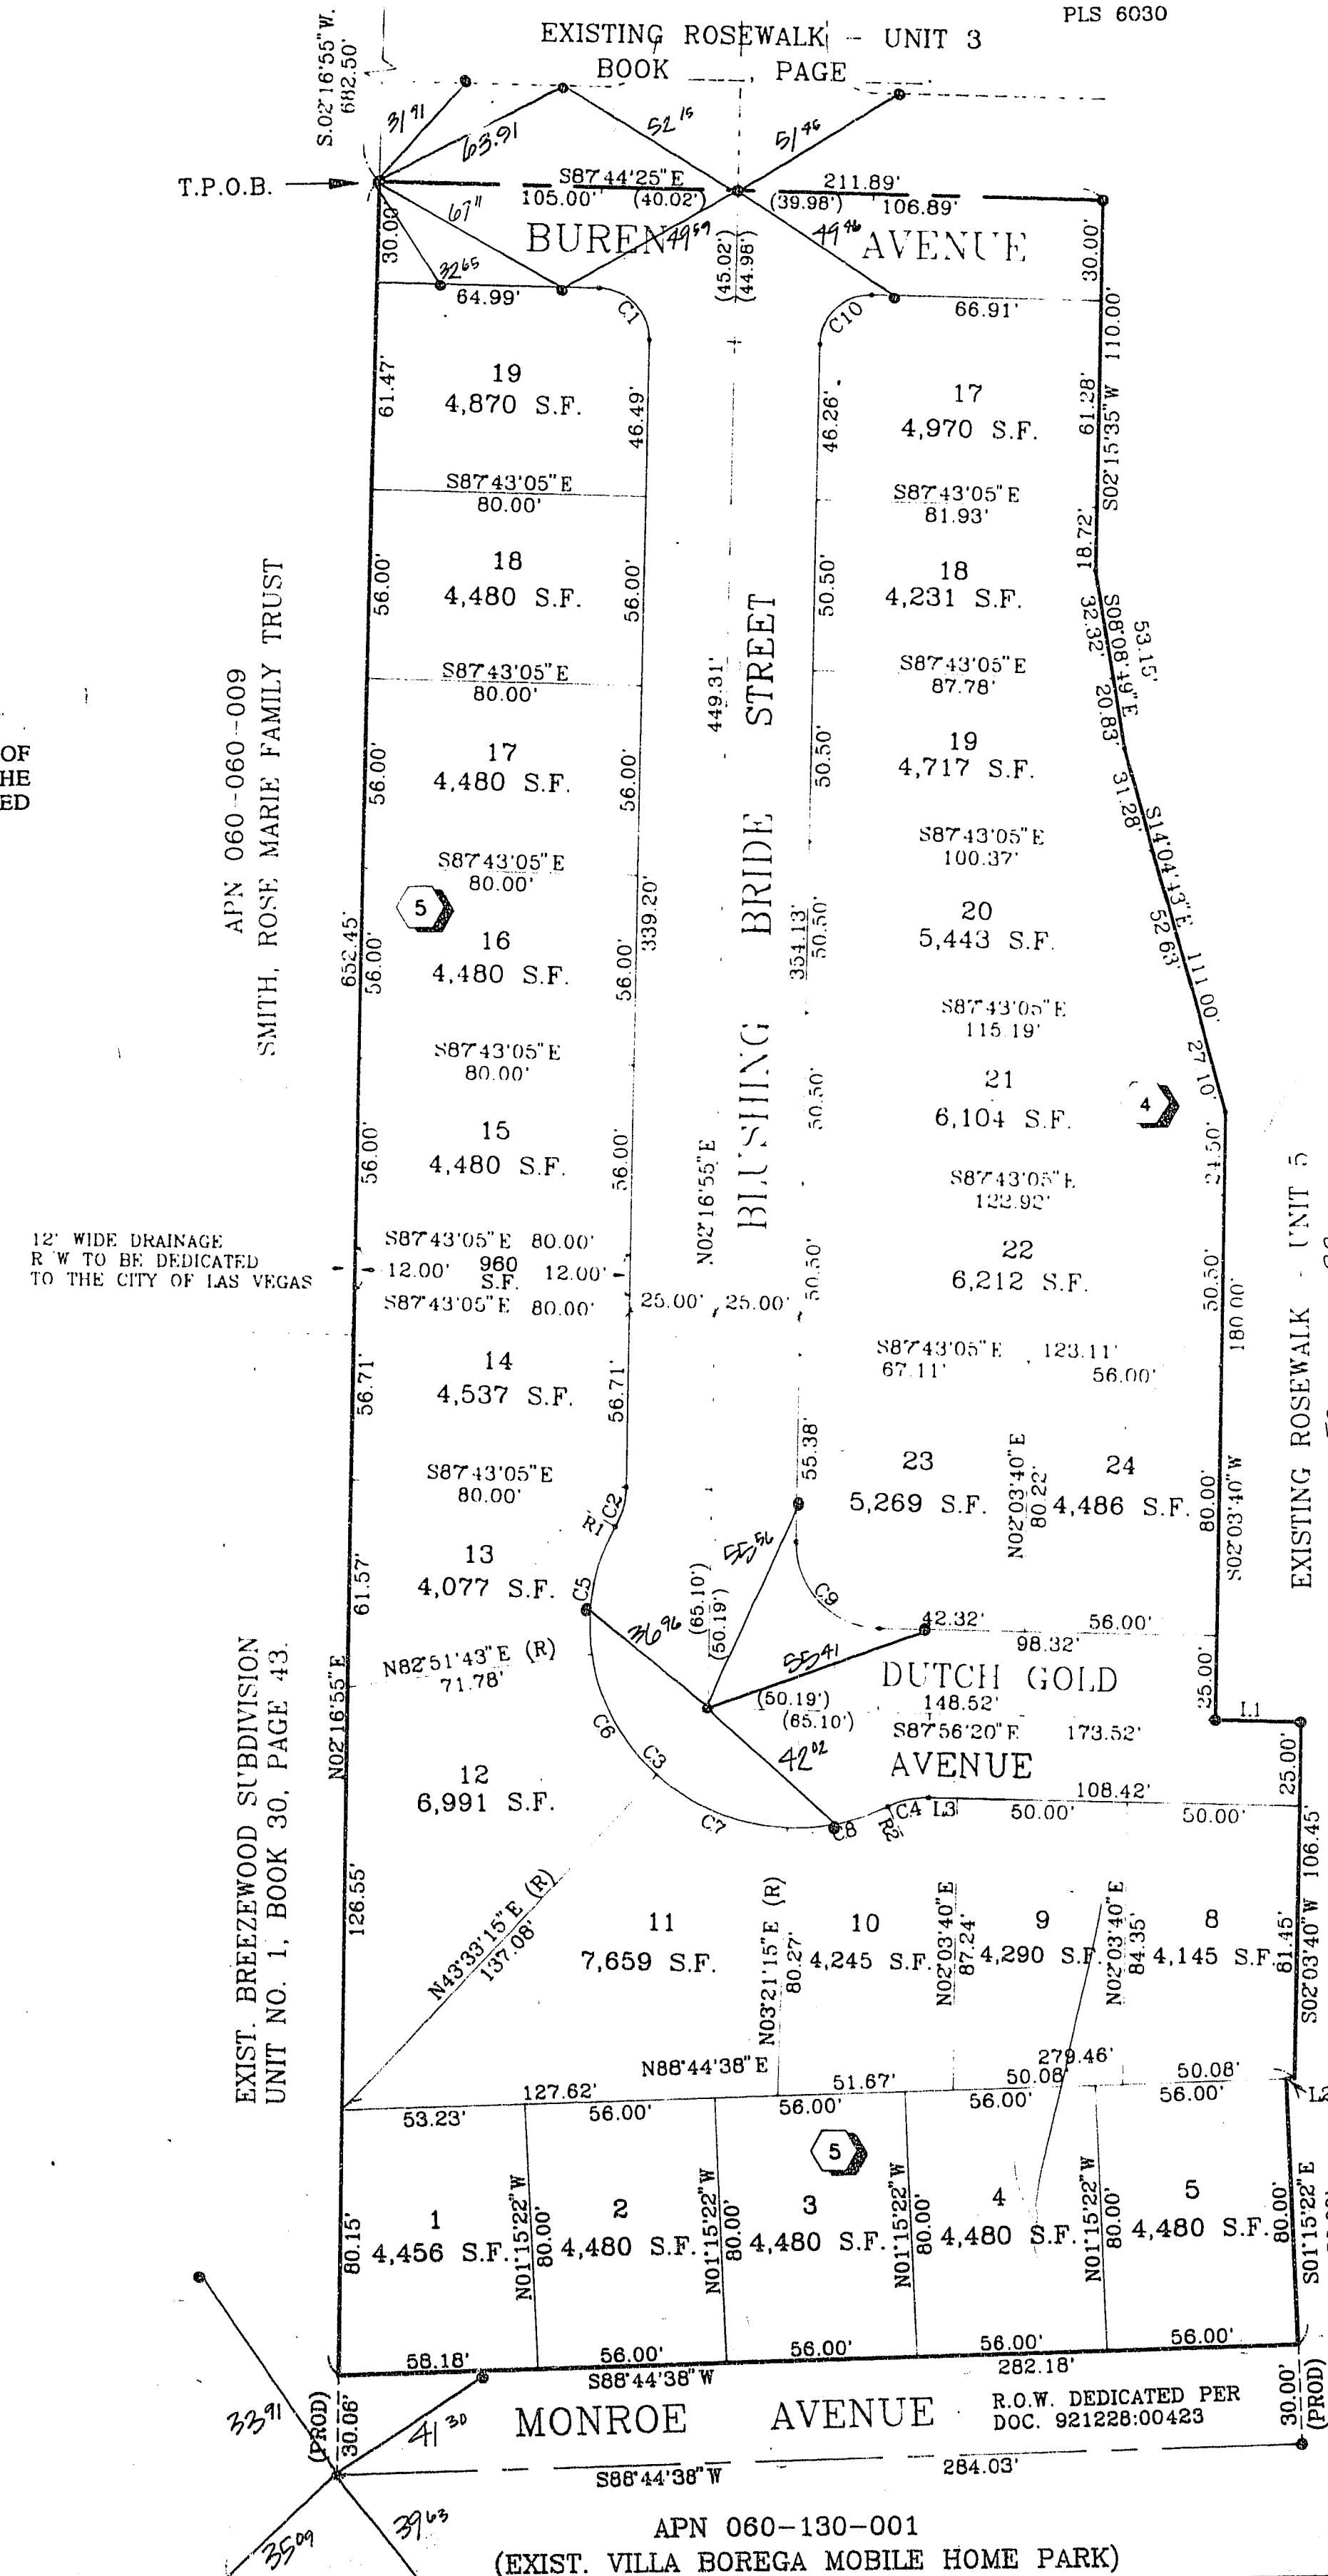

LEGEND

T.P.O.B.	TRUE POINT OF BEGINNING
2	LOT NUMBER / TOTAL LOTS = 25
②	BLOCK NUMBER
14	COURSE NUMBER
C5	CURVE NUMBER
●	FOUND TYPE III MONUMENT, PLS 9105 (UNLESS OTHERWISE INDICATED)
●	SET TYPE III MONUMENT, PLS 9105
(R)	RADIAL LINE
R2	RADIAL BEARING NUMBER

W.O. 4417-II-8
SHEET 2 OF 2

BOOK 60 PAGE 26
11-6-60
058-4276-6