
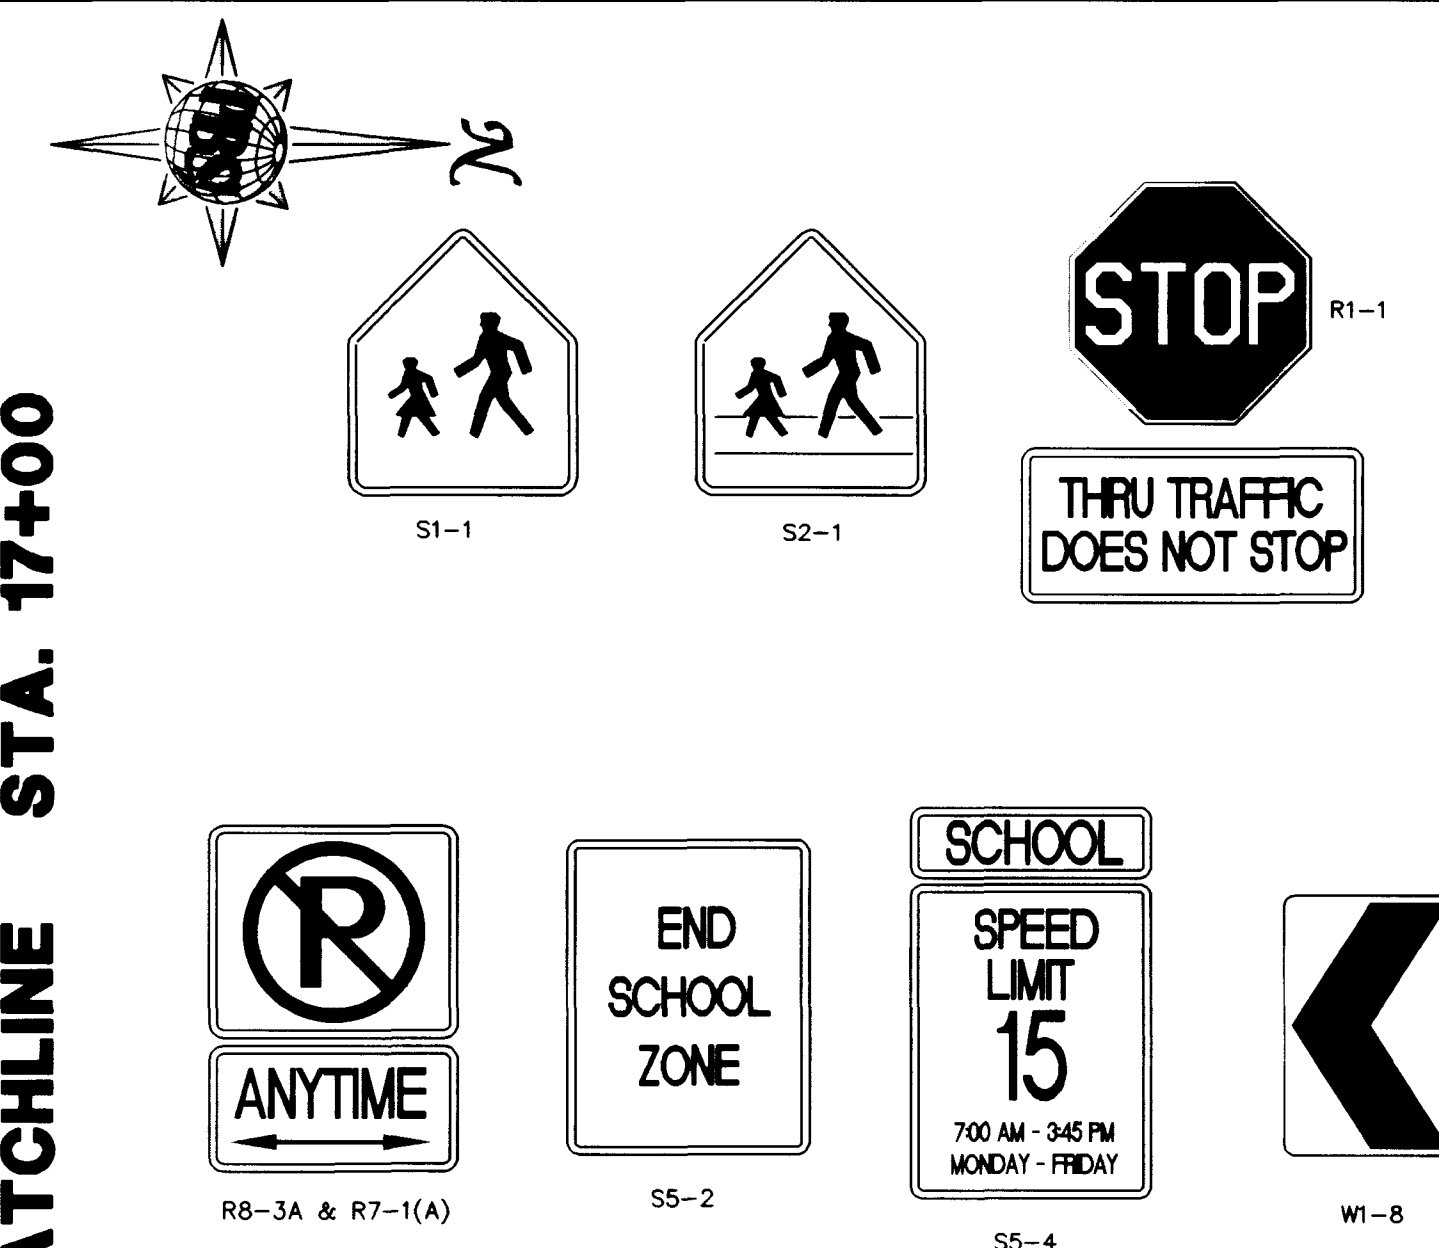


424-sgn.dwg REV 03/13/98 14:06:56 XREF: 424BASE2, PROBSE2


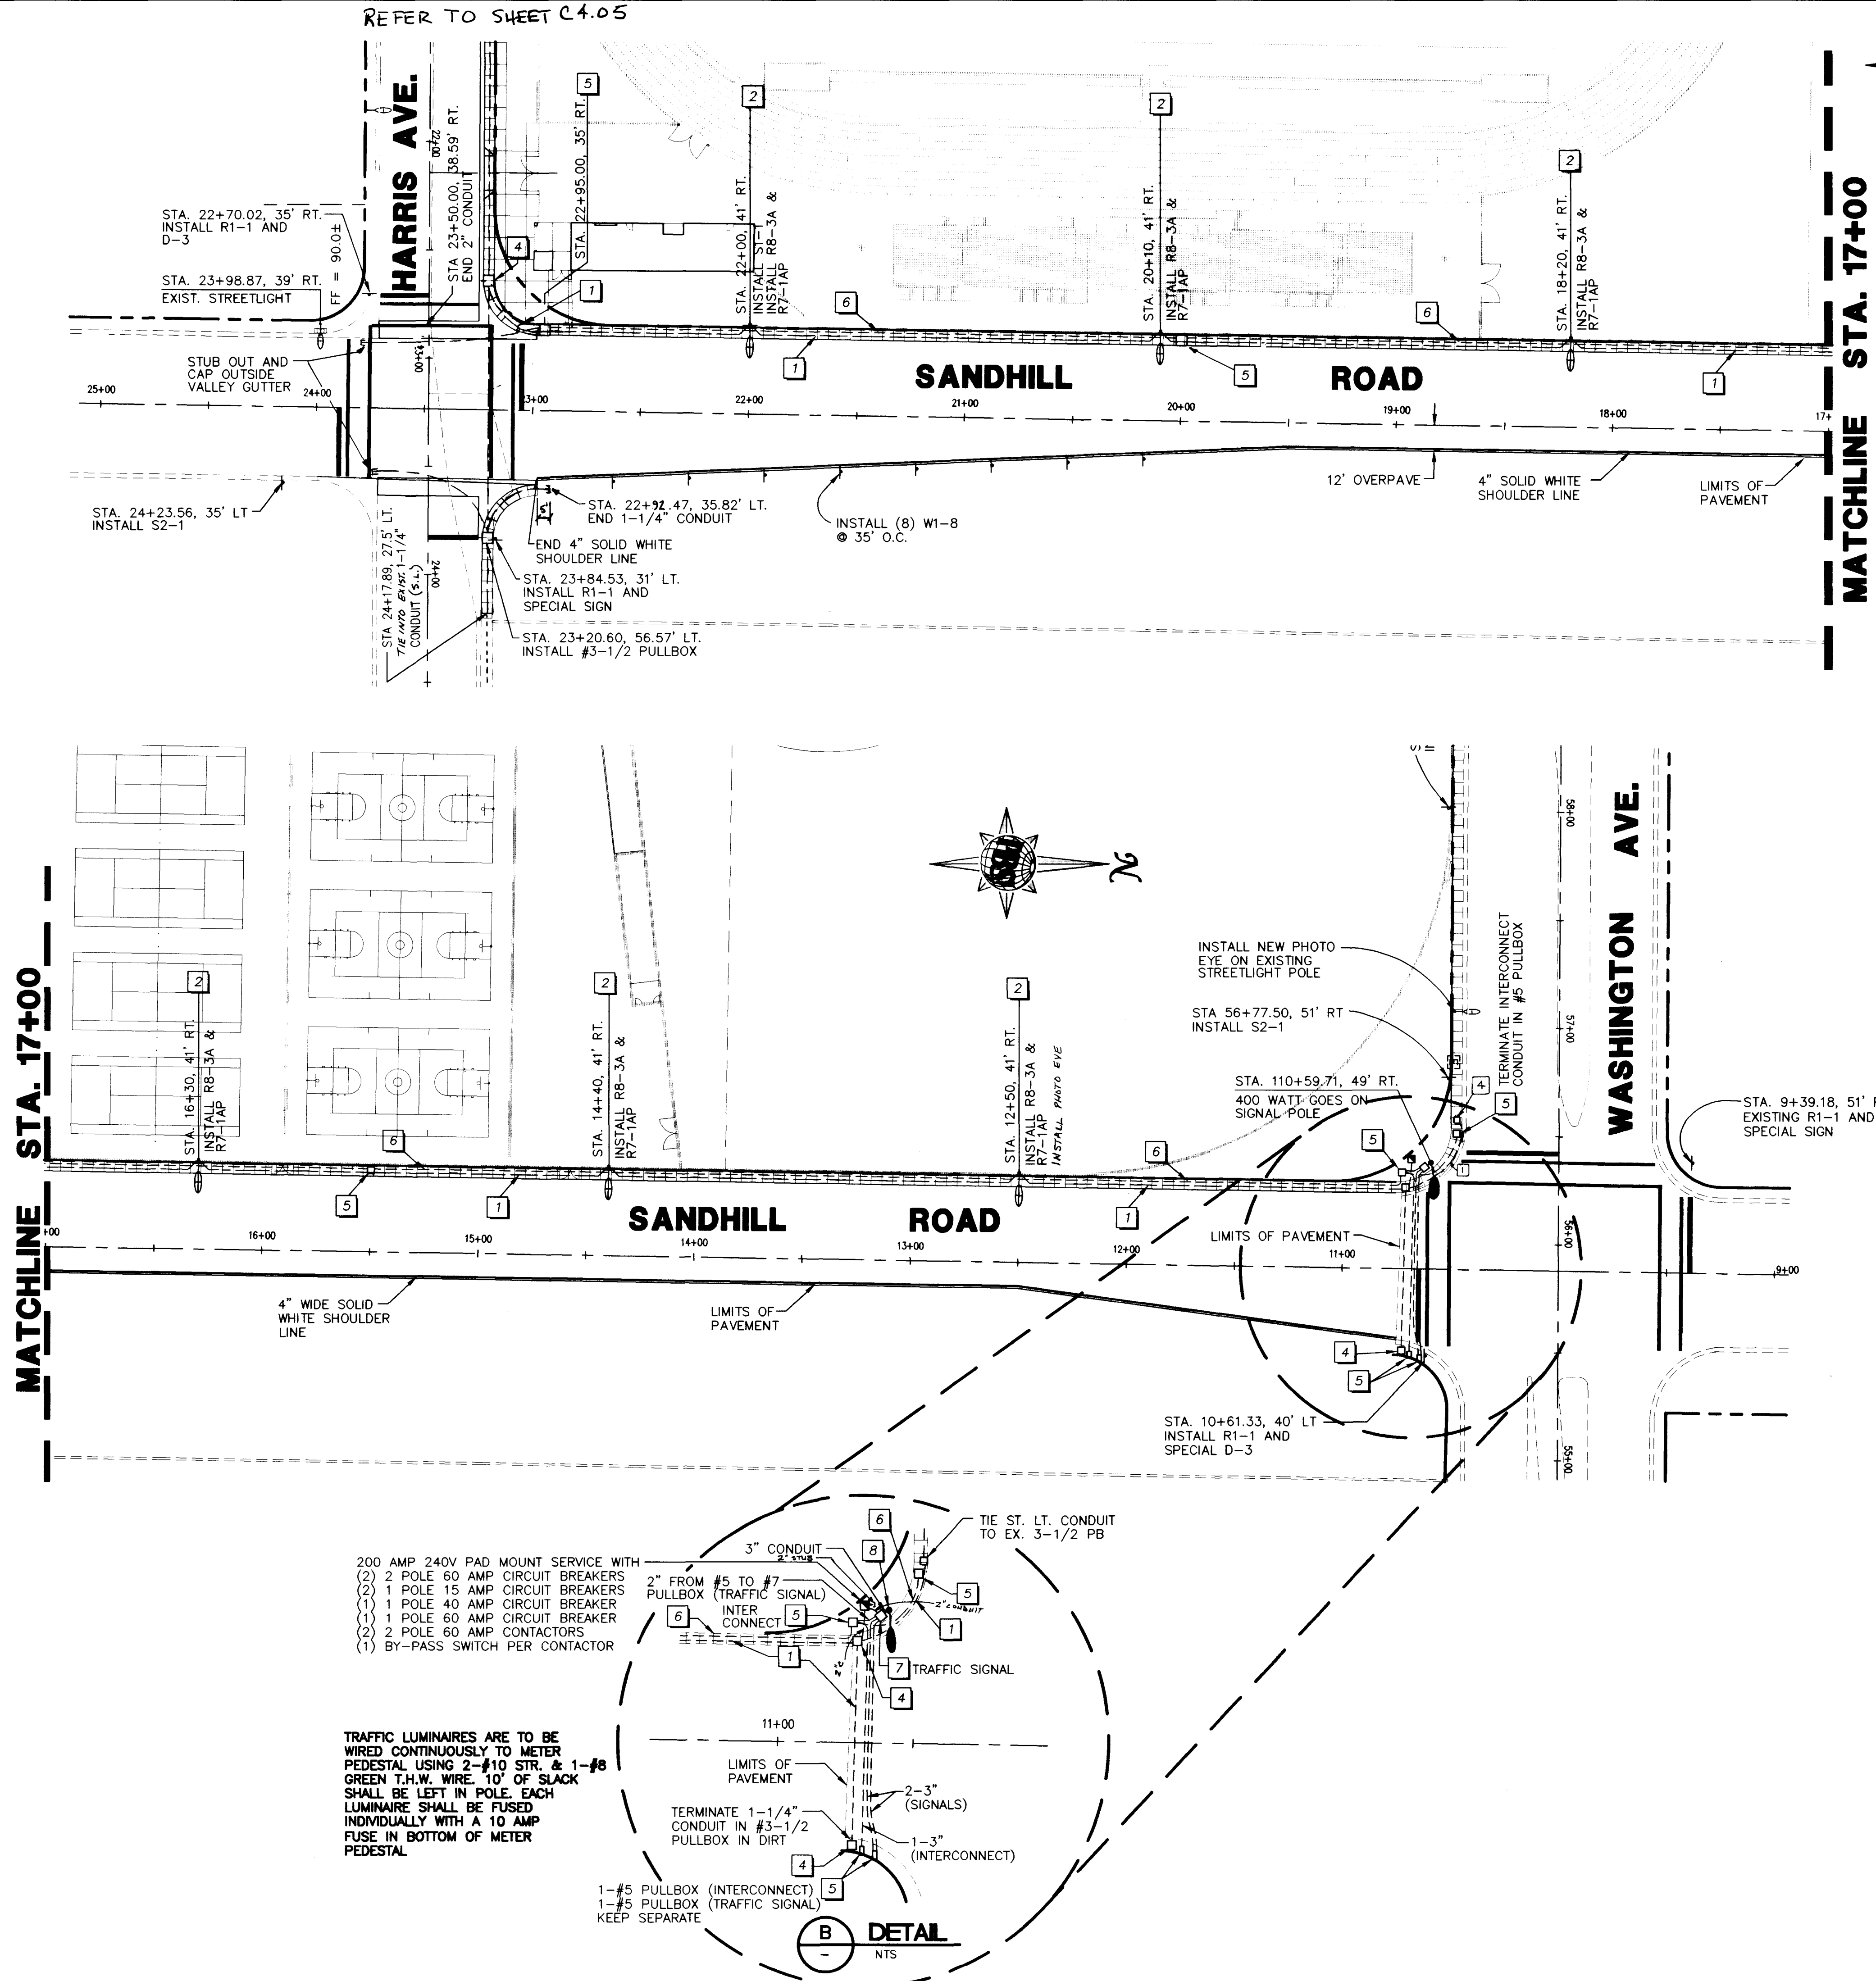


NOTE

ALL OFF-SITE SIGNAGE AND STRIPING TO BE INSTALLED BY CITY OF LAS VEGAS

CONSTRUCTION KEY NOTES

1. INSTALL 1-1/4" STREETLIGHT CONDUIT W/2-#4, 1-#8 THW. (TYP.) (BENEATH SIDEWALK, CLV STDs.)
2. INSTALL 250 WATT HIGH PRESSURE SODIUM LIGHT PER CLV STDs.
3. INSTALL 100 WATT HIGH PRESSURE SODIUM LIGHT PER CLV STDs.
4. INSTALL #3-1/2 PULLBOX
5. INSTALL #5 PULLBOX
6. INSTALL 2" TRAFFIC SIGNAL INTERCONNECT CONDUIT WITH PULLSTRING
7. INSTALL #7 PULLBOX
8. INSTALL "L" FOUNDATION XXA POLE WITH 400 WATT LUMINAIRE AND 40 AMP SINGLE POLE BREAKER POLE GOES AT CENTER OF CURB RETURN BEHIND SIDEWALK

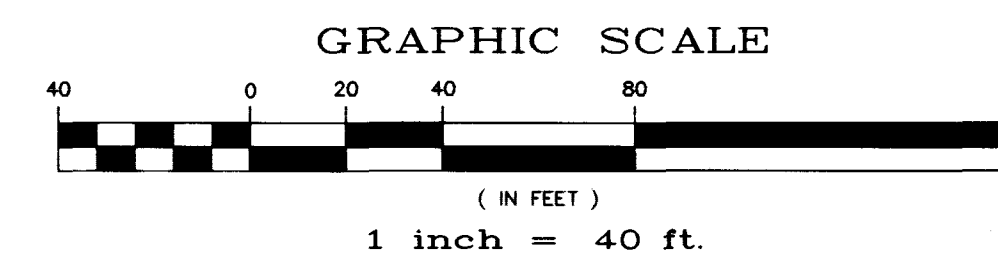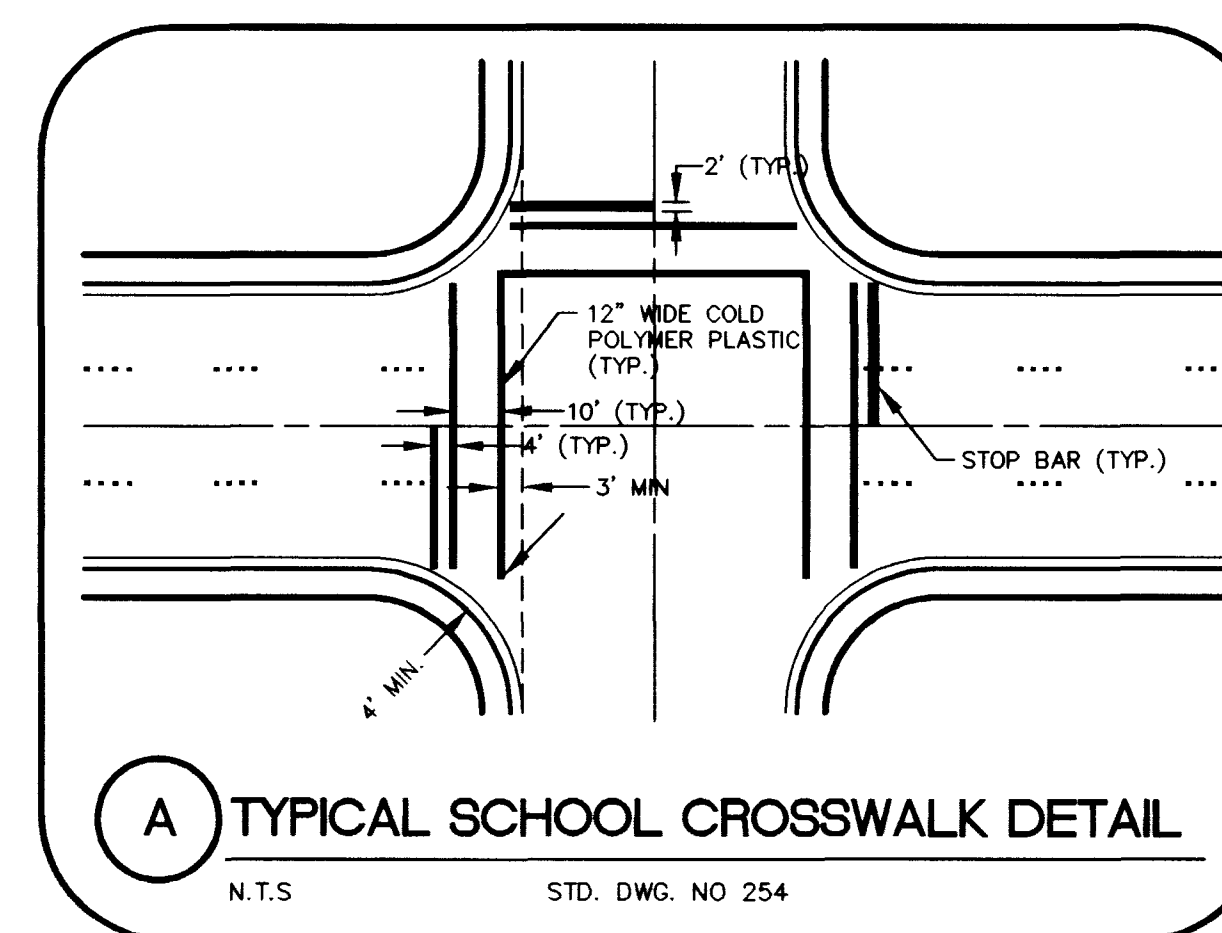

REVISIONS			
REV	DESCRIPTION	DATE	BY

KEY MAP
N.T.S.

Call before you Dig
1-800-277-2800
CLARK COUNTY SCHOOL DISTRICT

Call before you Overhead
1-702-593-6111
CLARK COUNTY SCHOOL DISTRICT

CLARK COUNTY SCHOOL DISTRICT
CONSTRUCTION MANAGEMENT DEPARTMENT 4828 S. PEARL STREET 799-7600 LAS VEGAS, NEVADA 89121

SANDHILL ROAD/WASHINGTON AVENUE HIGH SCHOOL
LAS VEGAS, NEVADA
STR. LT. 4 TRAFFIC PLAN- SANDHILL ROAD

TATE & SNYDER ARCHITECTS
709 VALLE VERDE COURT
HENDERSON NEVADA 89014
(702) 456.3000

C4.06
SHEET 23 OF 32

5170 8966

715-105

