
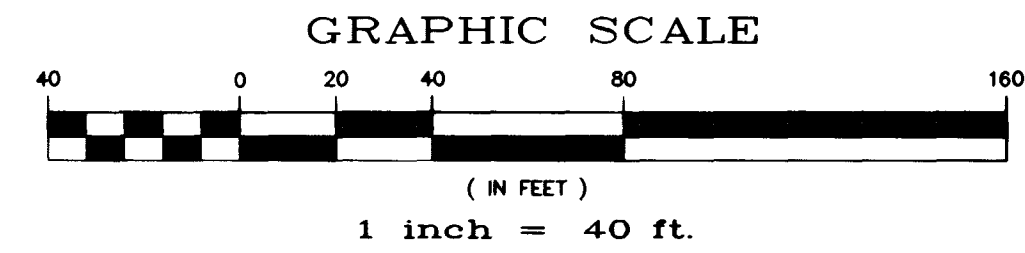
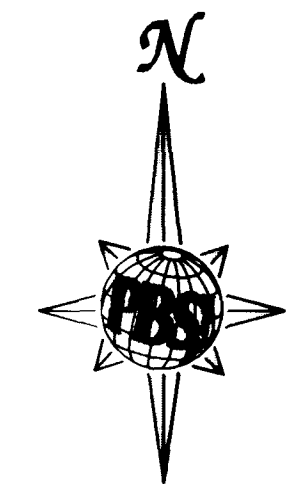


SEE SHEET C2.01

MATCHLINE

MATCHLINE

SEE SHEET C2.04

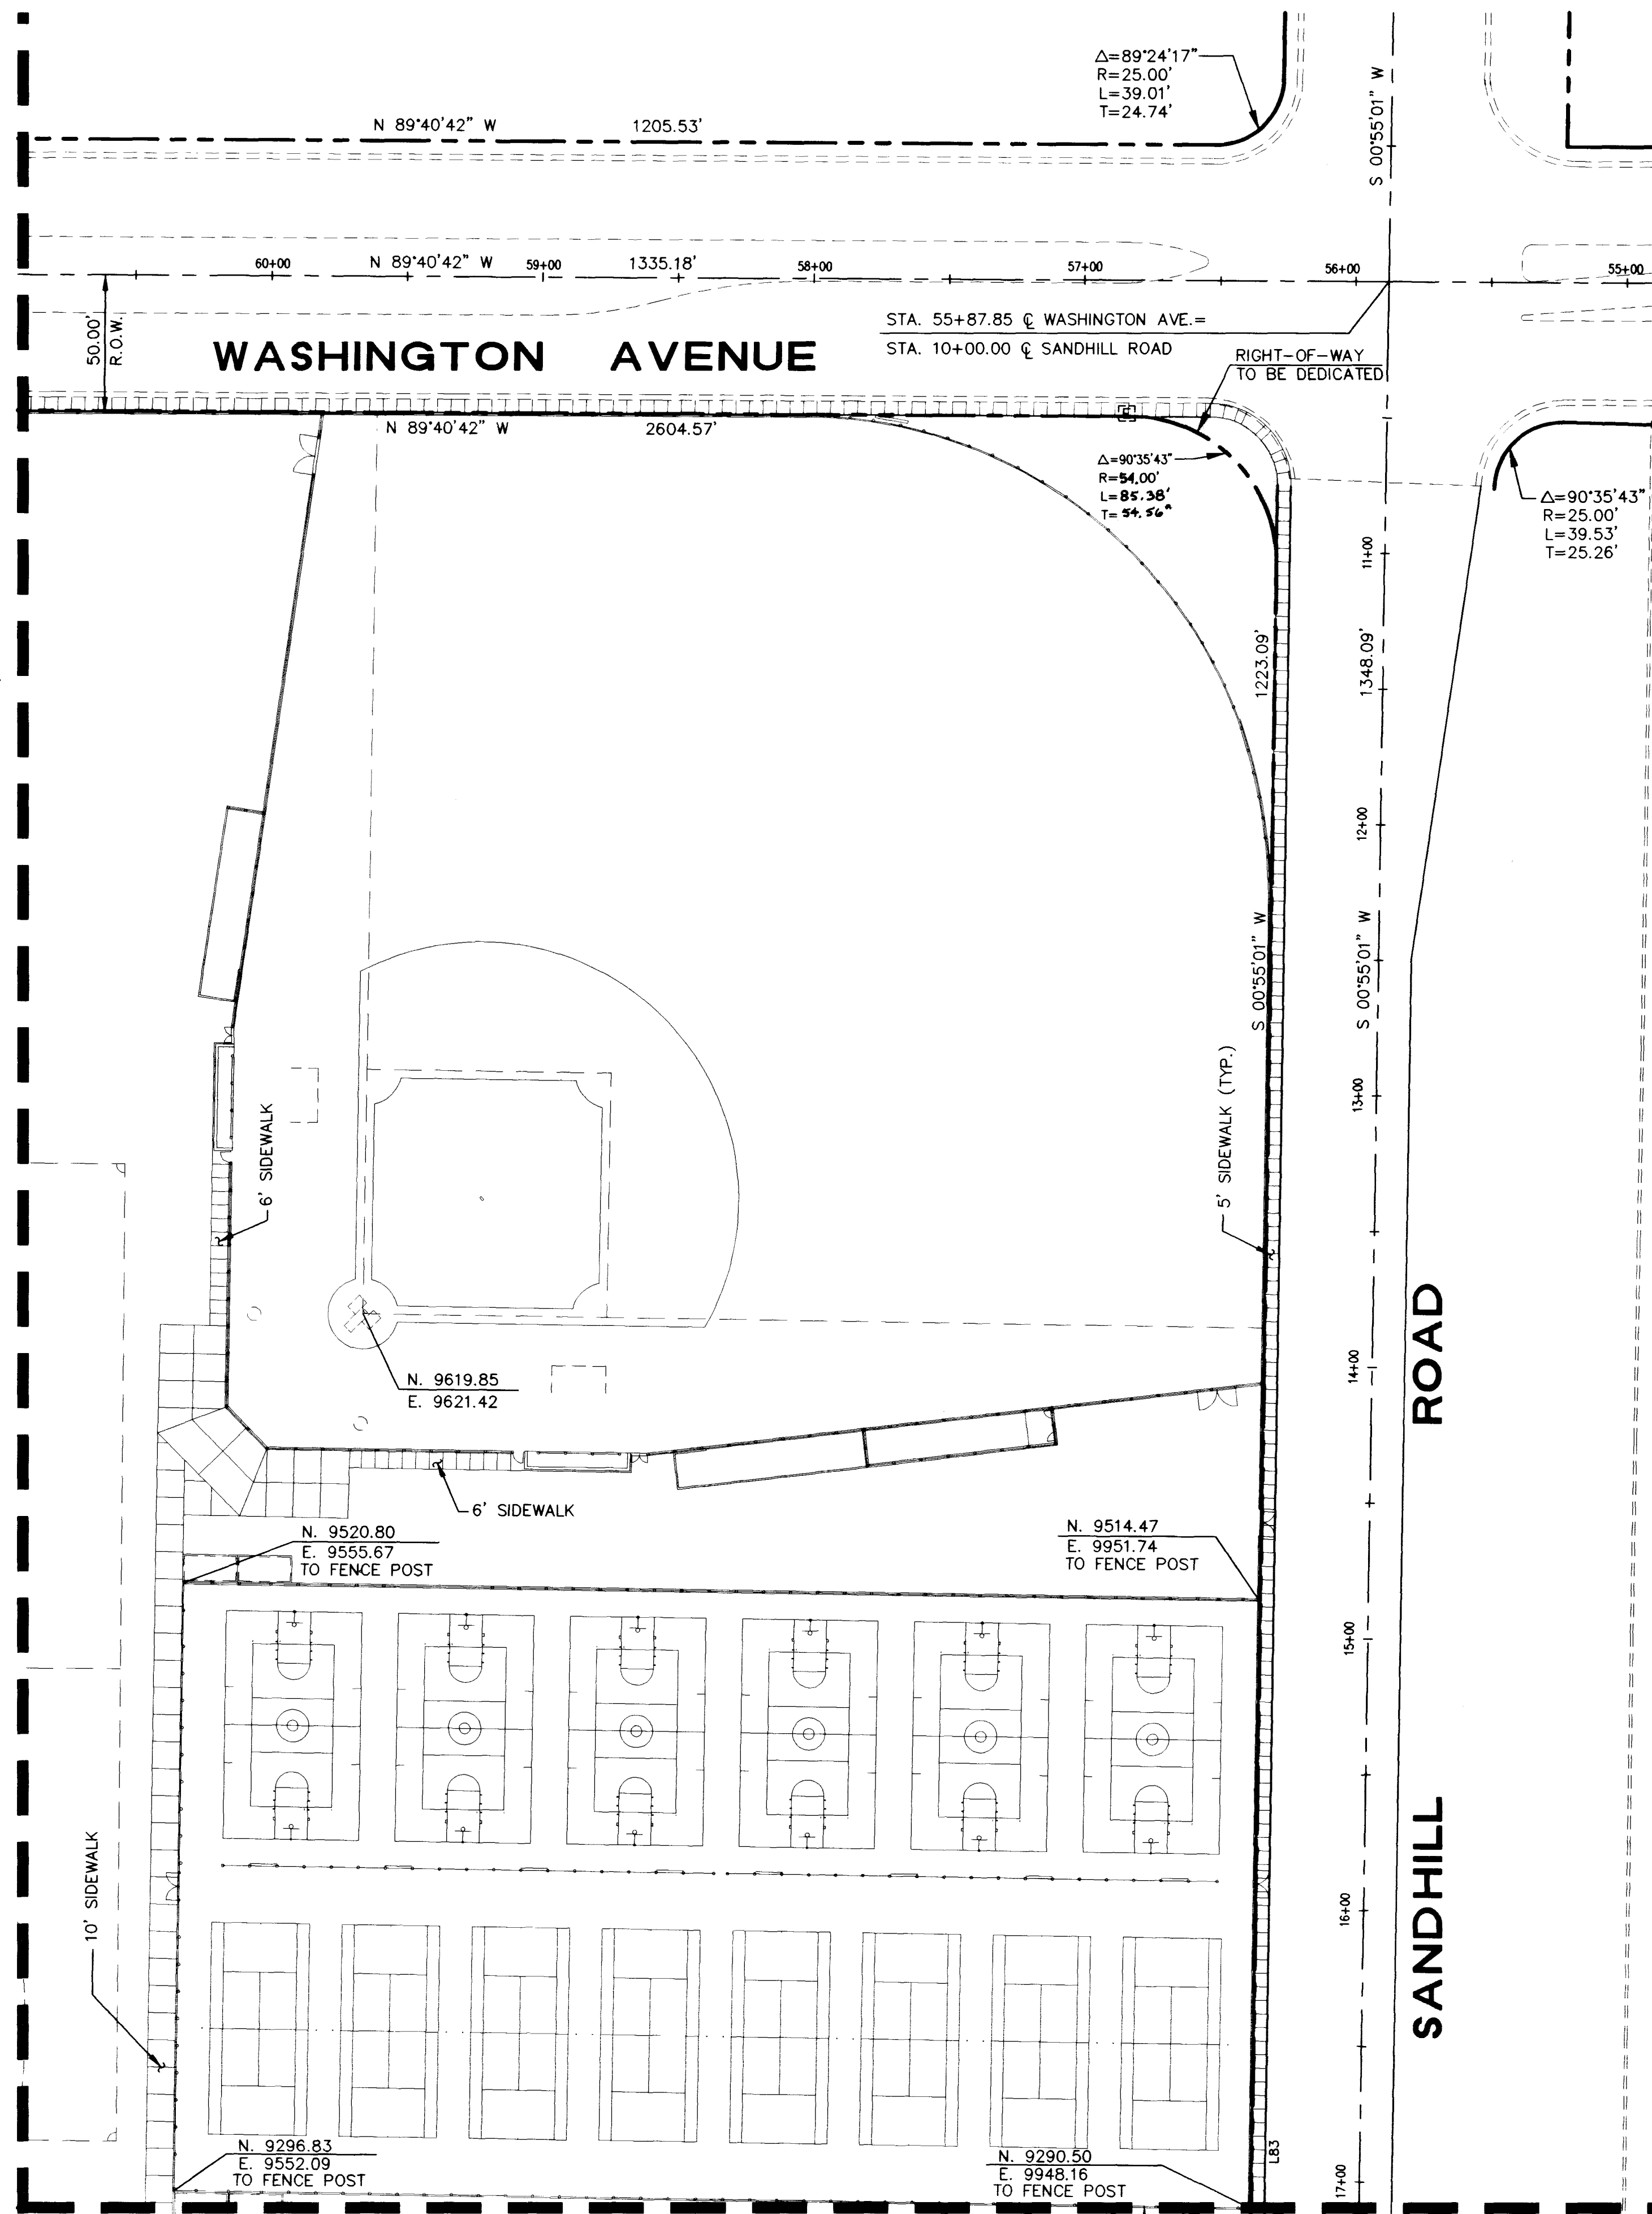

BENCHMARKS

CITY OF LAS VEGAS BENCHMARK NUMBER 2LV02 30S6.
RIVET & PLATE IN TOP OF CURB AT SOUTHWEST
RETURN OF SANDHILL ROAD AND HARRIS AVENUE.

NAVD 88 DATUM
ELEVATION = 1787.60 FEET
544.8623 METERS

CITY OF LAS VEGAS BENCHMARK NUMBER 2LV02 30C4.
RIVET & PLATE IN TOP OF CURB AT NORTHWEST
RETURN OF SANDHILL ROAD AND WASHINGTON AVENUE.

NAVD 88 DATUM
ELEVATION = 1796.178 FEET
547.4764 METERS


BASIS OF BEARING

THE NORTH LINE OF THE SOUTHWEST ONE-QUARTER (SW 1/4), SECTION 30,
TOWNSHIP 20 SOUTH, RANGE 62 EAST, M.D.M., CLARK COUNTY, NEVADA,
BEARS NORTH 89° 40' 45" WEST PER PARCEL MAP, FILE 18, PAGE 95,
OFFICIAL RECORDS OF CLARK COUNTY, NEVADA

NOTE


SEE SHEET C2.01 FOR CURVE AND COURSE DATA.

REVISIONS			
REV	DESCRIPTION	DATE	BY

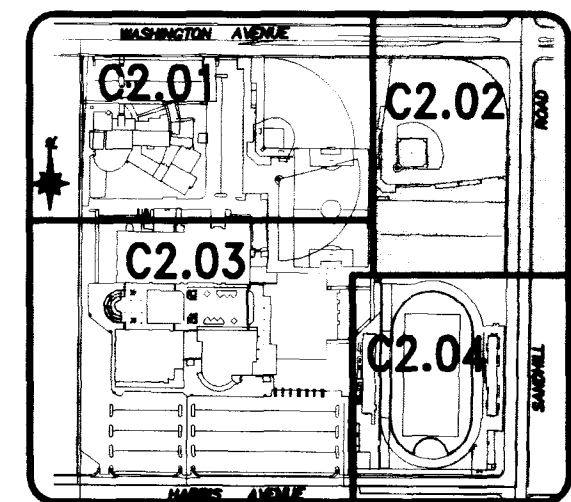


KEY MAP

N.T.S.

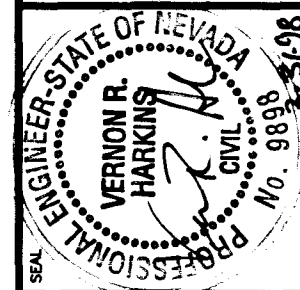

DESIGNED BY V. HANNING	DATE 11-4-97
CHECKED BY V. HANNING	DATE 11-4-97
APPROVED BY V. HANNING	DATE 11-4-97
PROJECT CLARK COUNTY SCHOOL DISTRICT	SHEET NO. C2.02

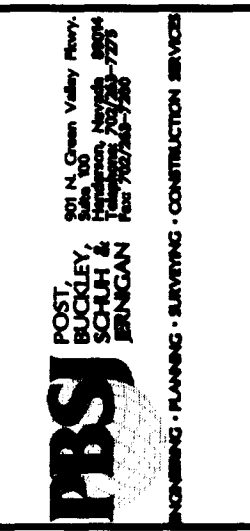

TATE & SNYDER ARCHITECTS
709 VALLE VERDE COURT
HENDERSON NEVADA 89014
(702) 456.3000

CLARK COUNTY SCHOOL DISTRICT
CONSTRUCTION MANAGEMENT DEPARTMENT 4828 S. PEARL STREET 799-7800 LAS VEGAS, NEVADA 89121
SANDHILL ROAD/WASHINGTON AVENUE HIGH SCHOOL
LAS VEGAS
SHEET NO. C2.02

SITE DIMENSION PLAN

C2.02

SHEET 5 OF 32

8738

715-105

