
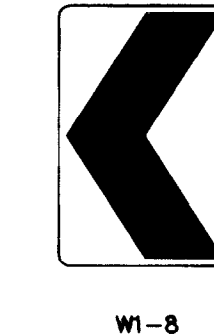
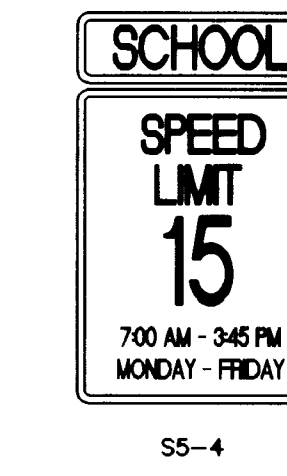
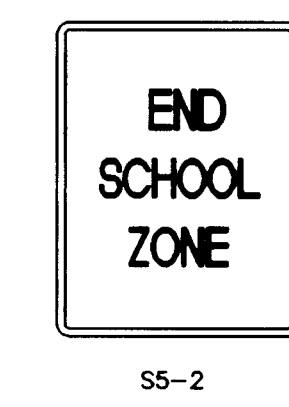


REFER TO SHEET C4.05

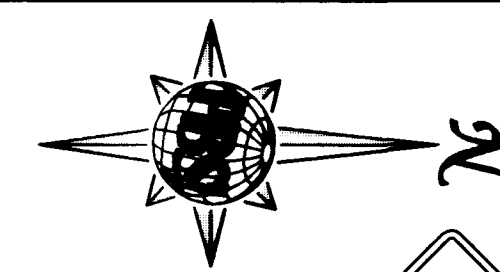


NOTE



ALL OFF-SITE SIGNAGE AND STRIPING TO BE INSTALLED BY CITY OF LAS VEGAS

CONSTRUCTION KEY NOTES

1. INSTALL 1-1/4" STREETLIGHT CONDUIT W/2-#4, 1-#8 THW. (TYP.) (BENEATH SIDEWALK, CLV STDS.)
2. INSTALL 250 WATT HIGH PRESSURE SODIUM LIGHT PER CLV STDS.
3. INSTALL 100 WATT HIGH PRESSURE SODIUM LIGHT PER CLV STDS.
4. INSTALL #3-1/2 PULLBOX
5. INSTALL #5 PULLBOX
6. INSTALL 2" TRAFFIC SIGNAL INTERCONNECT CONDUIT WITH PULLSTRING
7. INSTALL #7 PULLBOX
8. INSTALL "L" FOUNDATION XXA POLE WITH 400 WATT LUMINAIRE AND 40 AMP SINGLE POLE BREAKER POLE GOES AT CENTER OF CURB RETURN BEHIND SIDEWALK



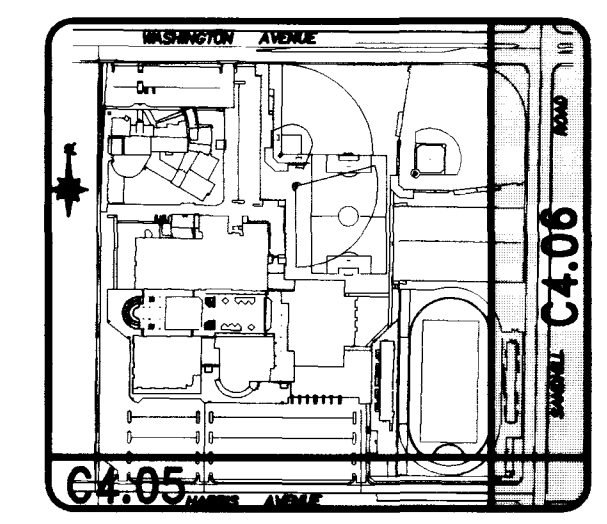


KEY MAP
N.T.S.

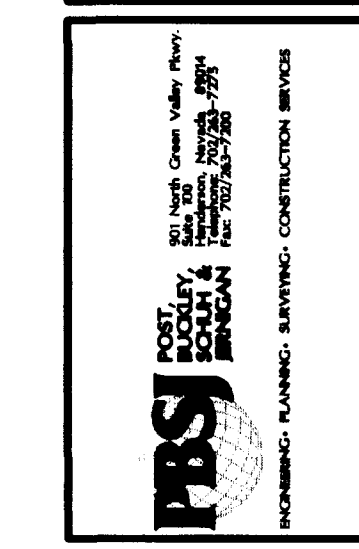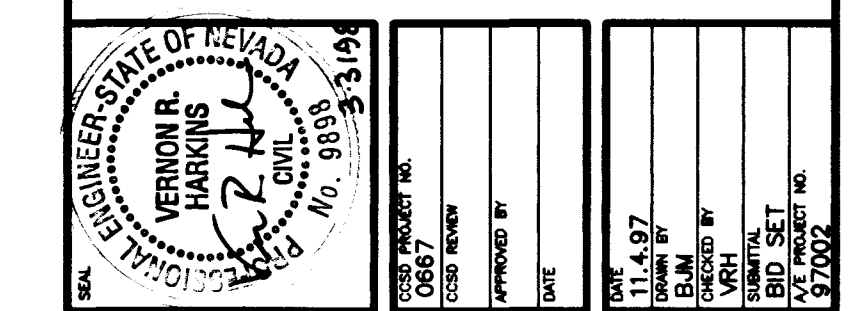


TATE & SNYDER ARCHITECTS
709 VALLE VERDE COURT
HENDERSON NEVADA 89014
(702) 456.3000

CLARK COUNTY SCHOOL DISTRICT
CONSTRUCTION MANAGEMENT DEPARTMENT 4828 S. PEARL STREET 790-7800 LAS VEGAS, NEVADA 89121
SANDHILL ROAD/WASHINGTON AVENUE HIGH SCHOOL
LAS VEGAS
STR. LT. 4 TRAFFIC PLAN - SANDHILL ROAD

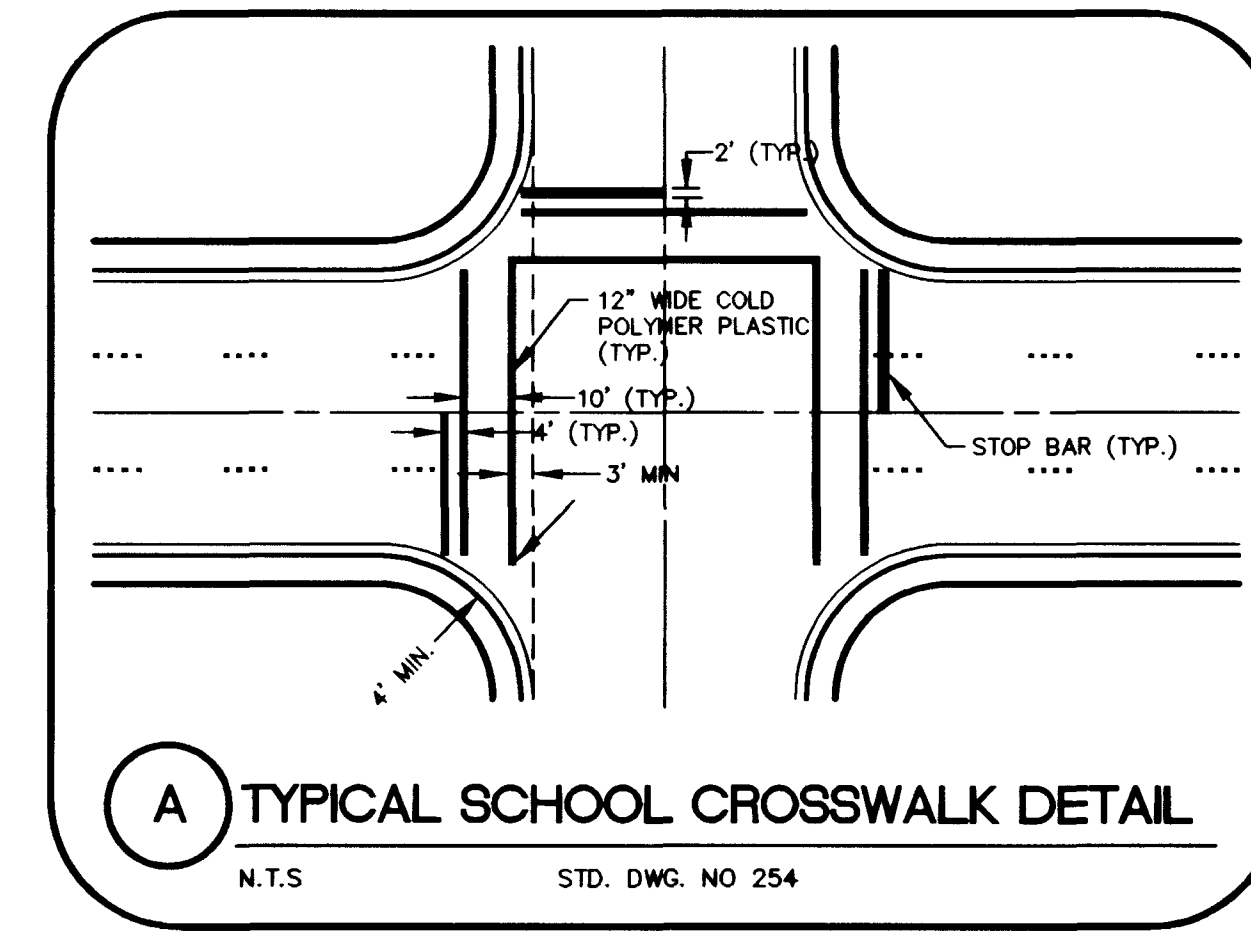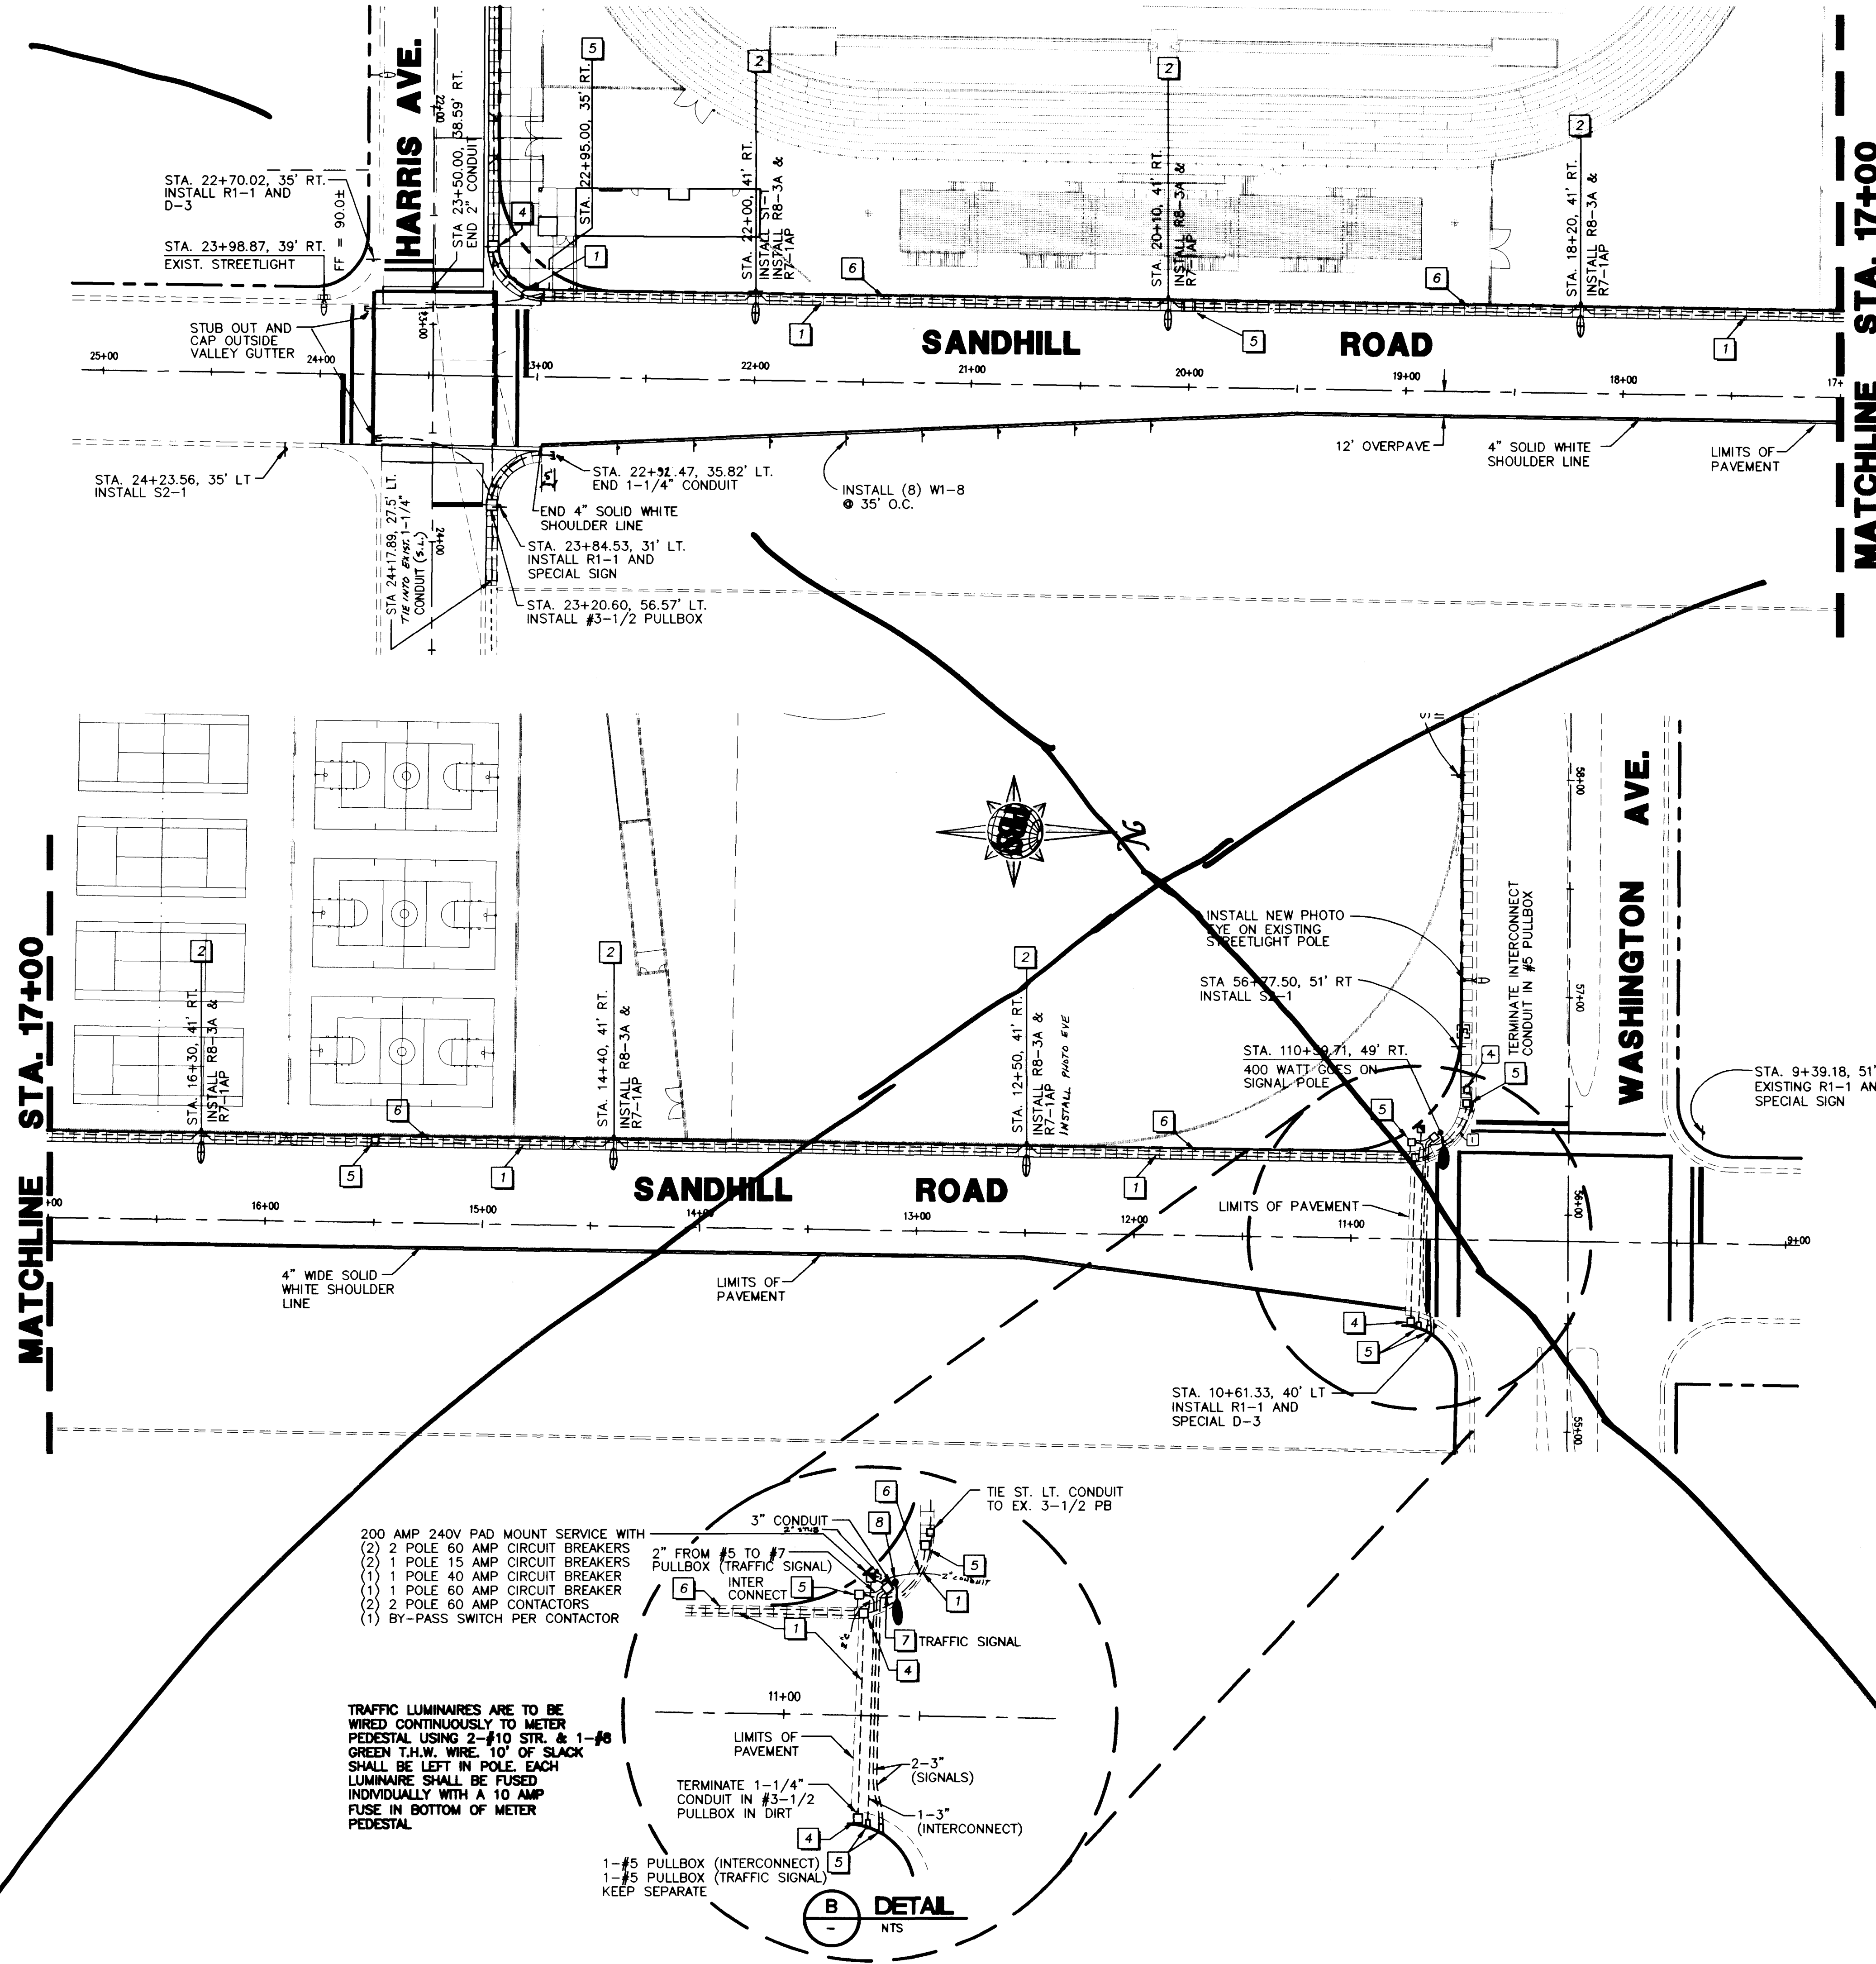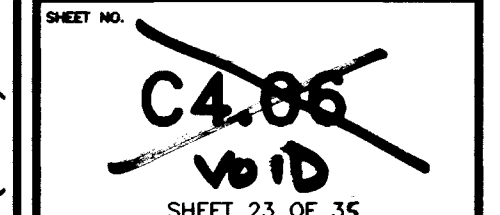



A TYPICAL SCHOOL CROSSWALK DETAIL
N.T.S. STD. DWG. NO 254

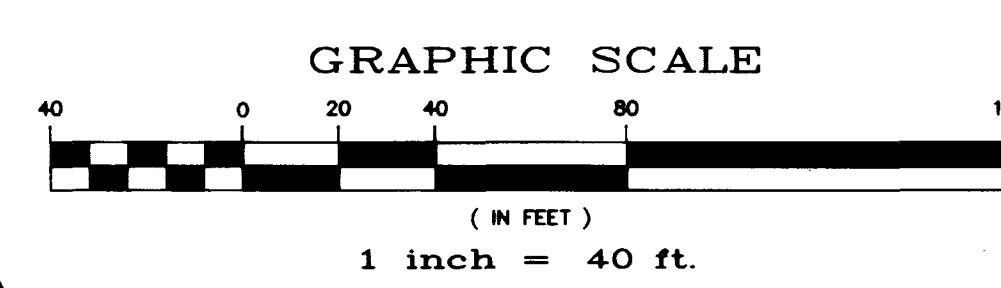

GRAPHIC SCALE

1 inch = 40 ft.

424-sgn.dwg REV 03/13/98 14:06:35 ARE: 424BNS22, PROBANS2

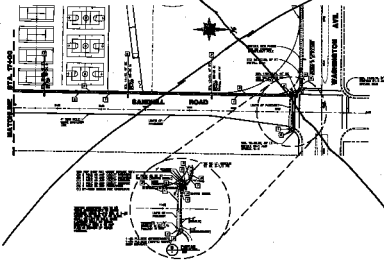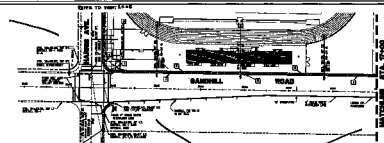

7418

[illegible]



