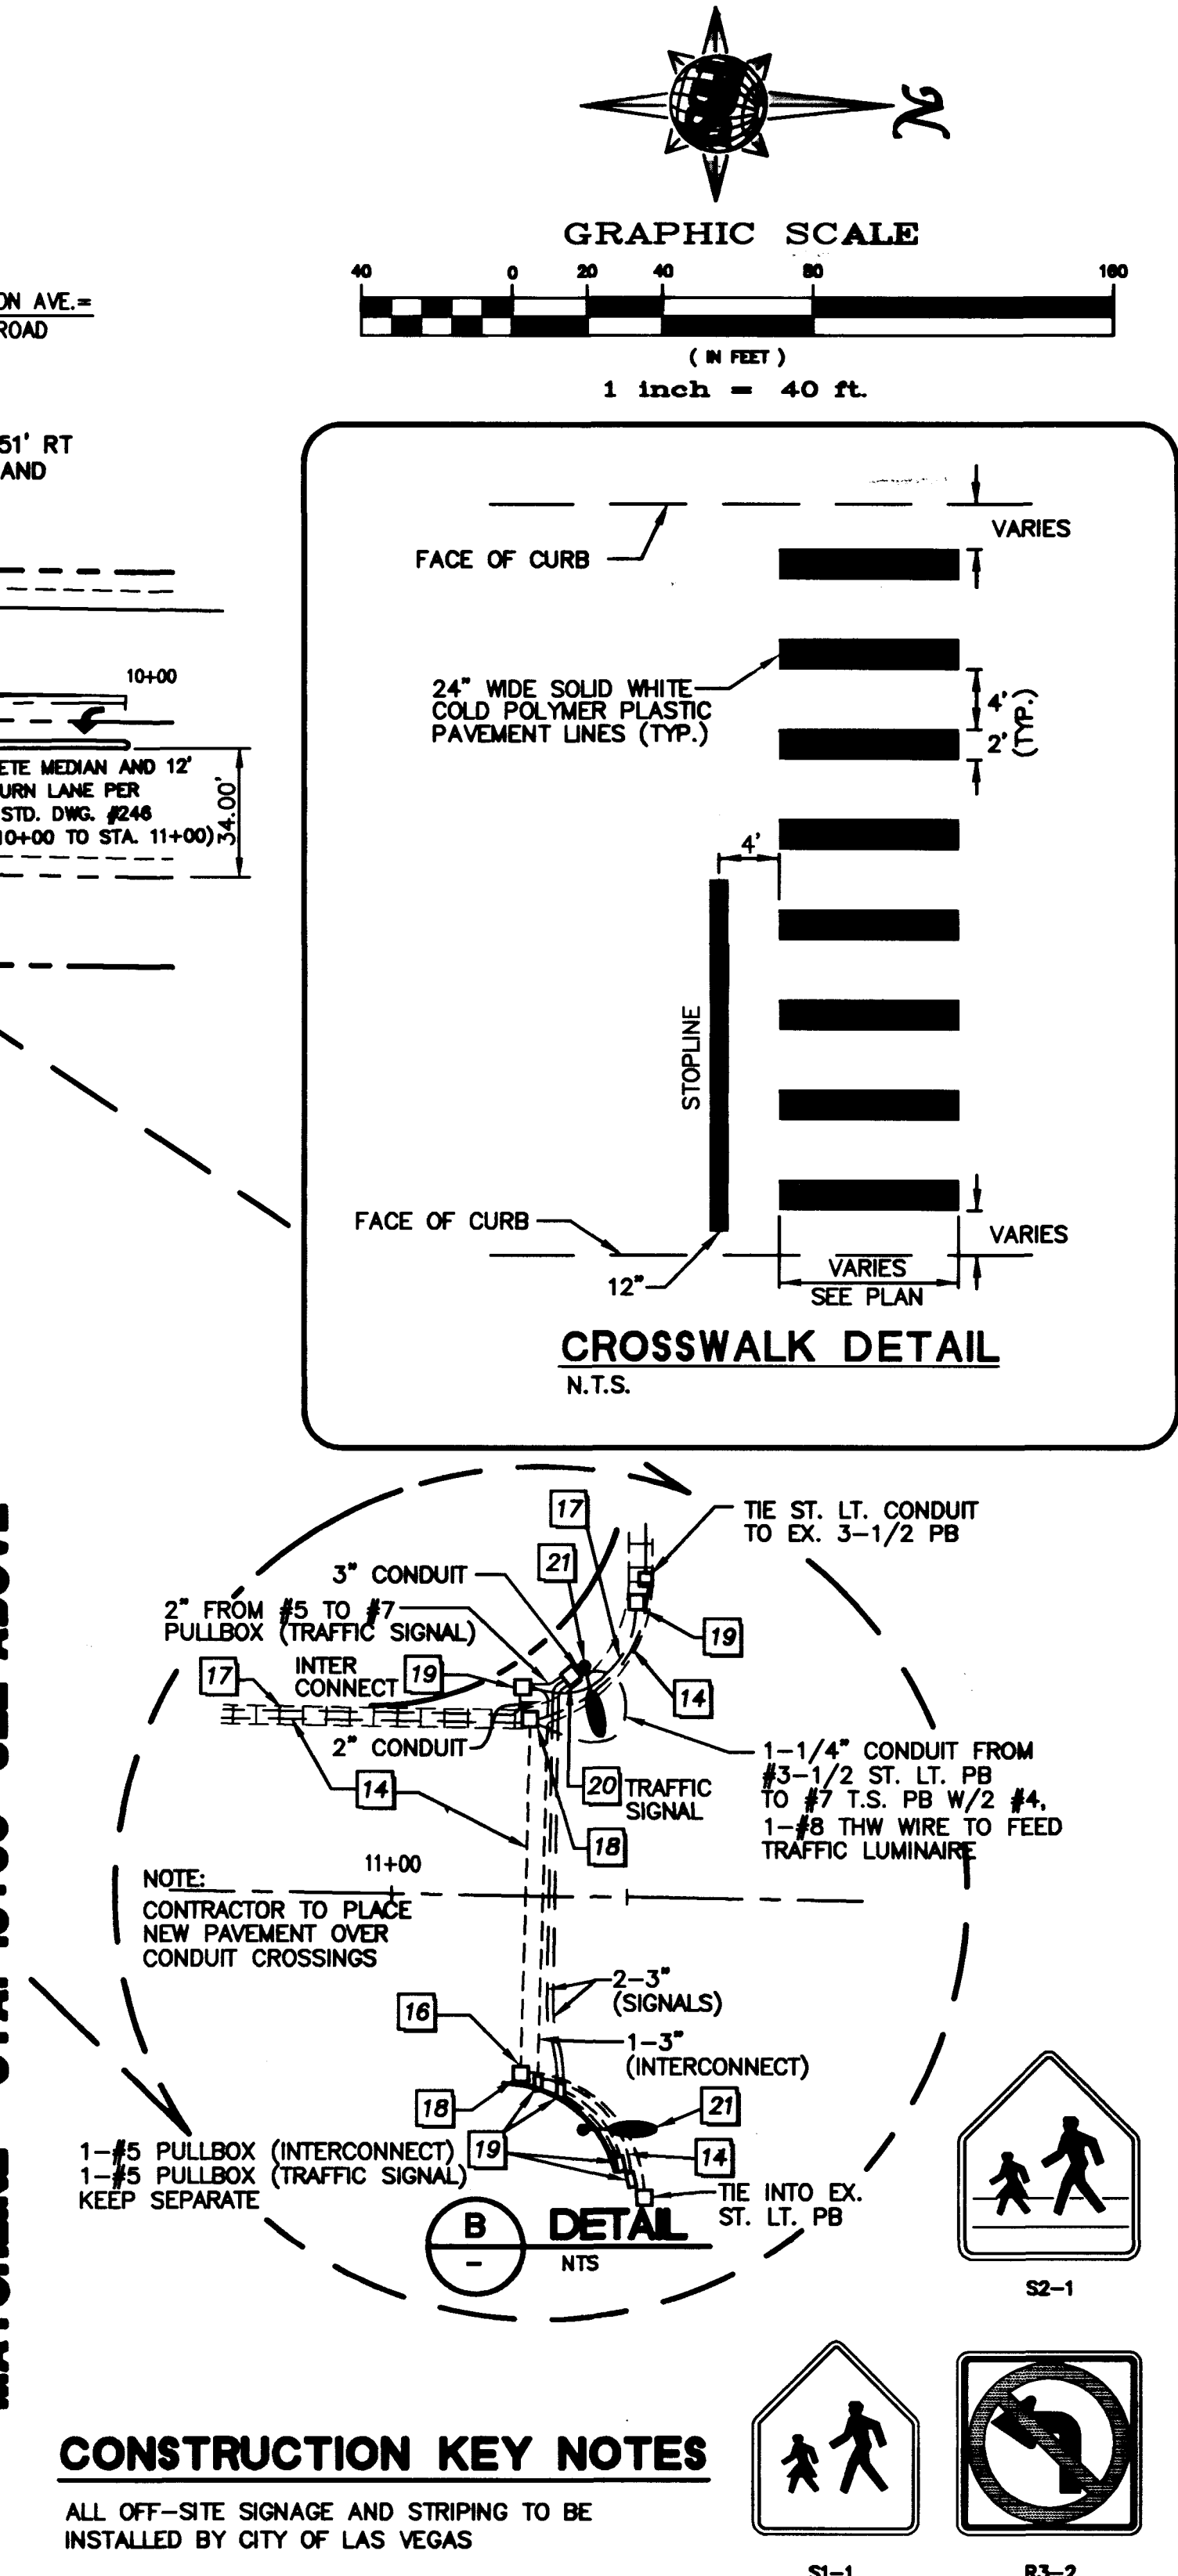
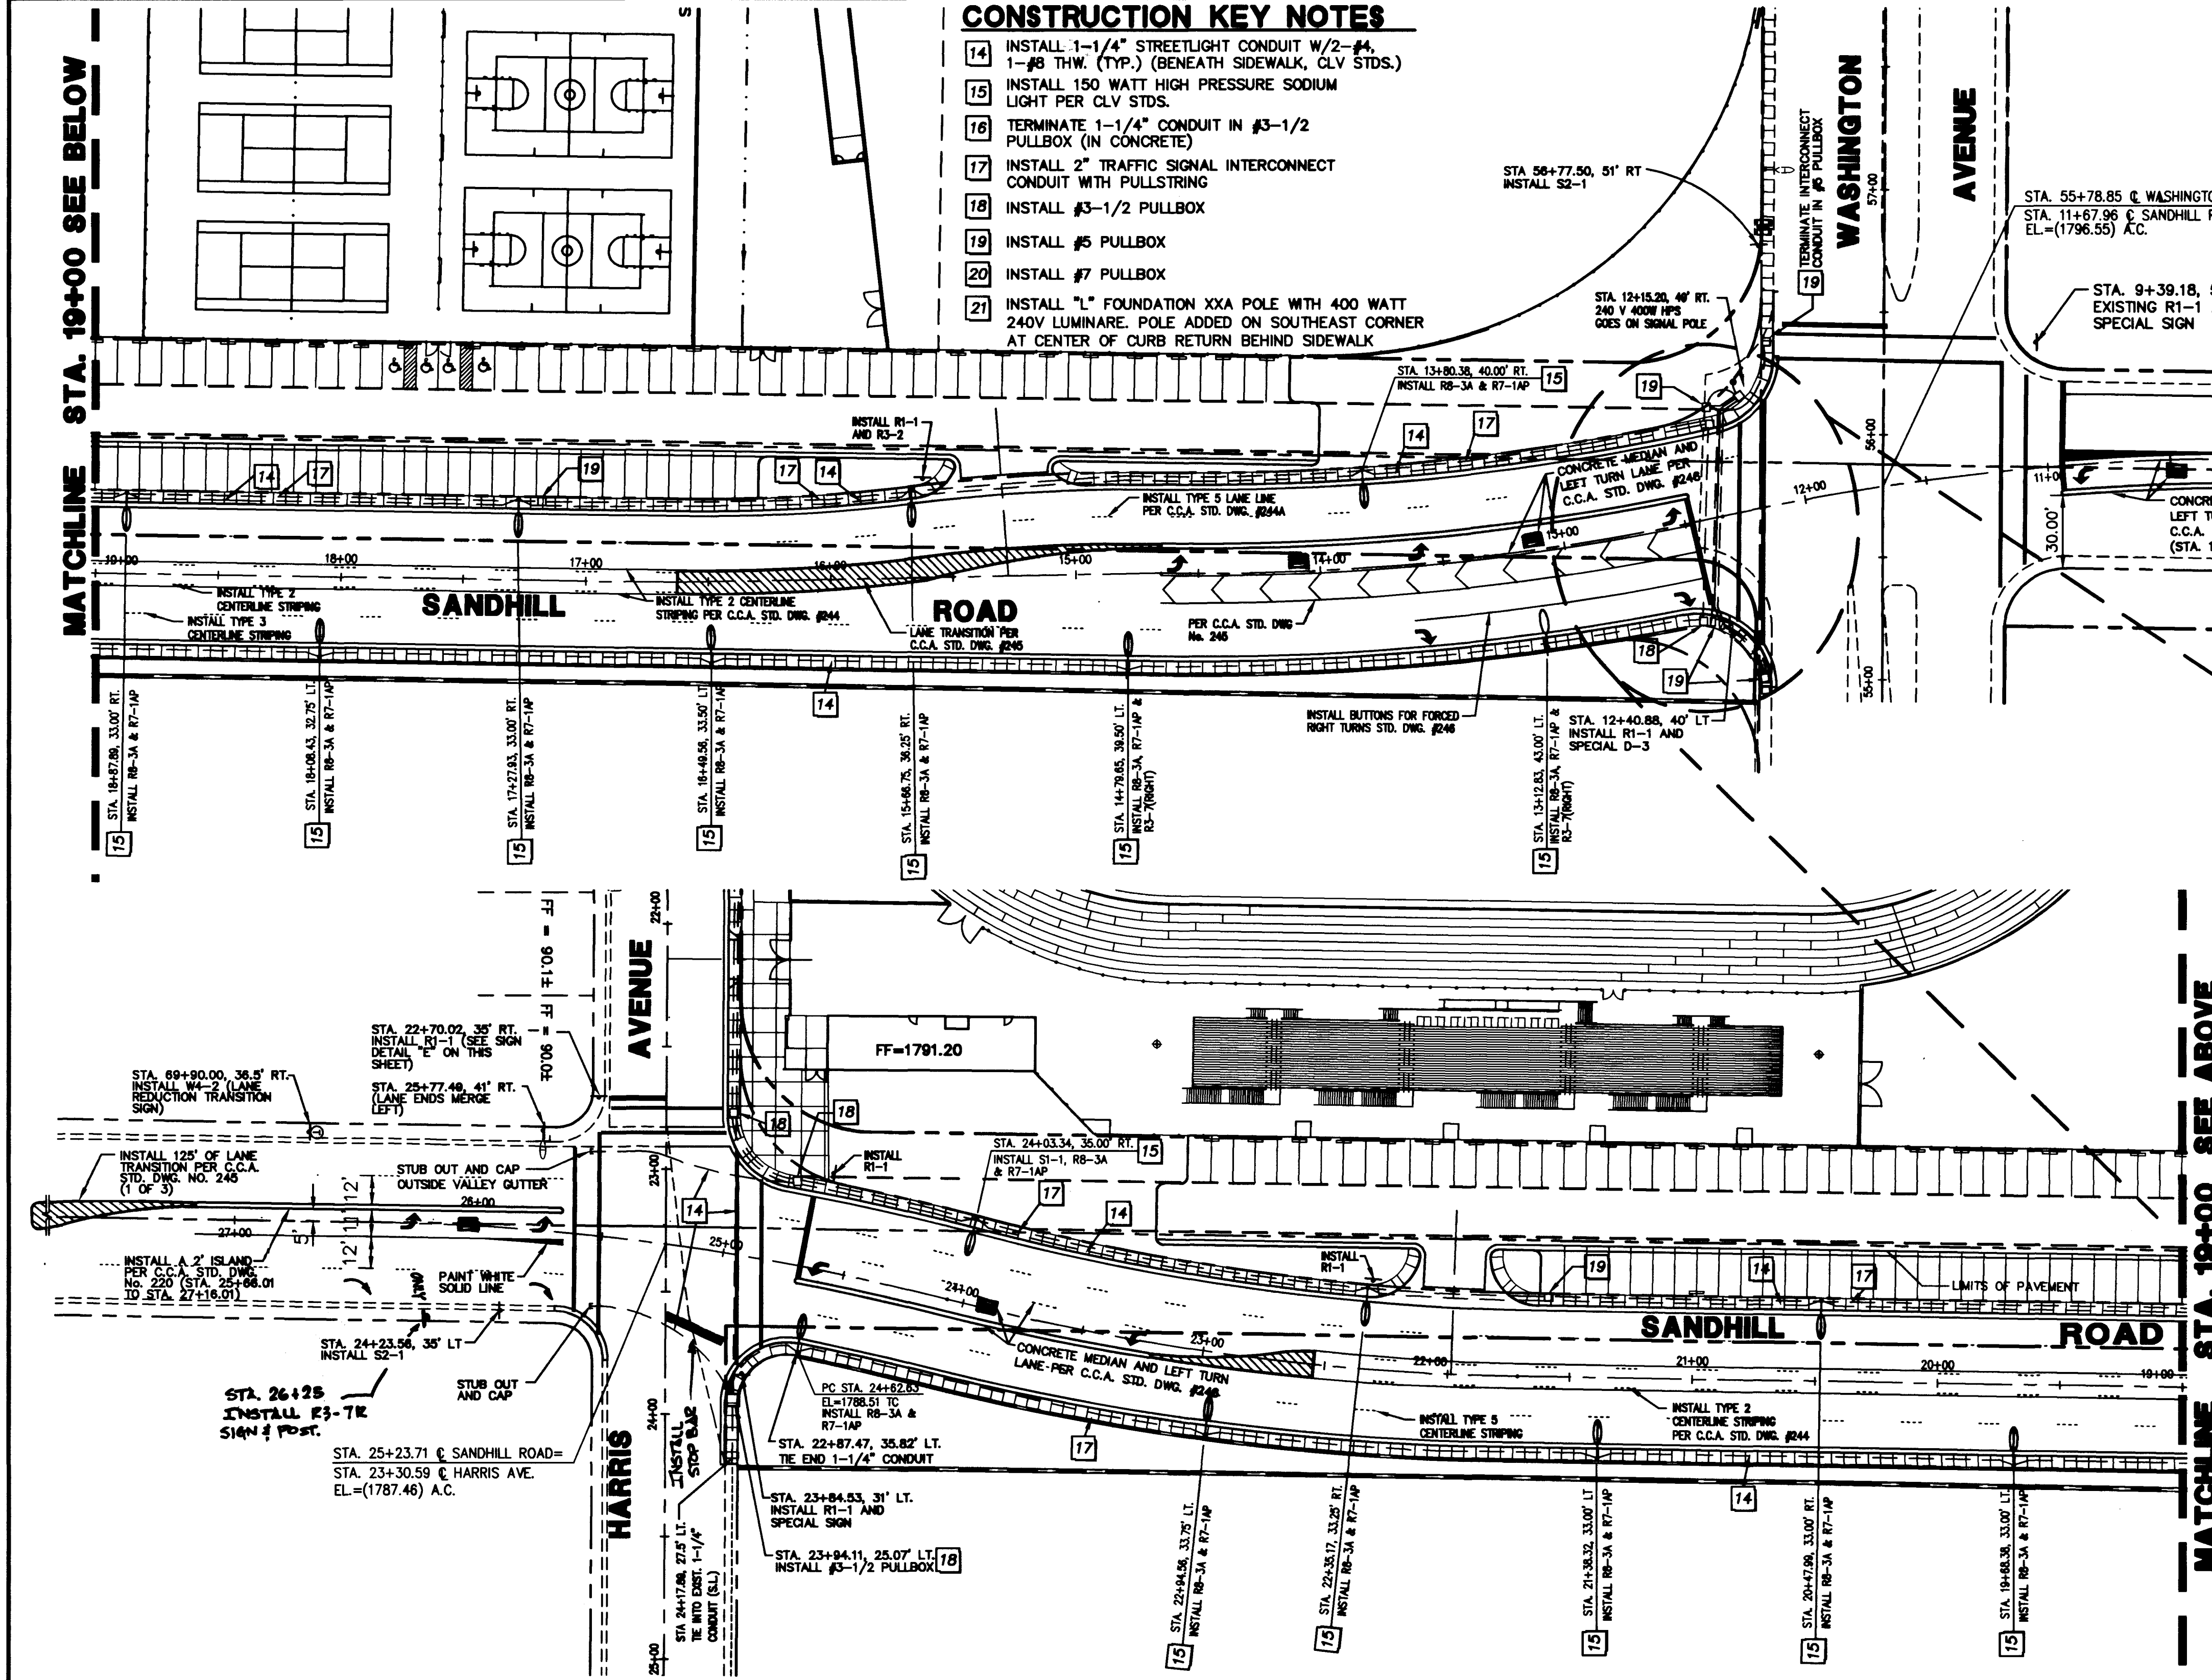


| REVISIONS |                      |
|-----------|----------------------|
| NO.       | DESCRIPTION          |
| 1         | SANDHILL REALIGNMENT |

**BASIS OF BEARING**

THE NORTH LINE OF THE SOUTHWEST ONE-QUARTER (SW 1/4), SECTION 30, TOWNSHIP 20 SOUTH, RANGE 62 EAST, M.D.M., CLARK COUNTY, NEVADA, BEARS NORTH 89° 40' 45" WEST PER PARCEL MAP, FILE 18, PAGE 95, OFFICIAL RECORDS OF CLARK COUNTY, NEVADA

**BENCHMARKS**

CITY OF LAS VEGAS BENCHMARK NUMBER 2LV02 3056. RIVET & PLATE IN TOP OF CURB AT SOUTHWEST RETURN OF SANDHILL ROAD AND HARRIS AVENUE.

NAVD 88 DATUM  
ELEVATION = 1787.60 FEET  
544.8623 METERS

CITY OF LAS VEGAS BENCHMARK NUMBER 2LV02 30C4. RIVET & PLATE IN TOP OF CURB AT NORTHWEST RETURN OF SANDHILL ROAD AND WASHINGTON AVENUE.

NAVD 88 DATUM  
ELEVATION = 1796.178 FEET  
547.4764 METERS

**Call before you Dig**

1-800-227-2900

**Call before you Overhead**

1-702-563-8111

STATE OF NEVADA  
JEROME R. HARRISON  
PROFESSIONAL ENGINEER  
No. 8593

CLARK COUNTY SCHOOL DISTRICT  
CONSTRUCTION MANAGEMENT DEPARTMENT  
4225 S. PEARL STREET  
LAS VEGAS, NEVADA 89121

**TATI & SYNDIR ARCHITECTS**  
709 VALLE VERDE COURT  
HENDERSON NEVADA 89014  
(702) 456.3000

**C7.03**

SHEET 35 OF 35

