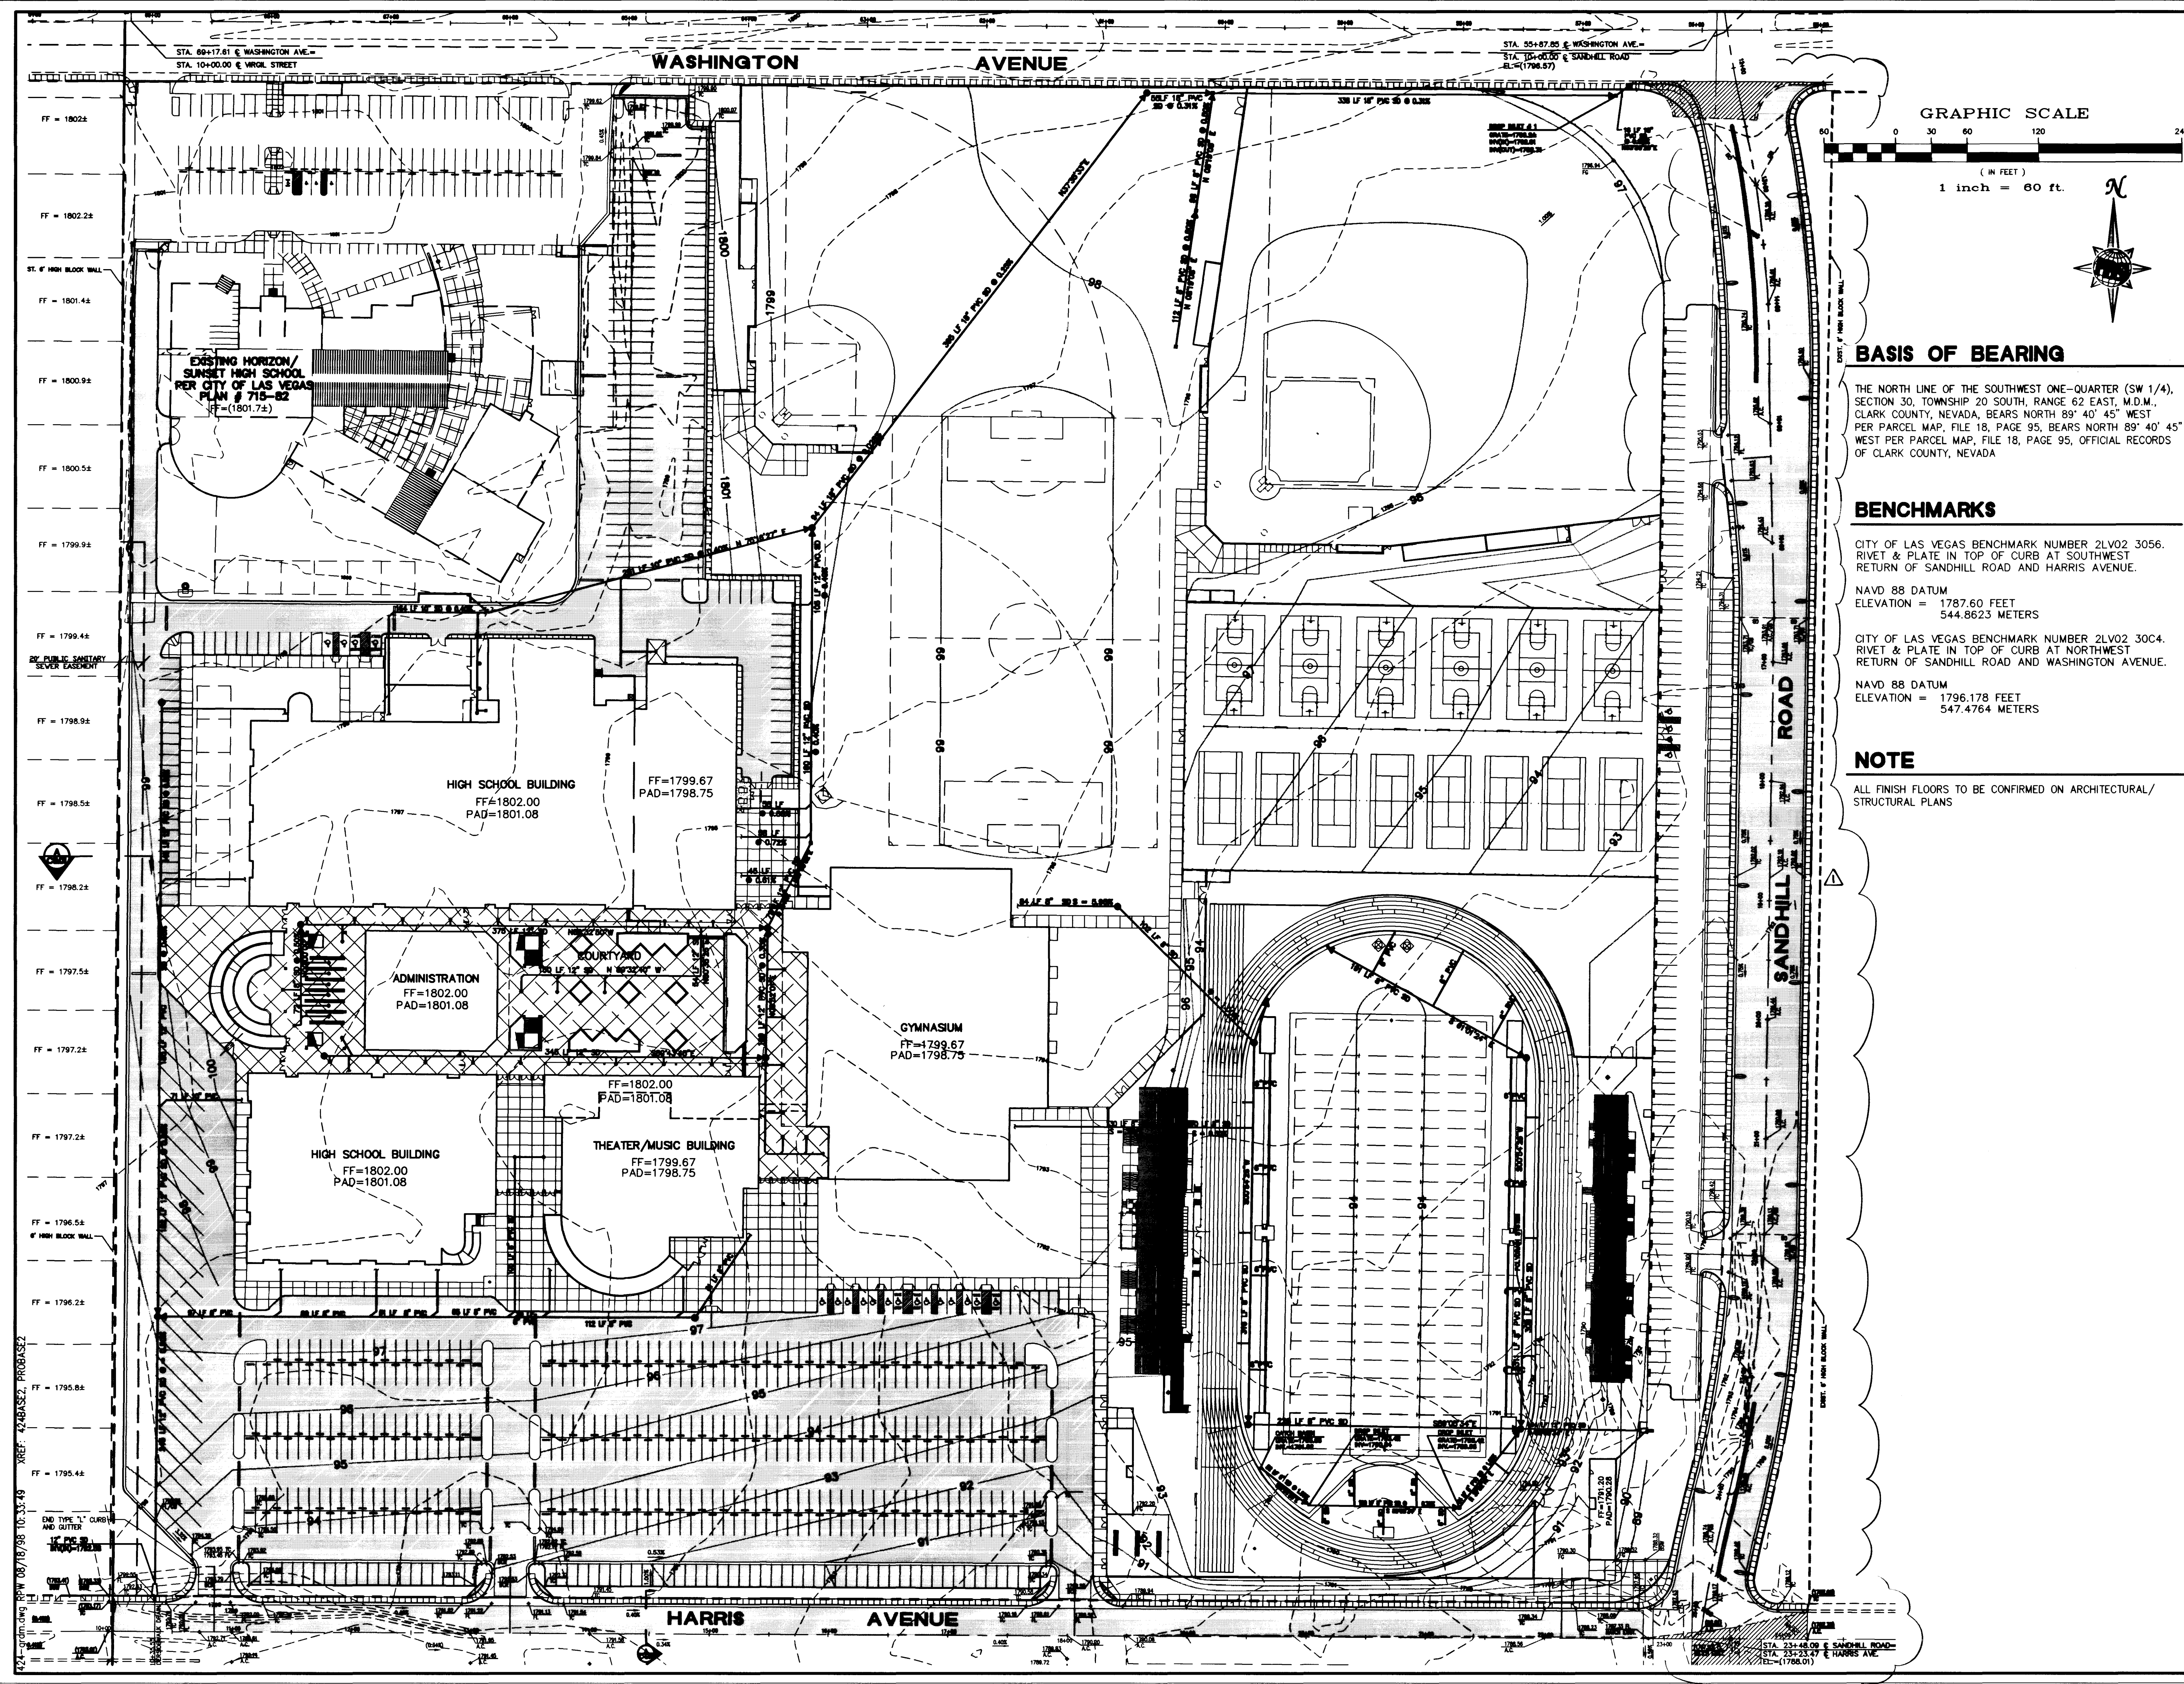


BASIS OF BEARING

THE NORTH LINE OF THE SOUTHWEST ONE-QUARTER (SW 1/4), SECTION 30, TOWNSHIP 20 SOUTH, RANGE 62 EAST, M.D.M., CLARK COUNTY, NEVADA, BEARS NORTH 89° 40' 45" WEST PER PARCEL MAP, FILE 18, PAGE 95, BEARS NORTH 89° 40' 45" WEST PER PARCEL MAP, FILE 18, PAGE 95, OFFICIAL RECORDS OF CLARK COUNTY, NEVADA

BENCHMARKS

CITY OF LAS VEGAS BENCHMARK NUMBER 2LV02 3056. RIVET & PLATE IN TOP OF CURB AT SOUTHWEST RETURN OF SANDHILL ROAD AND HARRIS AVENUE.

NAVD 88 DATUM
ELEVATION = 1787.60 FEET
544.8623 METERS


CITY OF LAS VEGAS BENCHMARK NUMBER 2LV02 30C4. RIVET & PLATE IN TOP OF CURB AT NORTHWEST RETURN OF SANDHILL ROAD AND WASHINGTON AVENUE.

NAVD 88 DATUM
ELEVATION = 1796.178 FEET
547.4764 METERS

NOTE

ALL FINISH FLOORS TO BE CONFIRMED ON ARCHITECTURAL/STRUCTURAL PLANS

REVISIONS			
REV	DESCRIPTION	DATE	BY
1	SANDHILL REALIGNMENT	8/17/98	MS

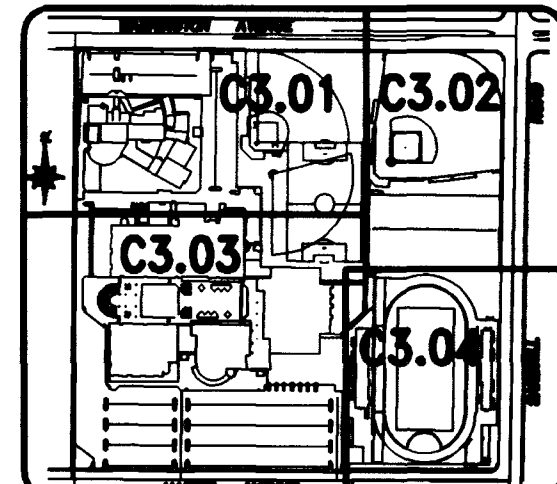


KEY MAP


N.T.S.

Call before you Dig
1-800-227-2600


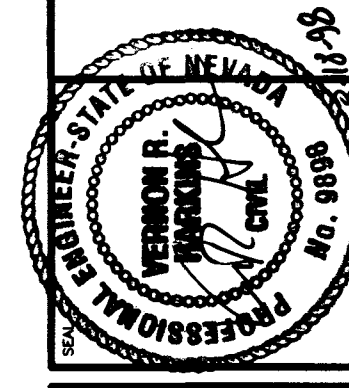

DESIGNED BY T. SNYDER	CHECKED BY T. SNYDER	DATE 8/17/98
APPROVED BY T. SNYDER	DATE 8/17/98	PROJECT CLARK COUNTY SCHOOL DISTRICT

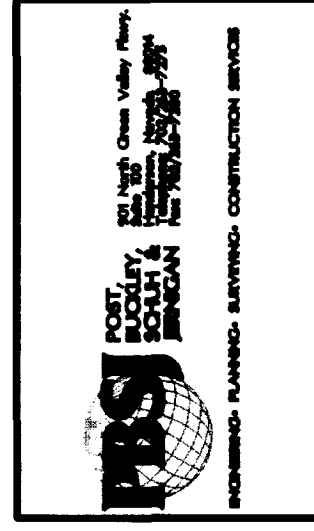


DESIGNED BY T. SNYDER	CHECKED BY T. SNYDER	DATE 8/17/98
APPROVED BY T. SNYDER	DATE 8/17/98	PROJECT CLARK COUNTY SCHOOL DISTRICT

TATI SNYDER ARCHITECTS
709 VALLE VERDE COURT
HENDERSON NEVADA 89014
(702) 456-3000

CLARK COUNTY SCHOOL DISTRICT
CONSTRUCTION MANAGEMENT DEPARTMENT 4628 S. PEARL STREET 799-7600 LAS VEGAS, NEVADA 89121
SANDHILL ROAD/WASHINGTON AVENUE HIGH SCHOOL
LAS VEGAS
MASTER GRADING PLAN

CLARK COUNTY SCHOOL DISTRICT
CONSTRUCTION MANAGEMENT DEPARTMENT 4628 S. PEARL STREET 799-7600 LAS VEGAS, NEVADA 89121
SANDHILL ROAD/WASHINGTON AVENUE HIGH SCHOOL
LAS VEGAS
MASTER GRADING PLAN

C3.00
SHEET 8 OF 35

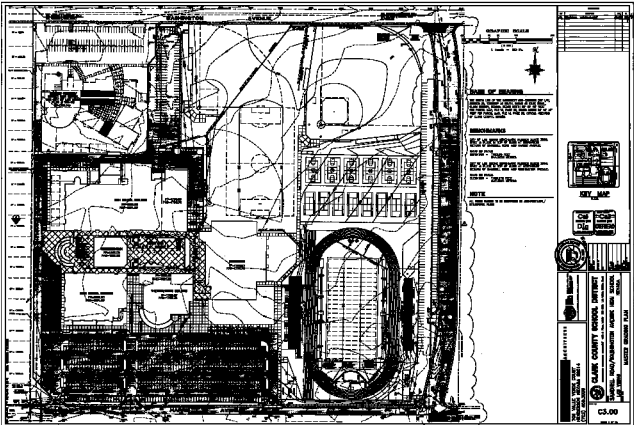

2007-2008