


MONUMENT TIE MAP  
STEWART PLACE - UNIT 6a

FUTURE DEVELOPEMENT

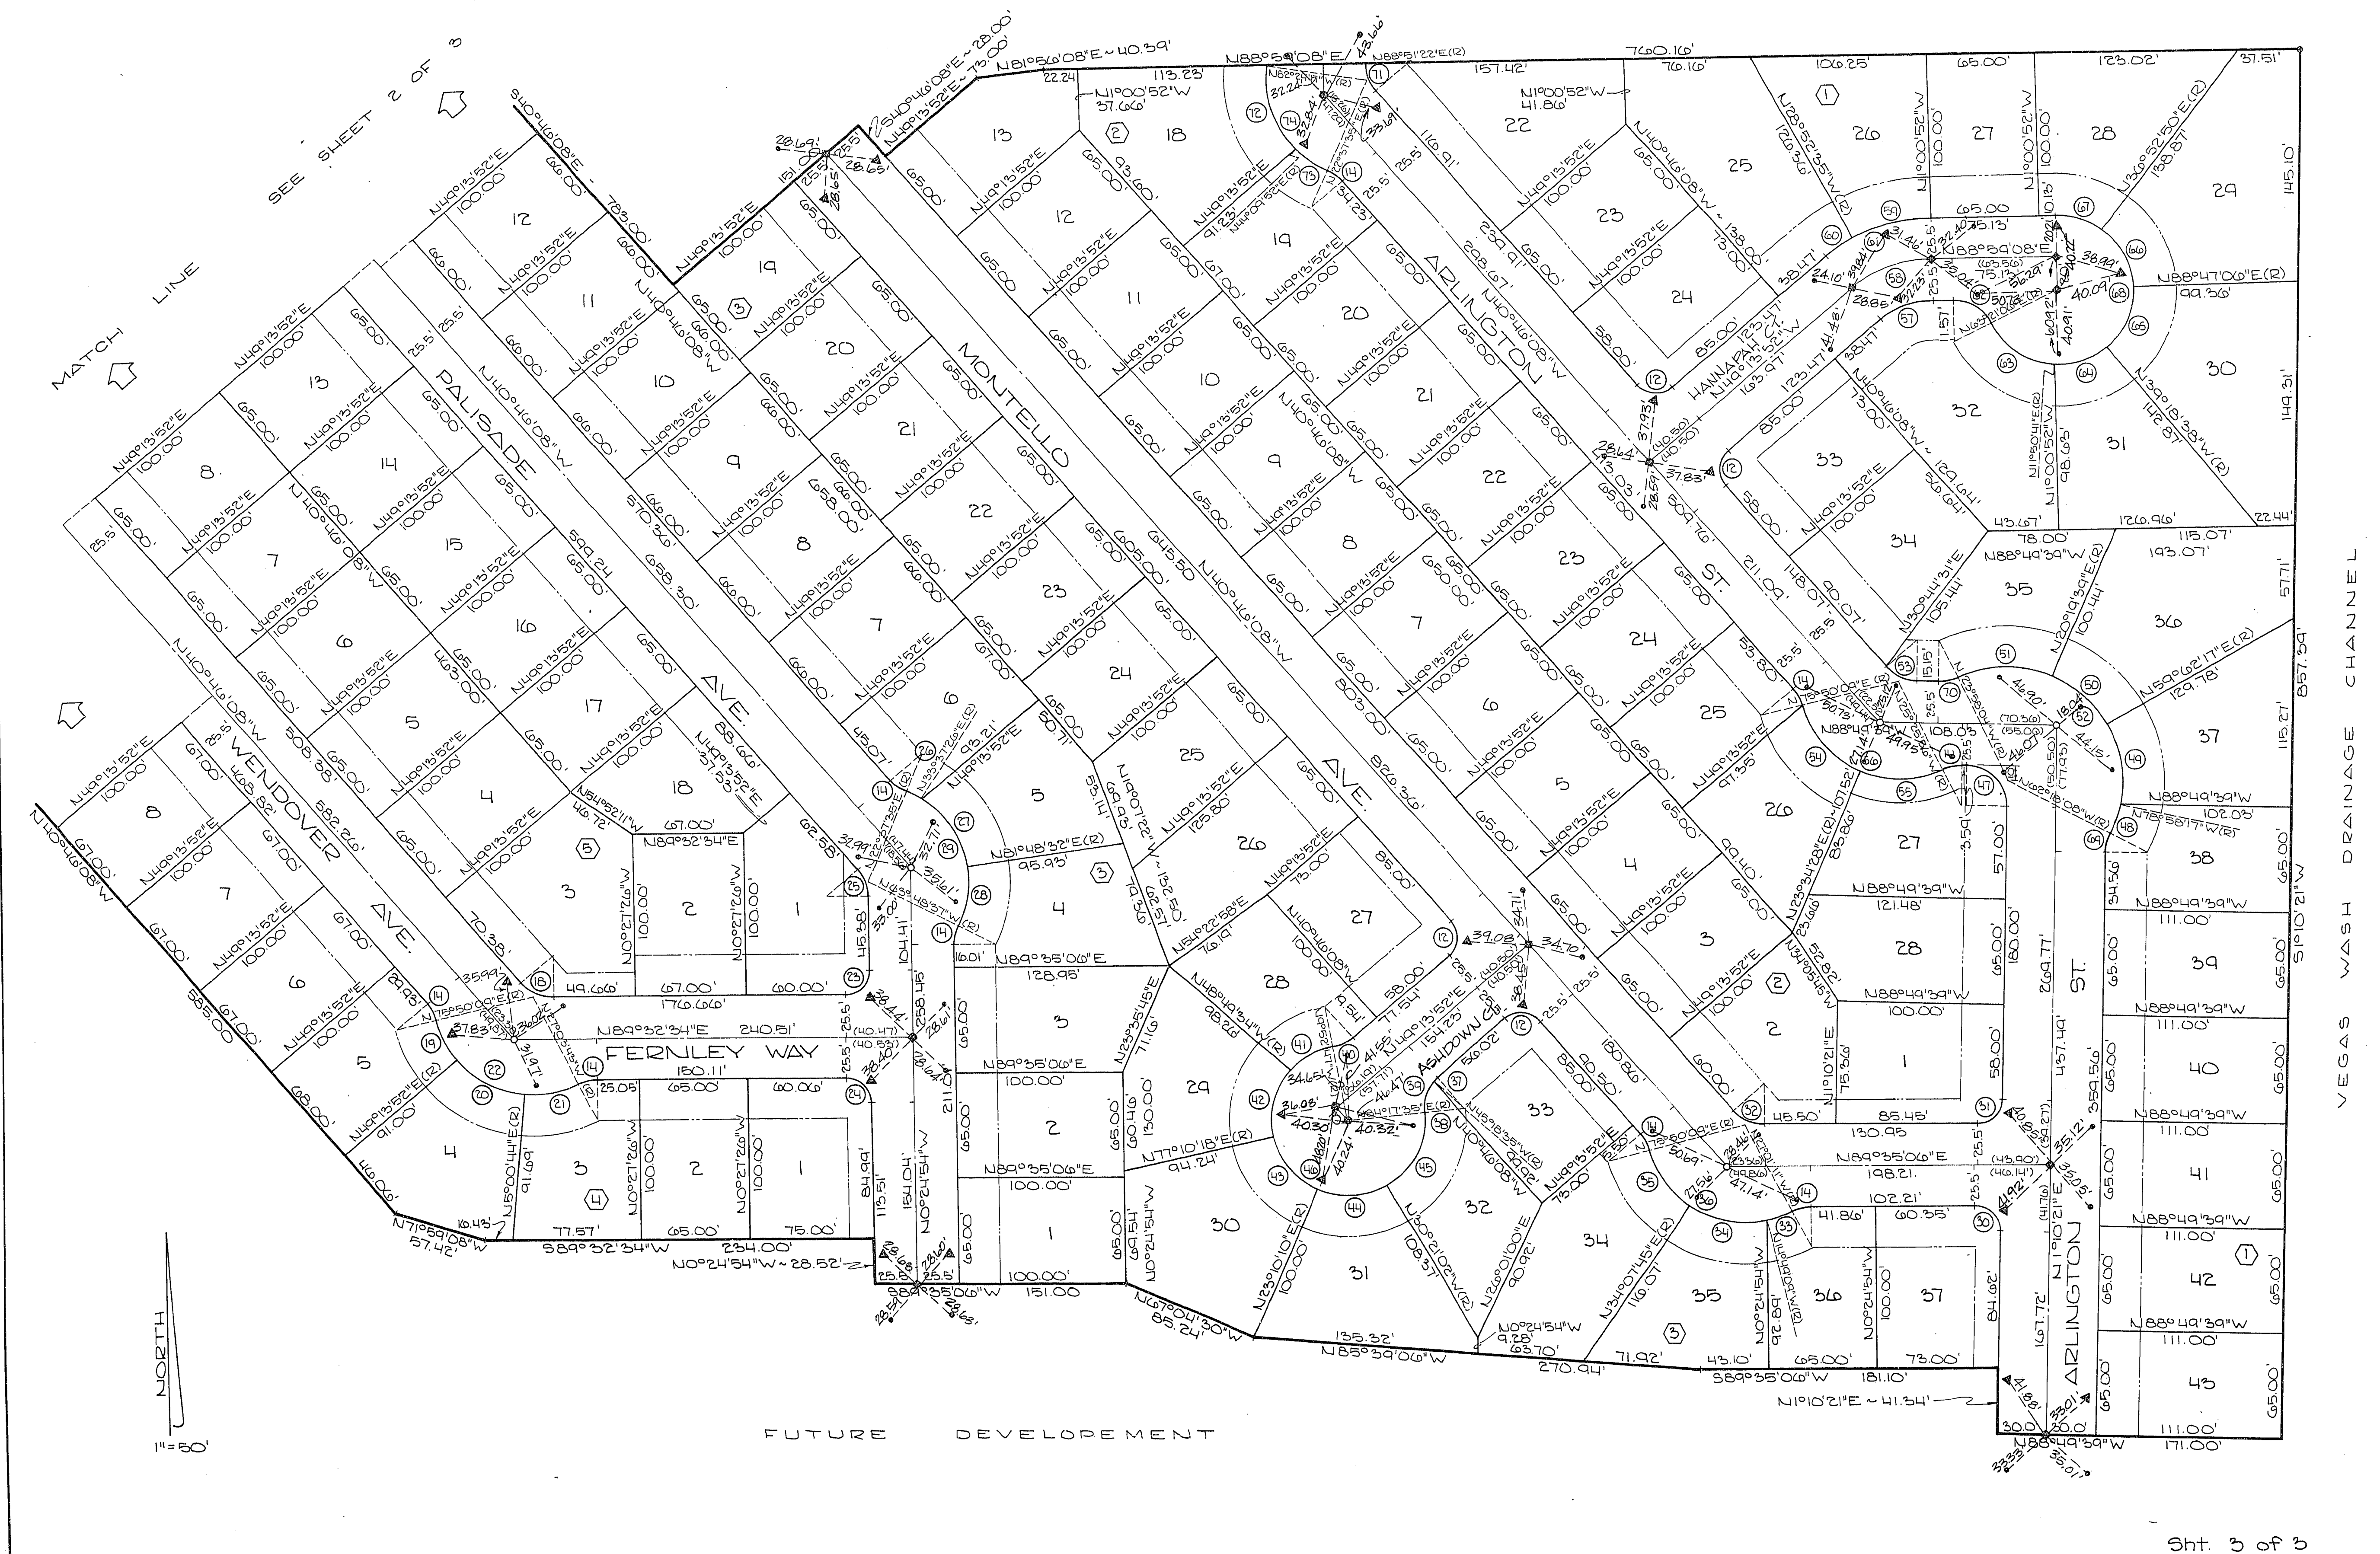

Sht. 3 of 3

05-2825-6A