


SUNWOOD

SUBDIVISION

THE SOUTHEAST 1/4, OF THE SOUTHWEST 1/4, SECTION 29, TOWNSHIP 20 SOUTH, RANGE 62 EAST, M.D.B.&M. CLARK COUNTY NEVADA TRACT 1

NORTH

Scale 1" = 100.00'

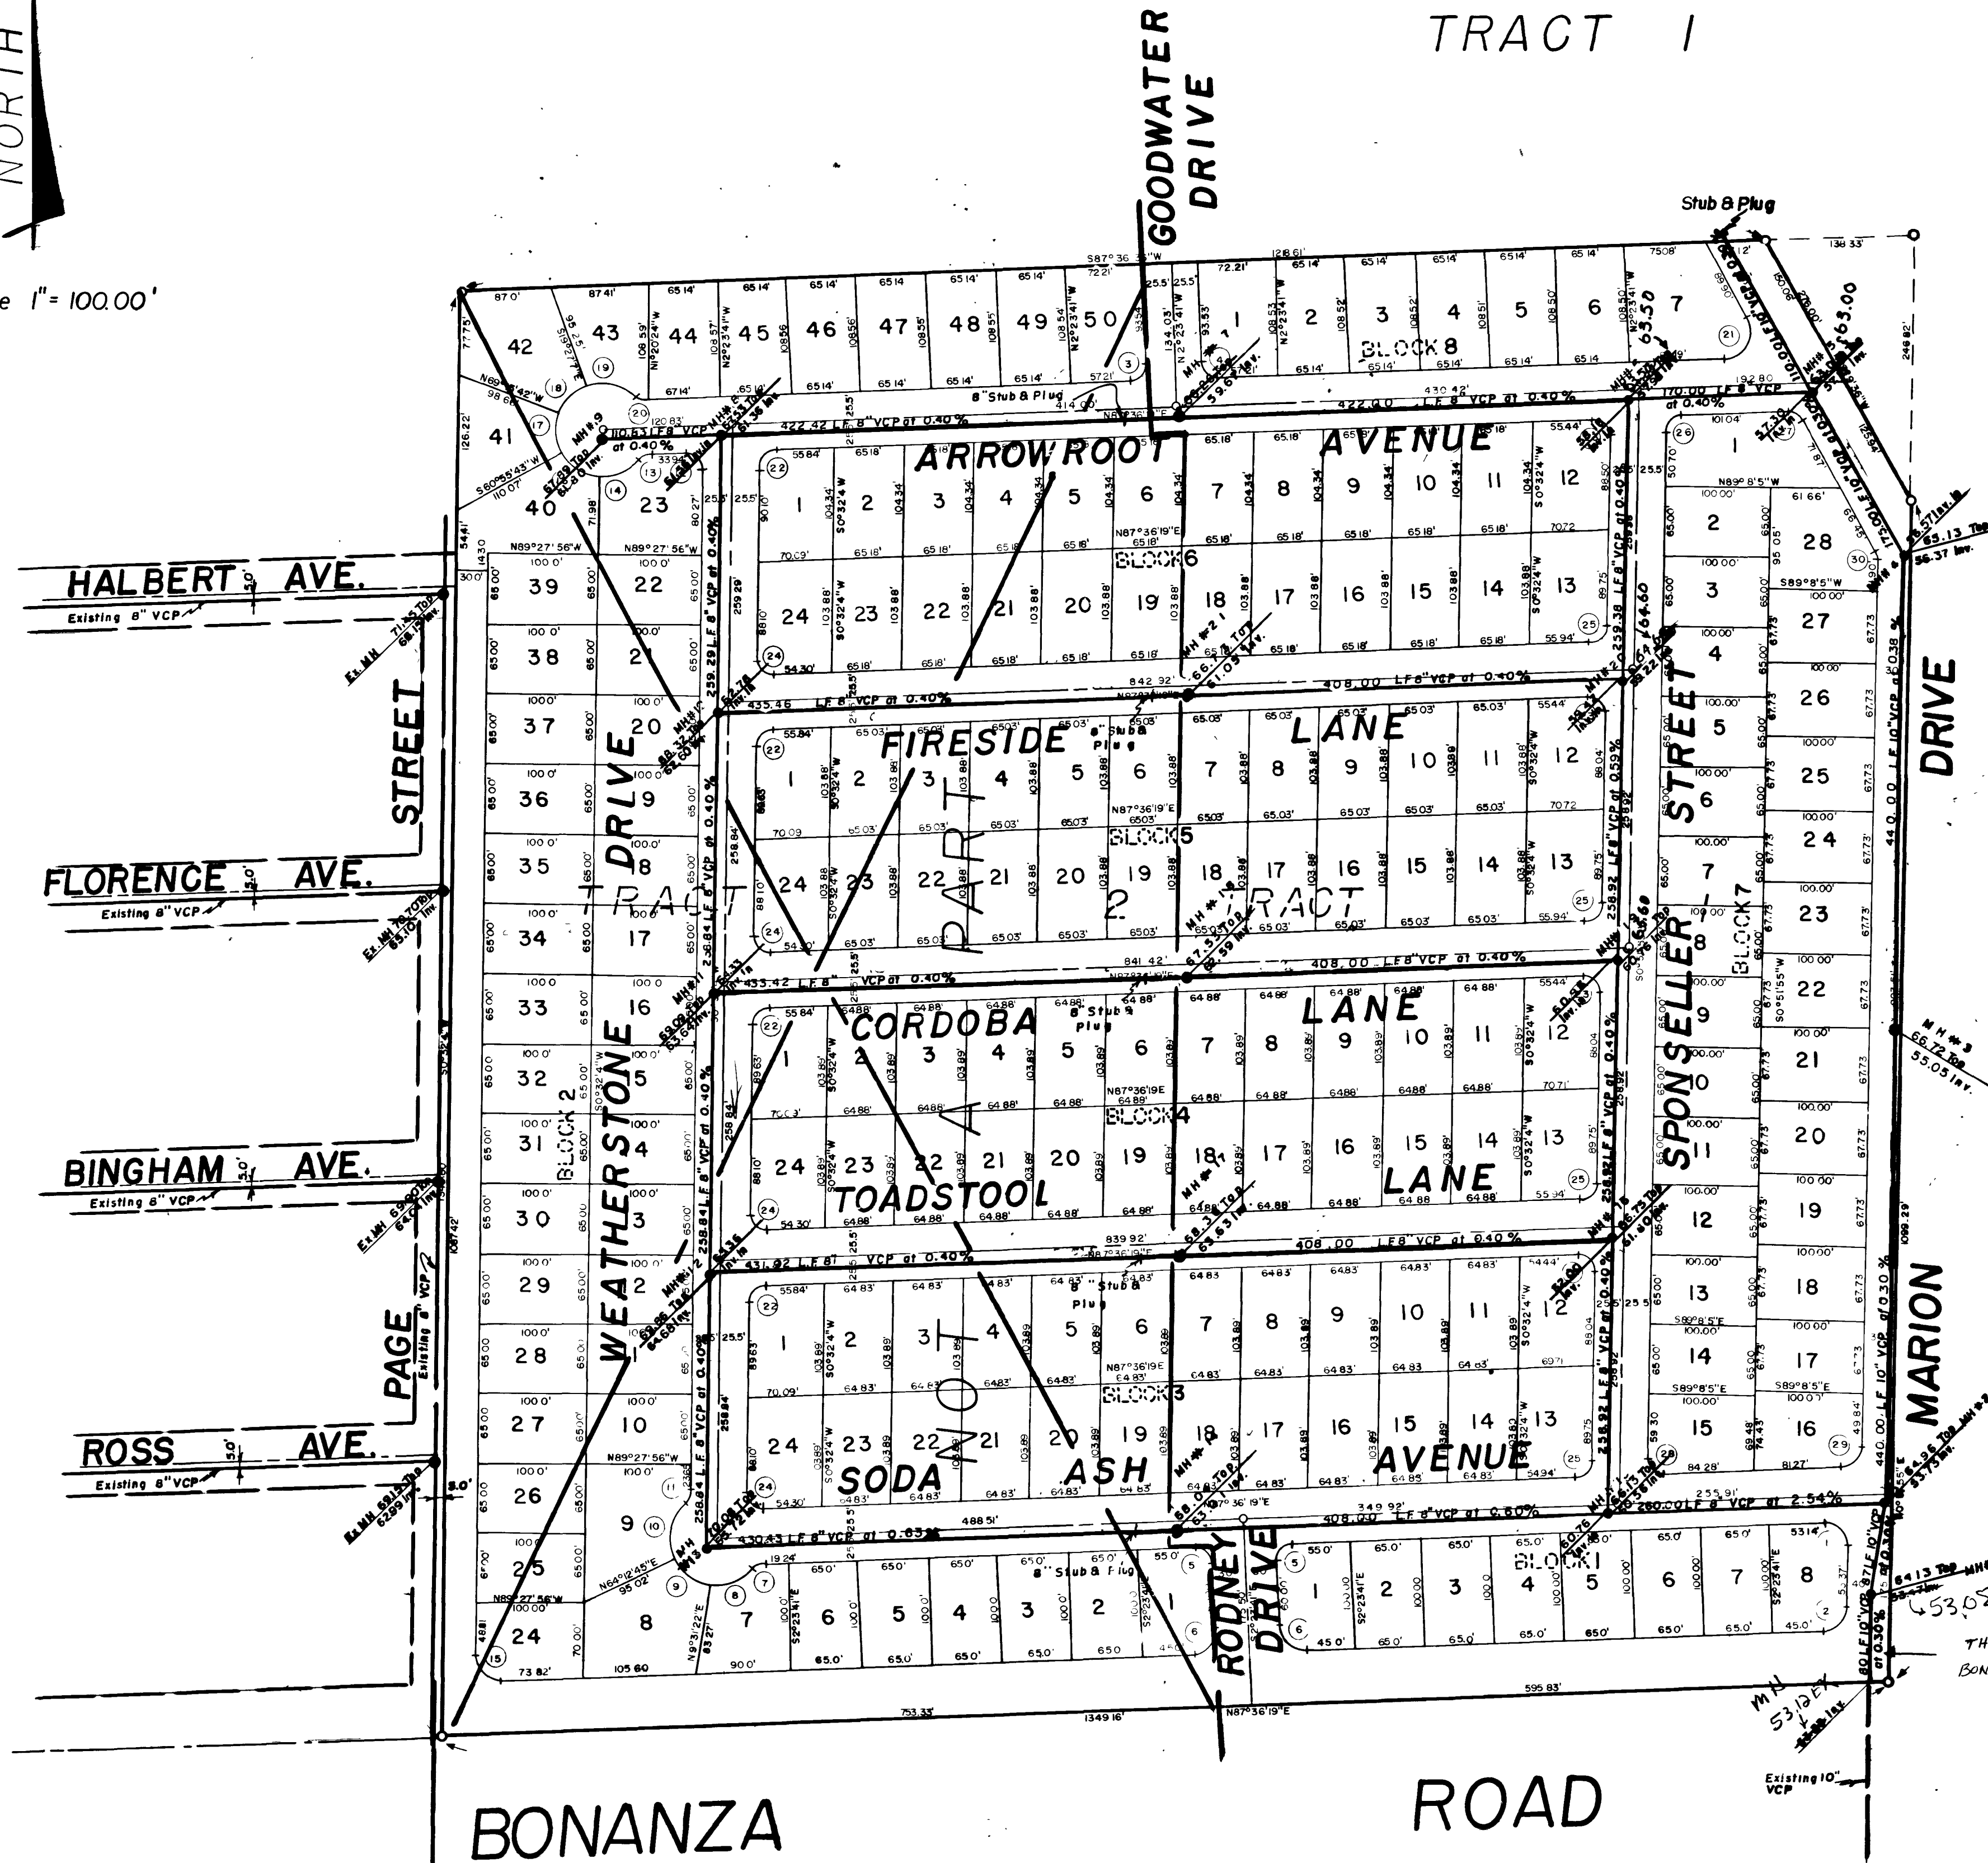

MATERIALS LIST

TRACT 1

15 each Manholes
1332.00 L.F. 10" PVC Sewer Main
4273.25 L.F. 8" PVC Sewer Main
1 each 10" Plug
91 each 4" VCP Service Laterals

TRACT 2

6 each Manholes
1510.00 L.F. 8" VCP Sewer Main
98 each 4" VCP Service Laterals

APPROVALS

FOR UNIT 1 ONLY

City Sanitation Engineer	Date 5-15-84	City Engineer	Date 6/26/84
City Quality Control Engineer	Date 6/26/84	City Consulting Engineer	Date 7/26/84
City Field Operations Engineer	Date	City Land Development & Flood Control	Date 8/15/84


BENCH MARK

CLV Bench # 0623001
Corner of Lamb Blvd & Bonanza Road
Elevation 1773.31

All construction and materials shall be in accordance with the "Uniform Standard Specifications for Public Works Construction Off-site Improvements, Clark County Area Nevada" issued 1978, the "Uniform Standard Drawings for Public Works Construction, Clark County Area", any other applicable approved standards issued by the controlling agency, the Uniform Building Code, and all local City codes and ordinances applicable.

KARSTEN T. BRONKEN
Consulting Engineers
1818 Industrial Road
LAS VEGAS, NEVADA 89102

THIS SECTION OF PIPE INSTALLED WITH
BONANZA RD. & LAID TO THE WING ELEVATIONS

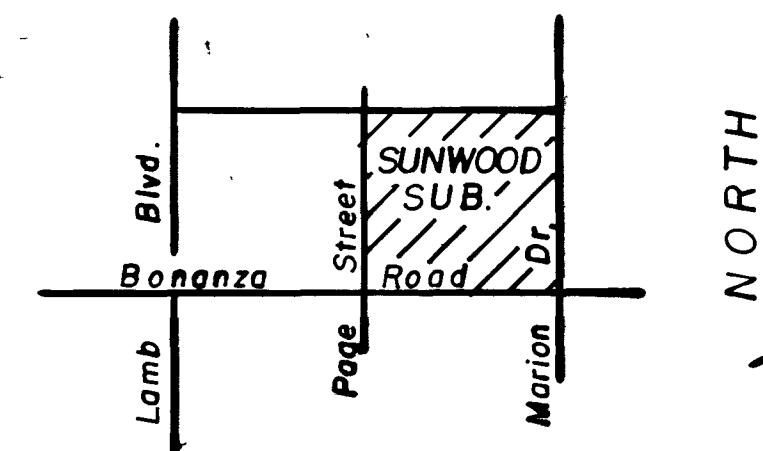

LOCATION MAP

MASTER SEWER PLAN

SHEET 1 OF 7 SHEETS


3074-3042

5335

21-8-46

SUBDIVISION









BENCH MARK


LOCATION MAP

MASTER SEWER PLAN

BONANZA

ROAD

DATE RECEIVED

595

307/- 308/-

• 51-9-101