


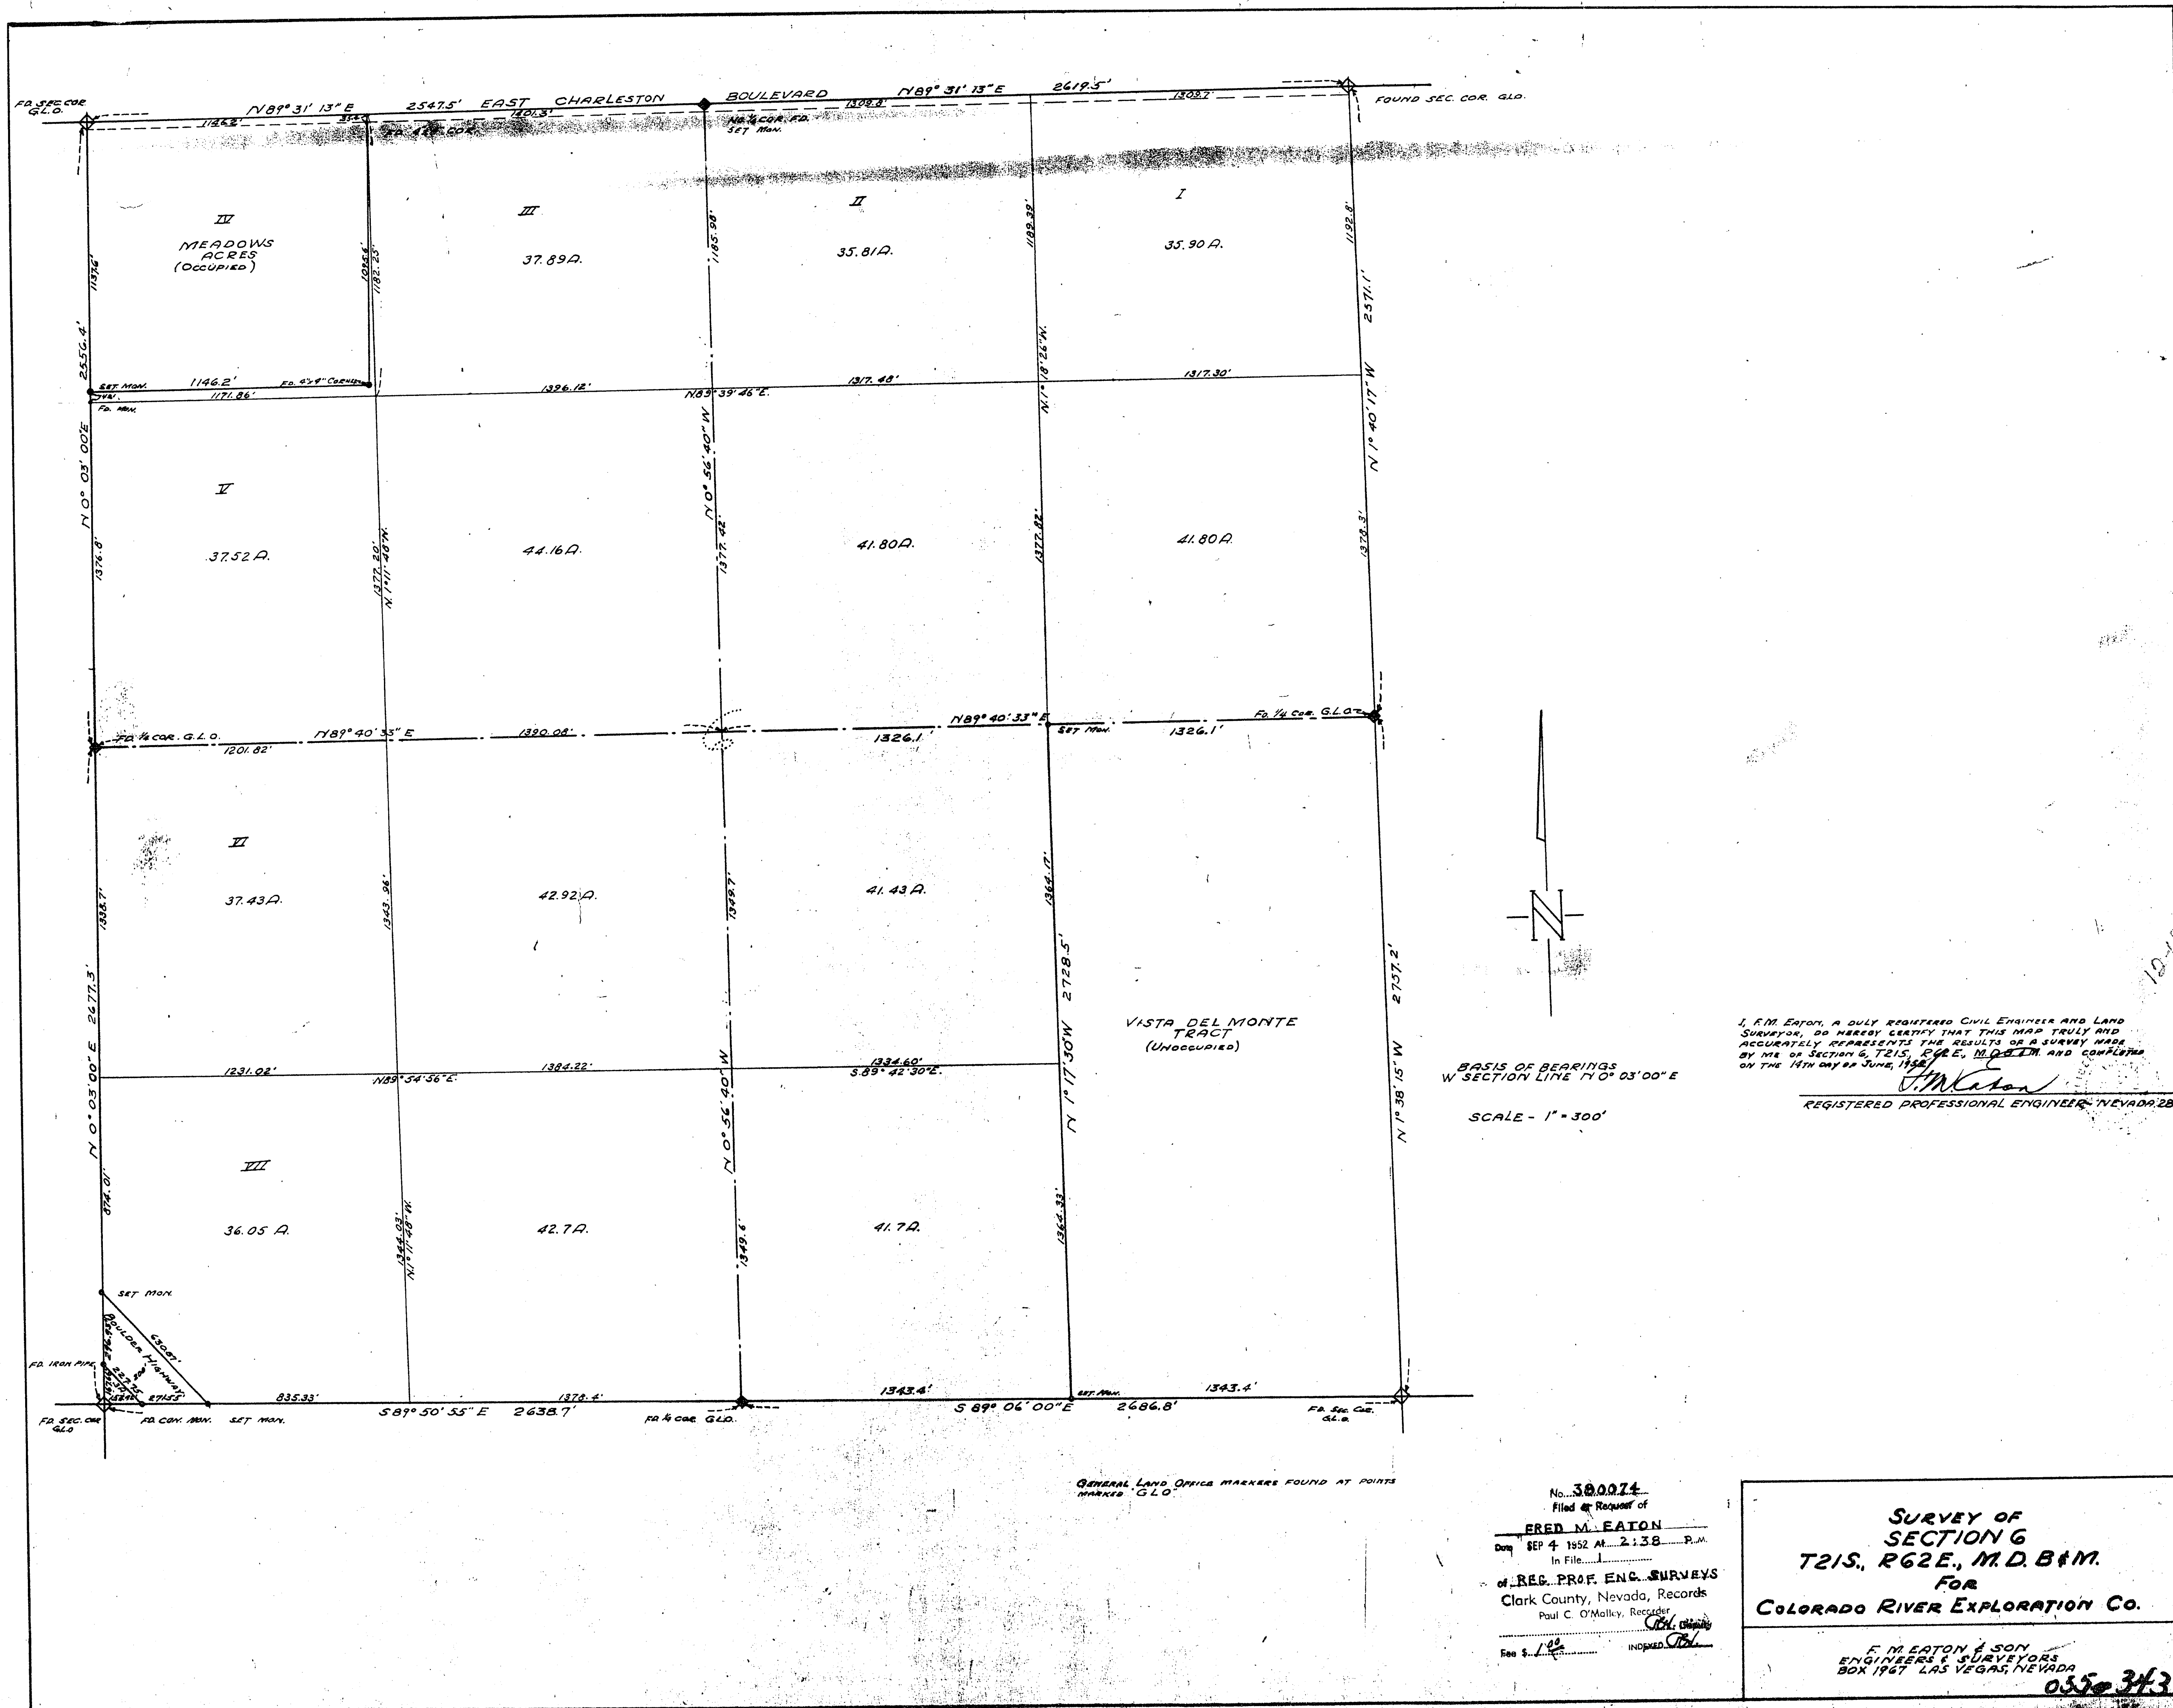

No. 300074
Filed at Request of
FRED M. EATON
Date SEP 4 1952 At 2:38 P.M.
In File.....
of REG. PROF. ENG. SURVEYS
Clark County, Nevada, Records
Paul C. O'Malley, Recorder
Fee \$ 1.00 Indorsed *[Signature]*

**SURVEY OF
SECTION 6
T21S, R62E, M.D.B. & M.
FOR
COLORADO RIVER EXPLORATION CO.**

**F. M. EATON & SON
ENGINEERS & SURVEYORS
BOX 1767 LAS VEGAS, NEVADA**
0550343