

FILED AT THE REQUEST OF
CLARK COUNTY NORTHERN
AUTHORITY BY ROBERT C
DAVE 10-23-61 AT 8:18
IN FILE 10 PAGE
OFFICE PROCEEDINGS 2041
CLARK COUNTY NEVADA REC
PART C WALLEY, ROBERT
RICH DEPU
FEE\$ DN
INDEXED RE


[illegible]

ENGINEER'S CERTIFICATE

Aug 23, 1961 found this
1/4 car, best over, badly corroded
& broken excavated & found foot
of pipe in place 17 ft away
Reset 1/4 car




SCALE 1" = 30"



100 90 80 70 60 50 40 30 20 10 0

PLAT SHOWING
SURVEY OF
SECTION 16, T.21S, R.62E., M.D.B. & M.
CLARK COUNTY, NEVADA
AND PARTING OUT THEREFROM
THE S 1/2 OF THE SW 1/4 OF SAID SECTION.

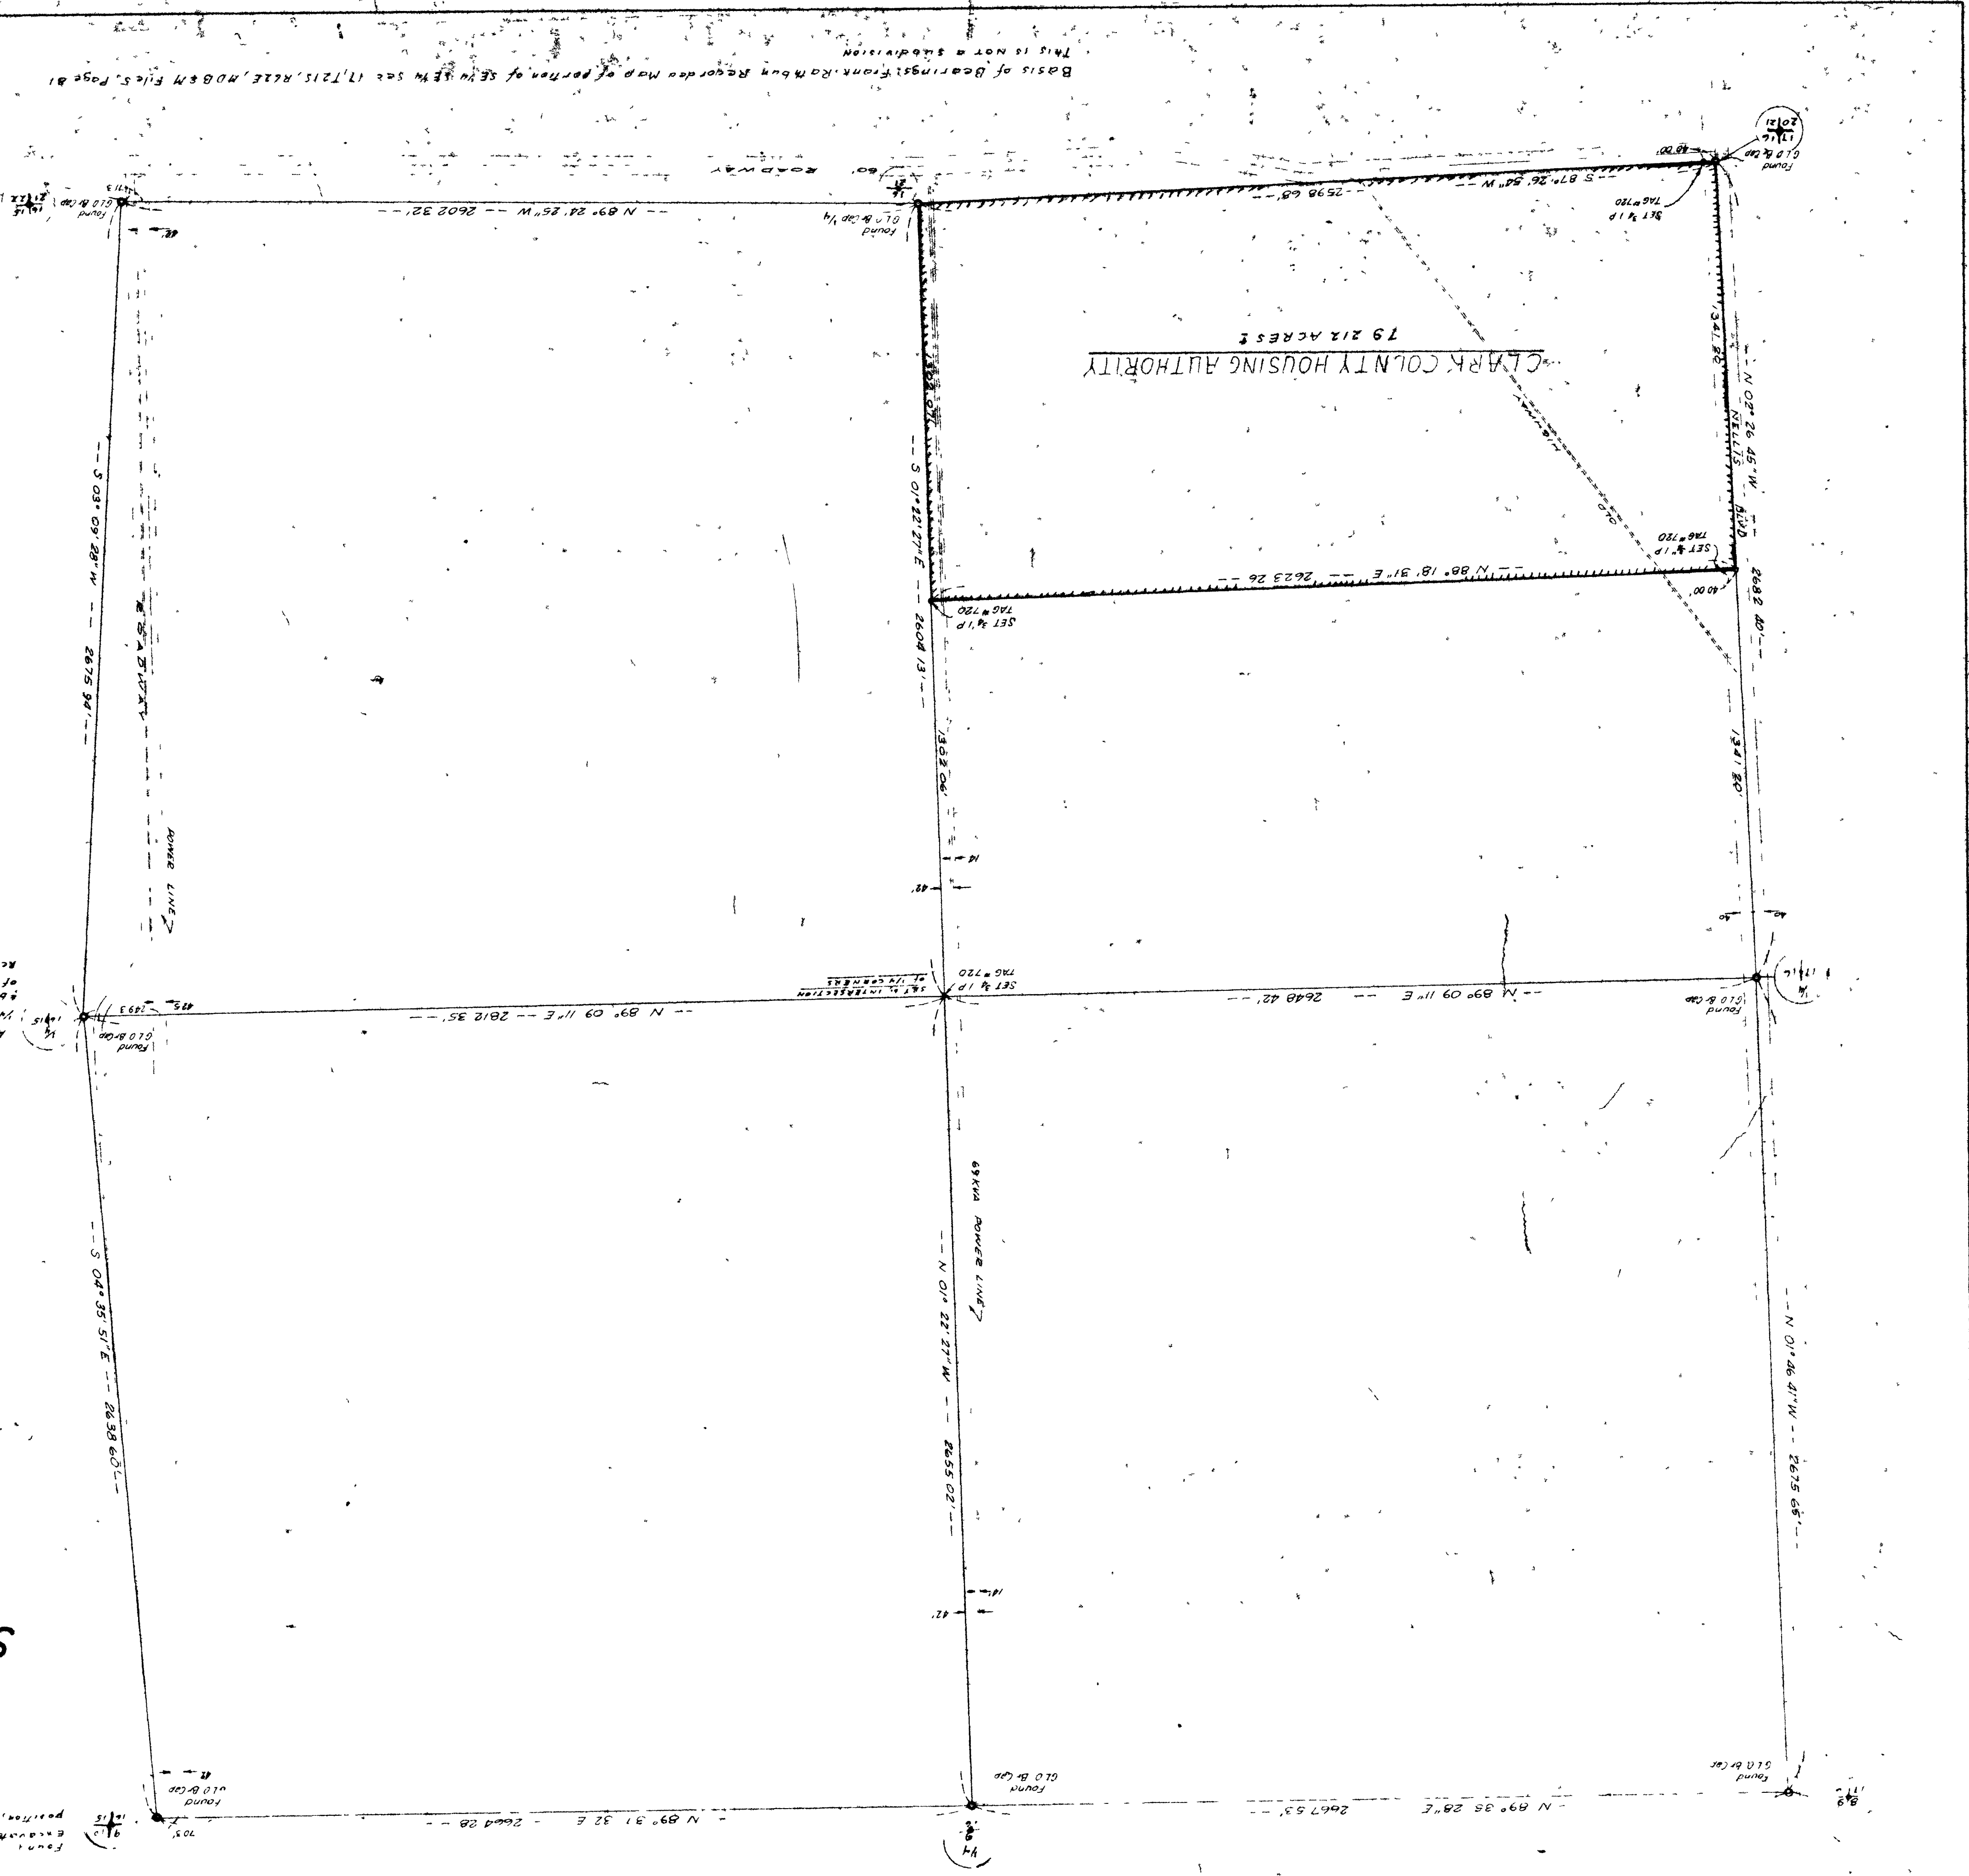





