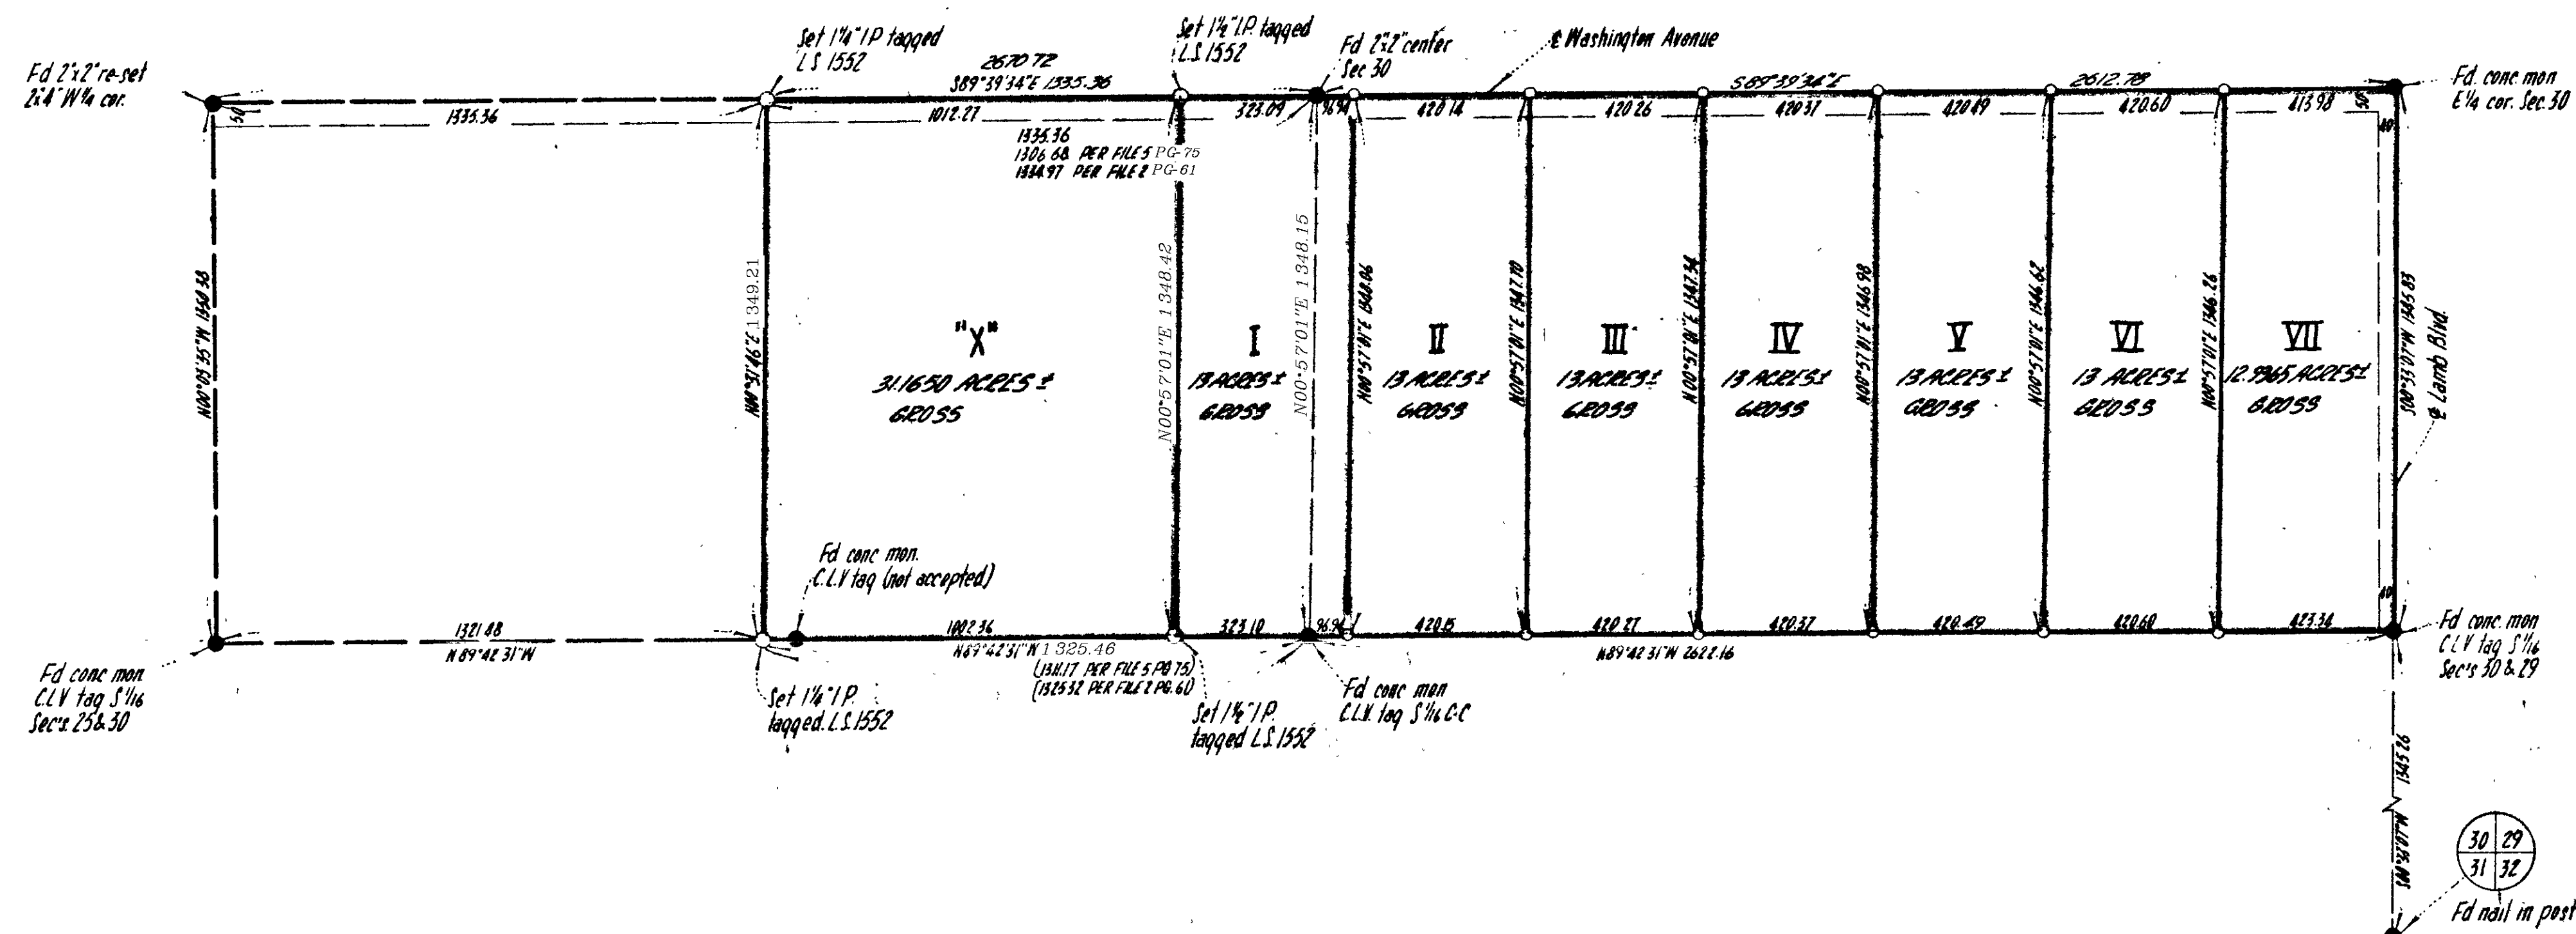


SCALE 1"=300'

**LEGAL DESCRIPTION**

All of the NE 1/4 of the SW 1/4 of Section 30, together with all of the N 1/2, according to Government survey, of the SE 1/4 of said Section 30, T20S, R62E, M.D.M., Nevada

NOTE:

This map is filed to correct erroneous **ACRES** as shown on File 12, Page 33 of Registered Professional Engineers Surveys

BASIS OF BEARINGS

N00°35'07"E for the East line of the SE 1/4 of Section 30, T20S, R62E, M.D.M., Nevada, as shown on a map for Record of Survey on file in the office of the County Recorder of Clark County Nevada, as Page 61 of File 2 in Registered Professional Engineers Surveys

SURVEYOR'S CERTIFICATE

I, James V. Olm, a duly Registered Land Surveyor in the State of Nevada, do hereby certify that the survey of the land shown hereon was made under my direct supervision at the instance of Earl Hartke; the survey was completed on Jan 1, 1963 and that the points found and set are correctly shown hereon. This plot is not intended to be a subdivision.

James V. Olm
Registered Land Surveyor
Nevada Certificate No. 1552

6" indicates set 3/4" IP tagged L.S. 1552 unless otherwise noted.

VOORHEIS-TRINDLE COMPANY OF NEVADA

1120 FREMONT STREET, LAS VEGAS, NEVADA

EV 5-3566

THE NE 1/4, SW 1/4 AND THE N 1/2, SE 1/4 SEC. 30
T20S, R62E, M.D.M. NEVADA

SCALE
1"=300'

DRAWN BY
F. Huber

MAP FOR RECORD OF SURVEY FOR EARL HARTKE

DATE
FEBRUARY 15, 1963

DRAWING NO.
W.D. 172

340625

FILED AT THE REQUEST OF

JAMES V. OLDMAN

Date 2-15-63 at 9:54 A.M.

12 12 50

of Survey

NEVADA RECORDS BOOK NO. 422

CLARK COUNTY, NEVADA, RECORDS

PAUL E. HUBER, RECORDER

Page 2 of 2