SURVEY MAP

PART OF SECTION 6, T21S, R62E, M.D.B.&M.
CLARK COUNTY NEVADA

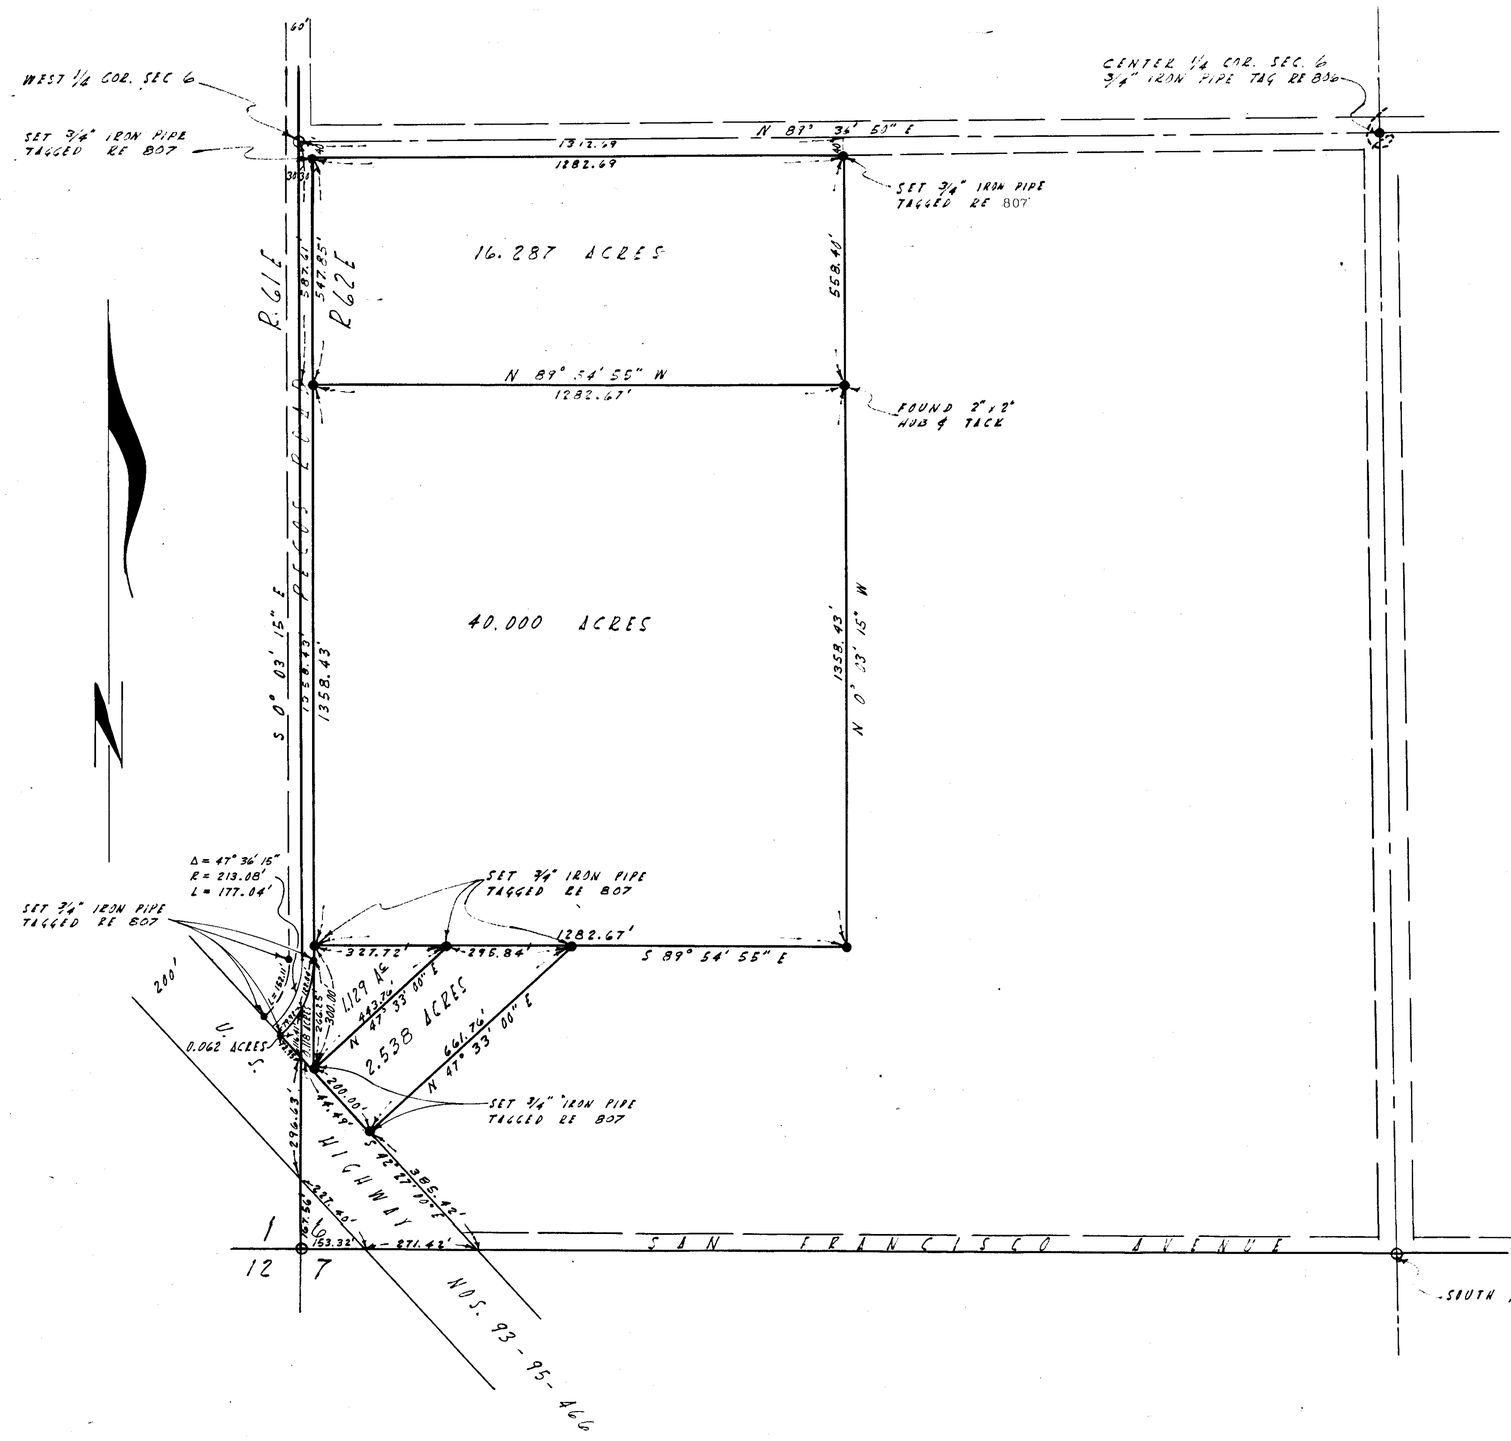

CERTIFICATE —

I, JACK K. LEAVITT, A REGISTERED PROFESSIONAL ENGINEER-LAND SURVEYOR OF THE STATE OF NEVADA DO HEREBY CERTIFY THAT THIS MAP IS A TRUE AND ACCURATE REPRESENTATION OF THE LANDS SHOWN HEREON. ALL POINTS FOUND OR SET ARE CORRECTLY DESIGNATED. THIS SURVEY WAS COMPLETED ON AUGUST 11, 1961 AND WAS PERFORMED AT THE INSTANCE OF CAMPBELL REALTY CO.. THIS SURVEY DOES NOT CONSTITUTE A SUBDIVISION AS DEFINED BY NEVADA STATE LAW.

JACK K. LEAVITT
REGISTERED PROFESSIONAL ENGINEER
LAND SURVEYOR RE 807

LEGEND —

● INDICATES POINT SET - 3/4" IRON PIPE TAGGED RE 807
○ INDICATES POINT FOUND - AS SHOWN
SCALE 1" = 200.00'
BASIS OF BEARING: U.S. HIGHWAY NOS. 93-95-466 N 42°27'00" W

NOTE —

THE PARCELS INDICATED HEREON ARE NOT DIVIDED FOR THE PURPOSE OF SALE AND DO NOT CONSTITUTE A SUBDIVISION AS DEFINED BY NEVADA STATE LAWS. THEREFORE, NO REFERENCE TO THIS MAP SHOULD BE MADE IN ANY DEED OR CONVEYANCE.

10-38

NO. .....
FILED AT THE REQUEST OF
JACK K LEAVITT
Date 8-14-61 at 9:29 AM
FILE 10 PAGE 37
Reg. Prof. Eng. Surveys
OFFICIAL RECORDS, BOOK NO. 313
CLARK COUNTY, NEVADA, RECORDS
PAUL C. O'MALLEY, RECORDER
Fee $ 2.50 P.E.H. Deputy

SURVEY MAP
PART OF SECTION 6, T21S, R62E, M.D.B.&M.
CLARK COUNTY NEVADA

SURVEYED BY
JACK K. LEAVITT
REGISTERED PROFESSIONAL ENGINEER
LAND SURVEYOR NO. 807

055-224