


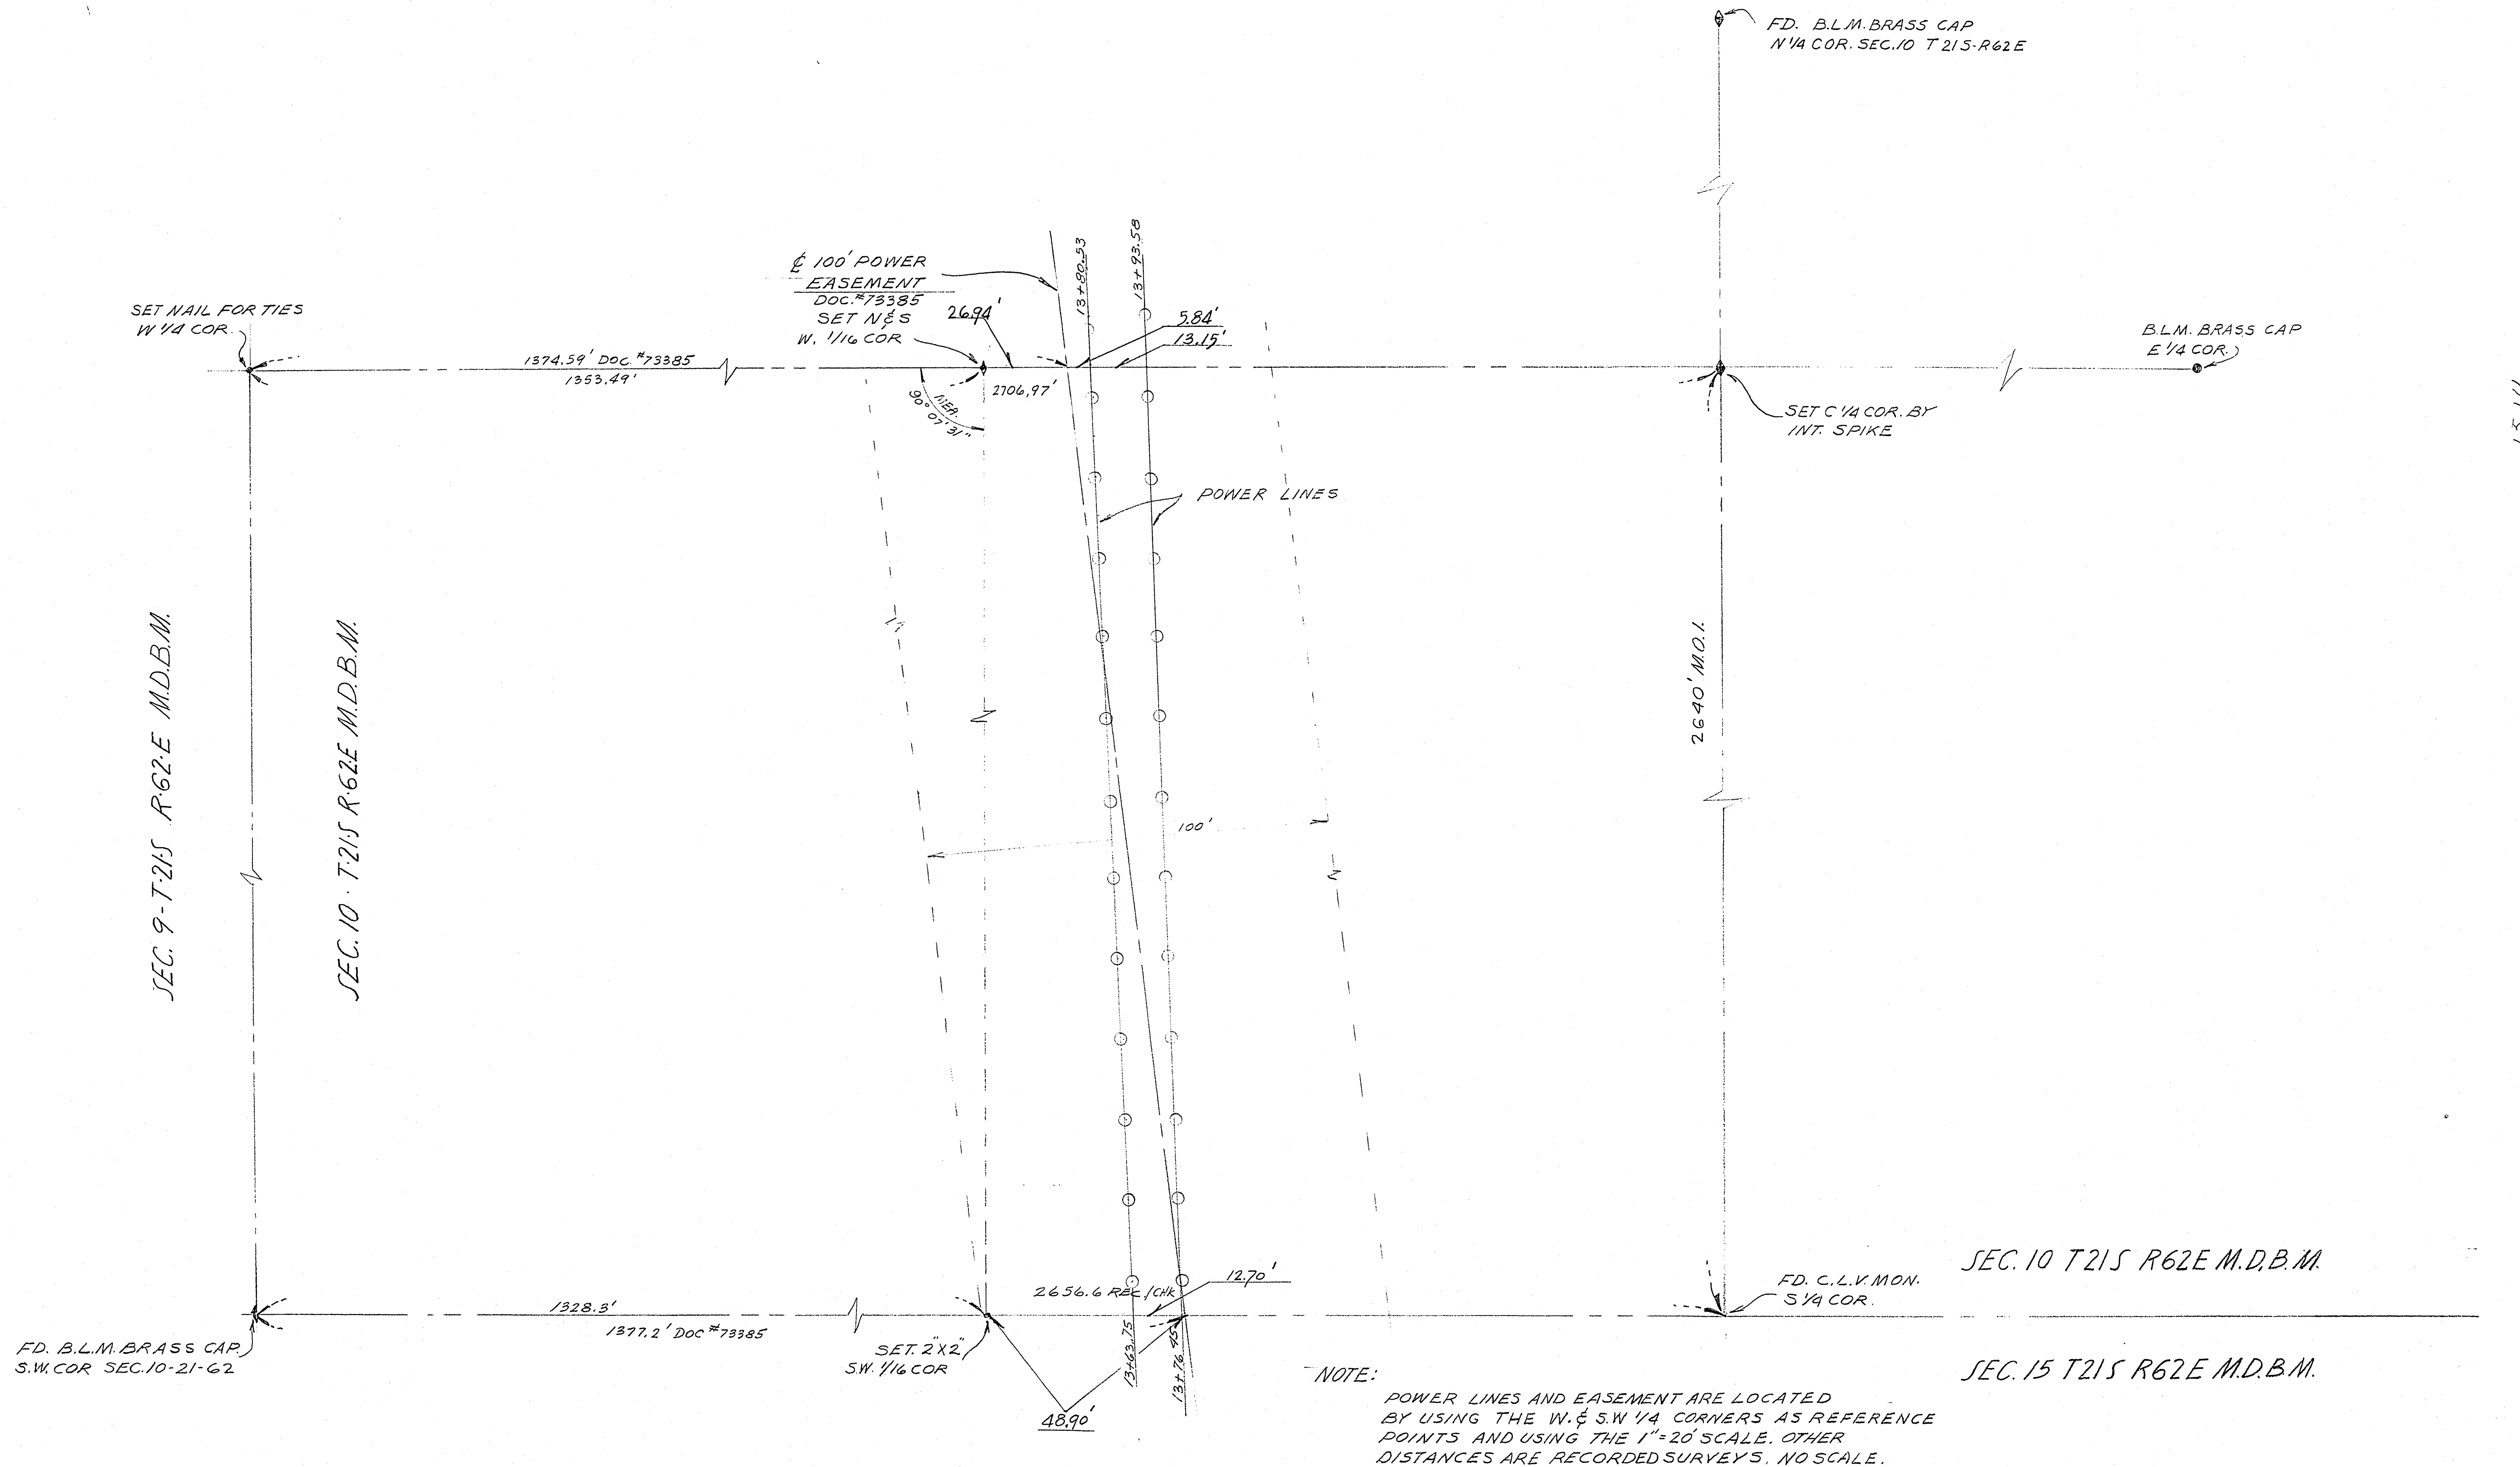

NOTE:
POWER LINES AND EASEMENT ARE LOCATED
BY USING THE W. & S.W. 1/4 CORNERS AS REFERENCE
POINTS AND USING THE 1"=20' SCALE. OTHER
DISTANCES ARE RECORDED SURVEYS. NO SCALE.

CITY OF LAS VEGAS NEVADA ENGINEERING DEPT.			
LOCATION OF LINCOLN COUNTY POWER LINE IN THE S. 1/2 OF SEC. 10-21-62			
DES. SURVEYED-DITMER	DATE 6/21/66	SC. (H) AS SHOWN	
DR. DODD	6/22/66	SC. (V) F.BK. NO. 60-7X	
CKD.		P.J.O. NO.	
APPROVED BY CITY ENGR.		DRAWING NO.	056-70

15-14