



7-6-93

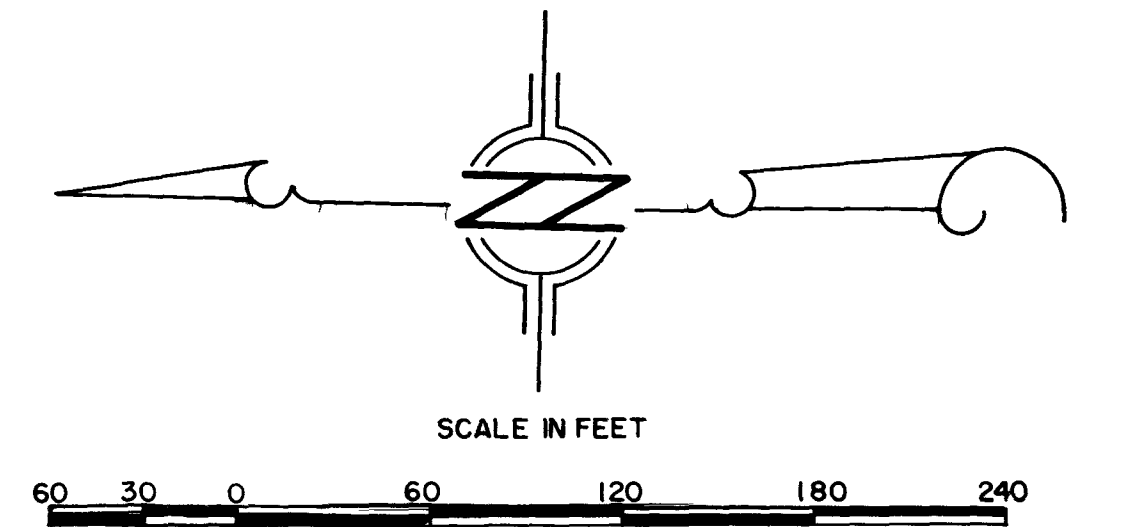

TREASURE PARK UNIT N° 1

BEING A PORTION OF THE S.E. 1/4 OF SEC. 31, T20S, R62E.
M.D.B. & M.
CITY OF LAS VEGAS, COUNTY OF CLARK, STATE OF NEVADA

- SET CONCRETE MONUMENT TAGGED R.E. 560
REFERENCE TIES ARE IN LINE, MARKED BY (X) CUT IN TOP
OF CURB.
- INDICATES 2" X 2" HUB & TACK, EXCEPT AS SHOWN OTHERWISE

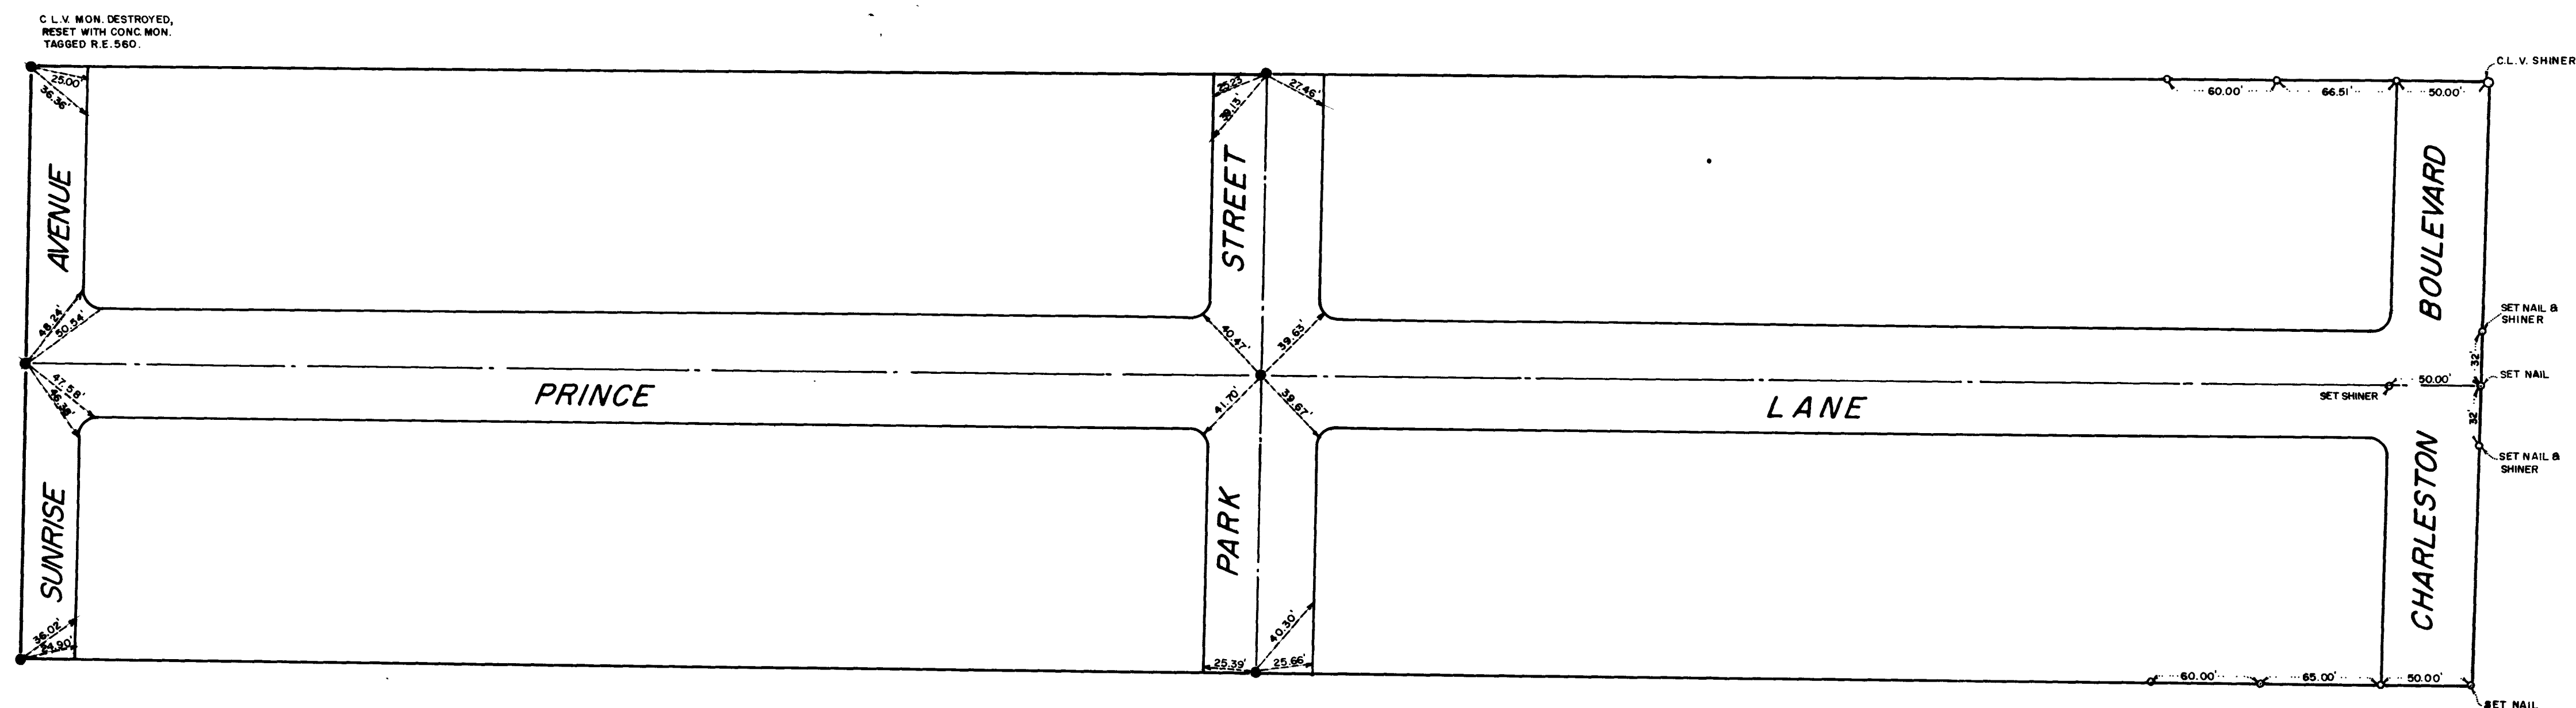

MONUMENT TIES TREASURE PARK UNIT N° 1

DESIGNED BY: _____	SCALE: AS SHOWN	DATE: FEB. 11, 1993	SHEET: 1
DRAWN BY: M.R.			
CHECKED BY: B.J.V.			

TYSON ENGINEERING COMPANY
CONSULTING ENGINEERS
1209 COMMERCE STREET LAS VEGAS, NEV.

OF 1 SHEETS

2844


253-30701

7-6-93

TREASURE PARK UNIT N° 1




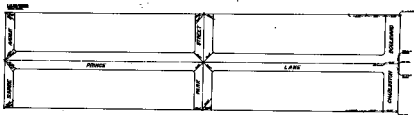

MONUMENT TIES
TREASURE PARK
UNIT N° 1

