


7-6-91

BOOK 1765

727500

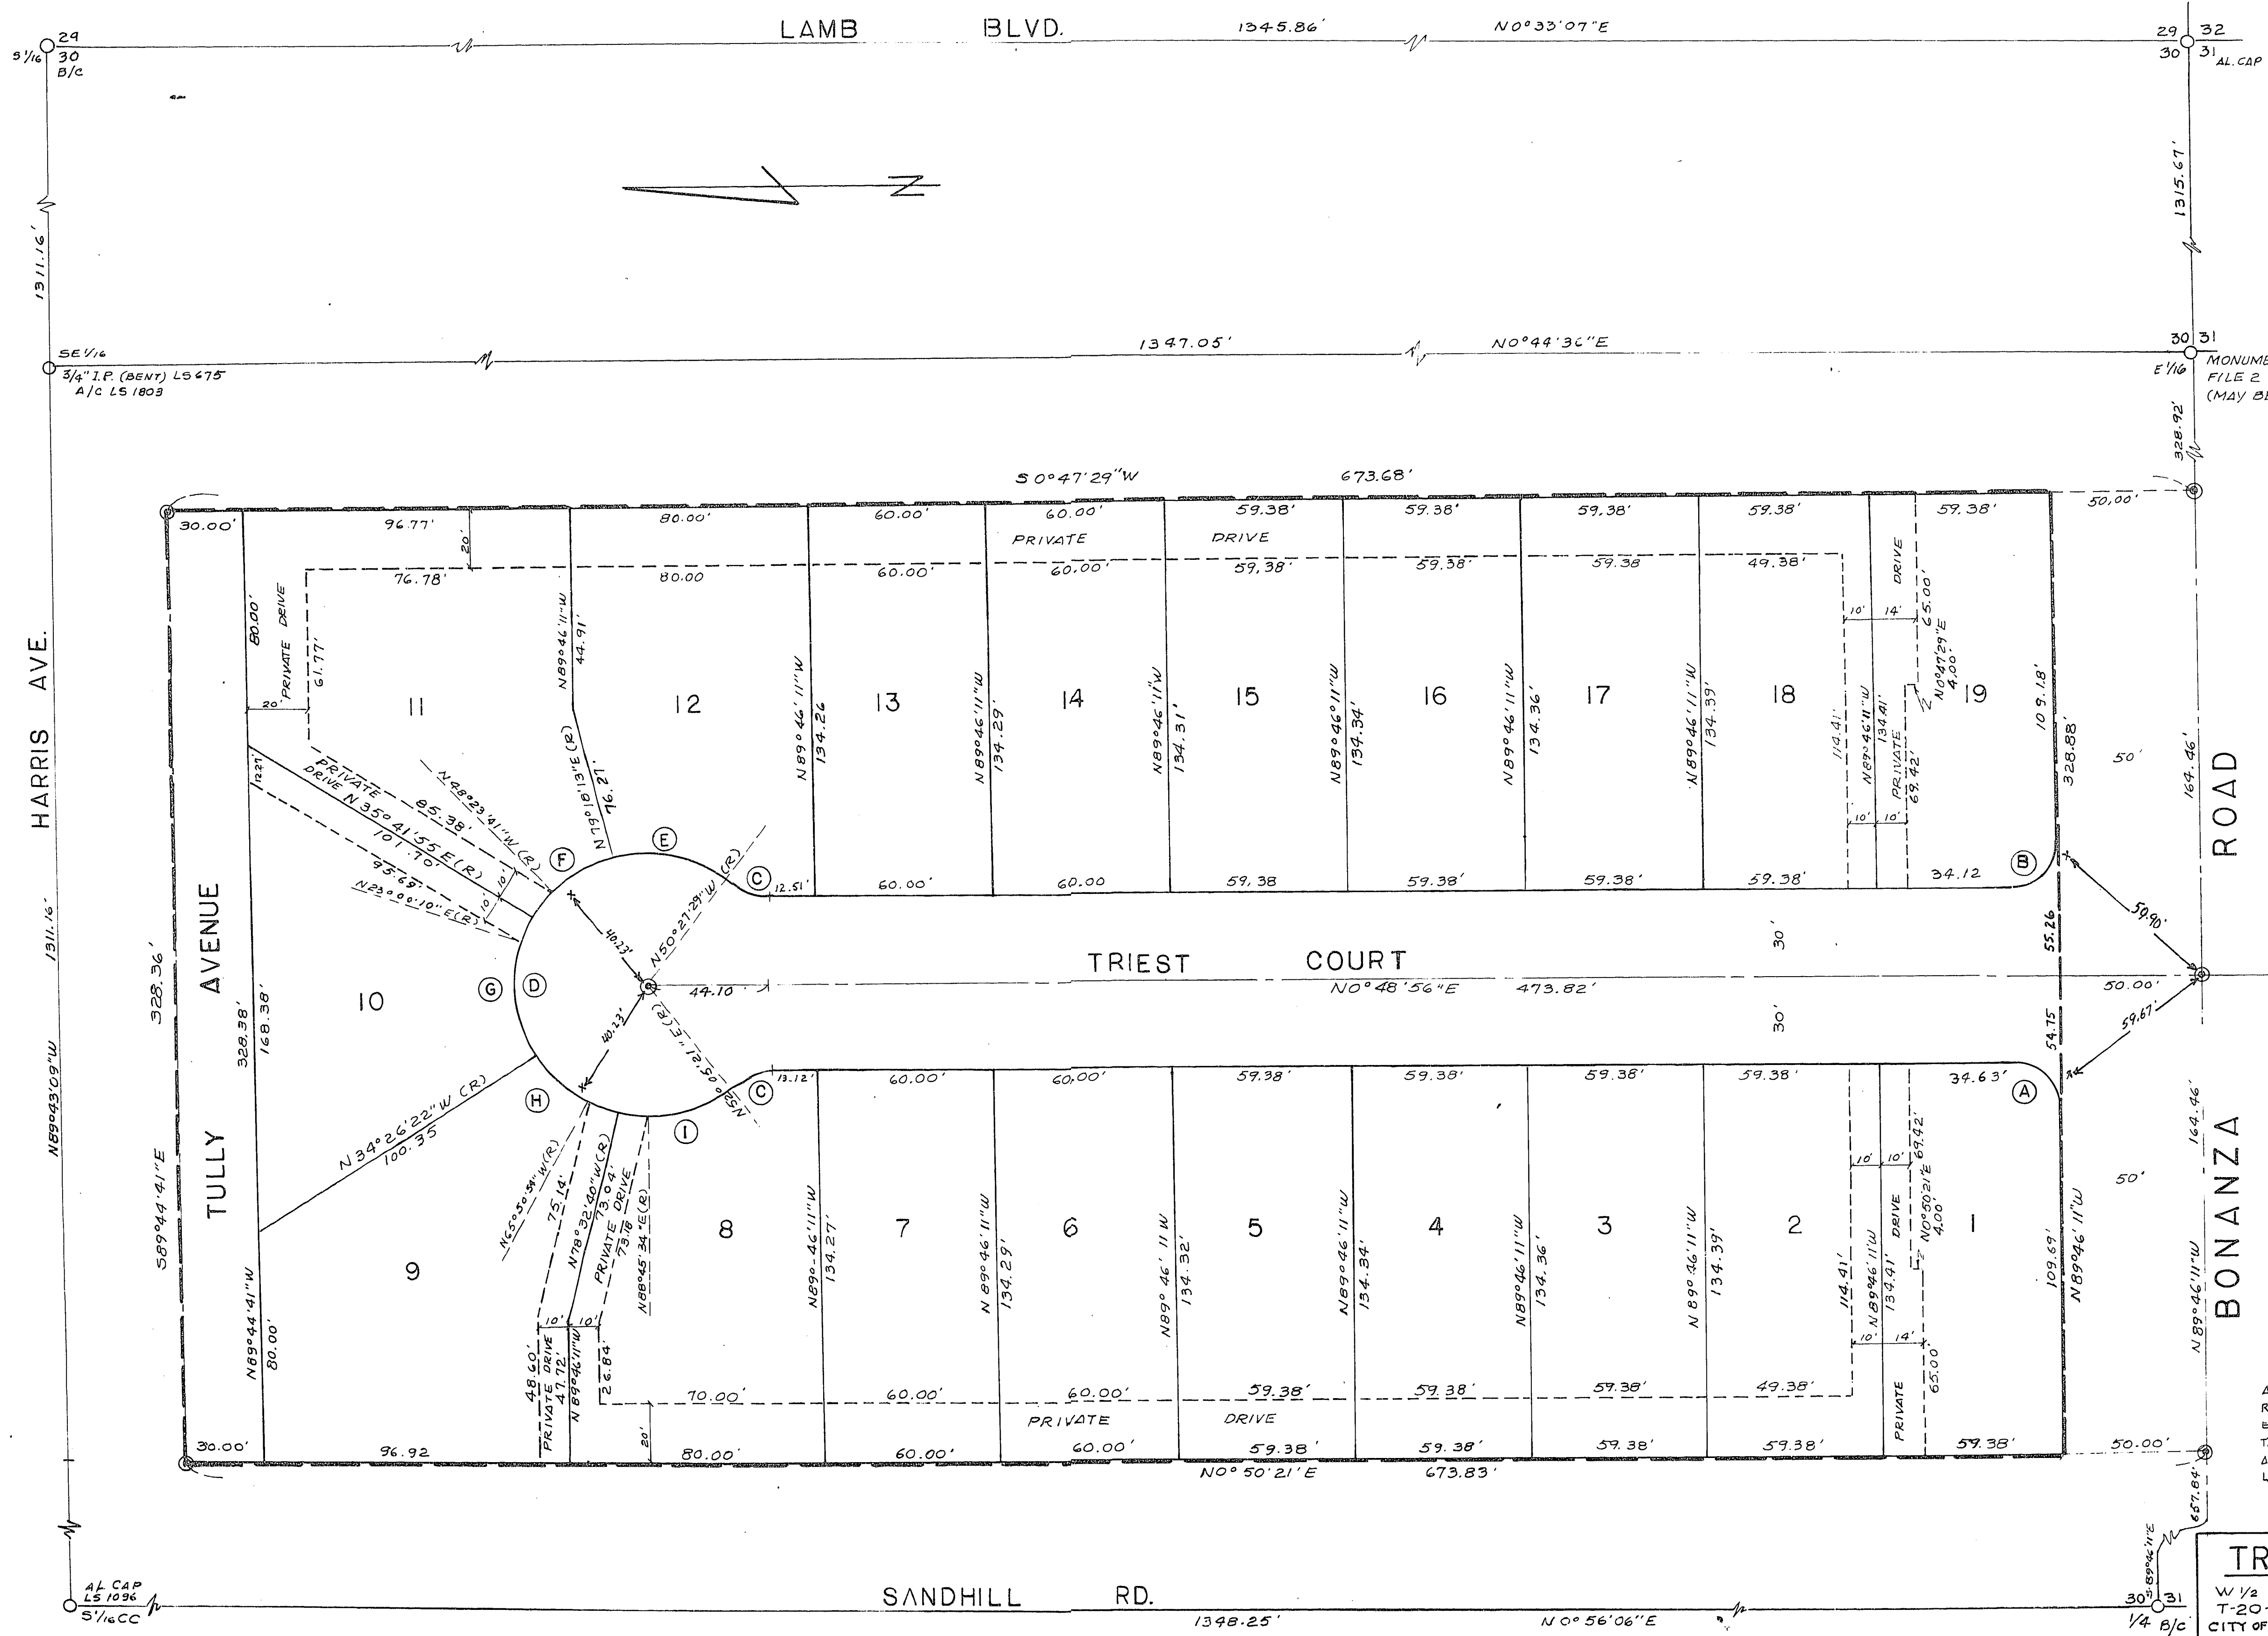

MONUMENT MAP
I CERTIFY THAT THE BRASS CAPS SET AS REFERENCE POINTS TO THE CORNERS AS INDICATED HEREON HAVE BEEN SET AND STAMPED WITH THE DISTANCES AS NOTED HEREON IN FULL ACCORDANCE WITH THE SPECIFICATIONS OF THE CITY SURVEYOR AND COMPLETED THIS 17TH DAY OF JANUARY 1985.

David F. Causey
RCE & RLS 1811

TRIESTE COURT
W 1/2 SE 1/4 SW 1/4 SE 1/4 SECTION 30
T-20-S-R-62-E, M.D.M
CITY OF LAS VEGAS, CLARK COUNTY NEVADA

CAUSEY ENGINEERING SERVICE
P.O. BOX 14846-LAS VEGAS, NEVADA 89114
TELEPHONE 702-733-5850

JOB NO. 7475-3
SHEET 2 OF 2

SCALE
1" = 30'
JDH

REVISIONS	BY	DATE

IMPROVEMENT PLANS OF TRIESTE COURT
MONUMENT MAP
FINAL MAP PLAN SHEET

SECTION 30
TOWNSHIP 20 SOUTH, RANGE 62 EAST, MOUNT DIABLO MERIDIAN
CITY OF LAS VEGAS, CLARK COUNTY, NEVADA

FOR HUTCHINS ENTERPRISES
SCALE 1" = 30' DRAWN BY J.D.H.

CAUSEY ENGINEERING SERVICE
ENGINEERS PLANNERS SURVEYORS
P.O. BOX 14846
LAS VEGAS, NEVADA 89114

JOB NO. 7475-3	SHEET 5 OF 6
--------------------------	------------------------------