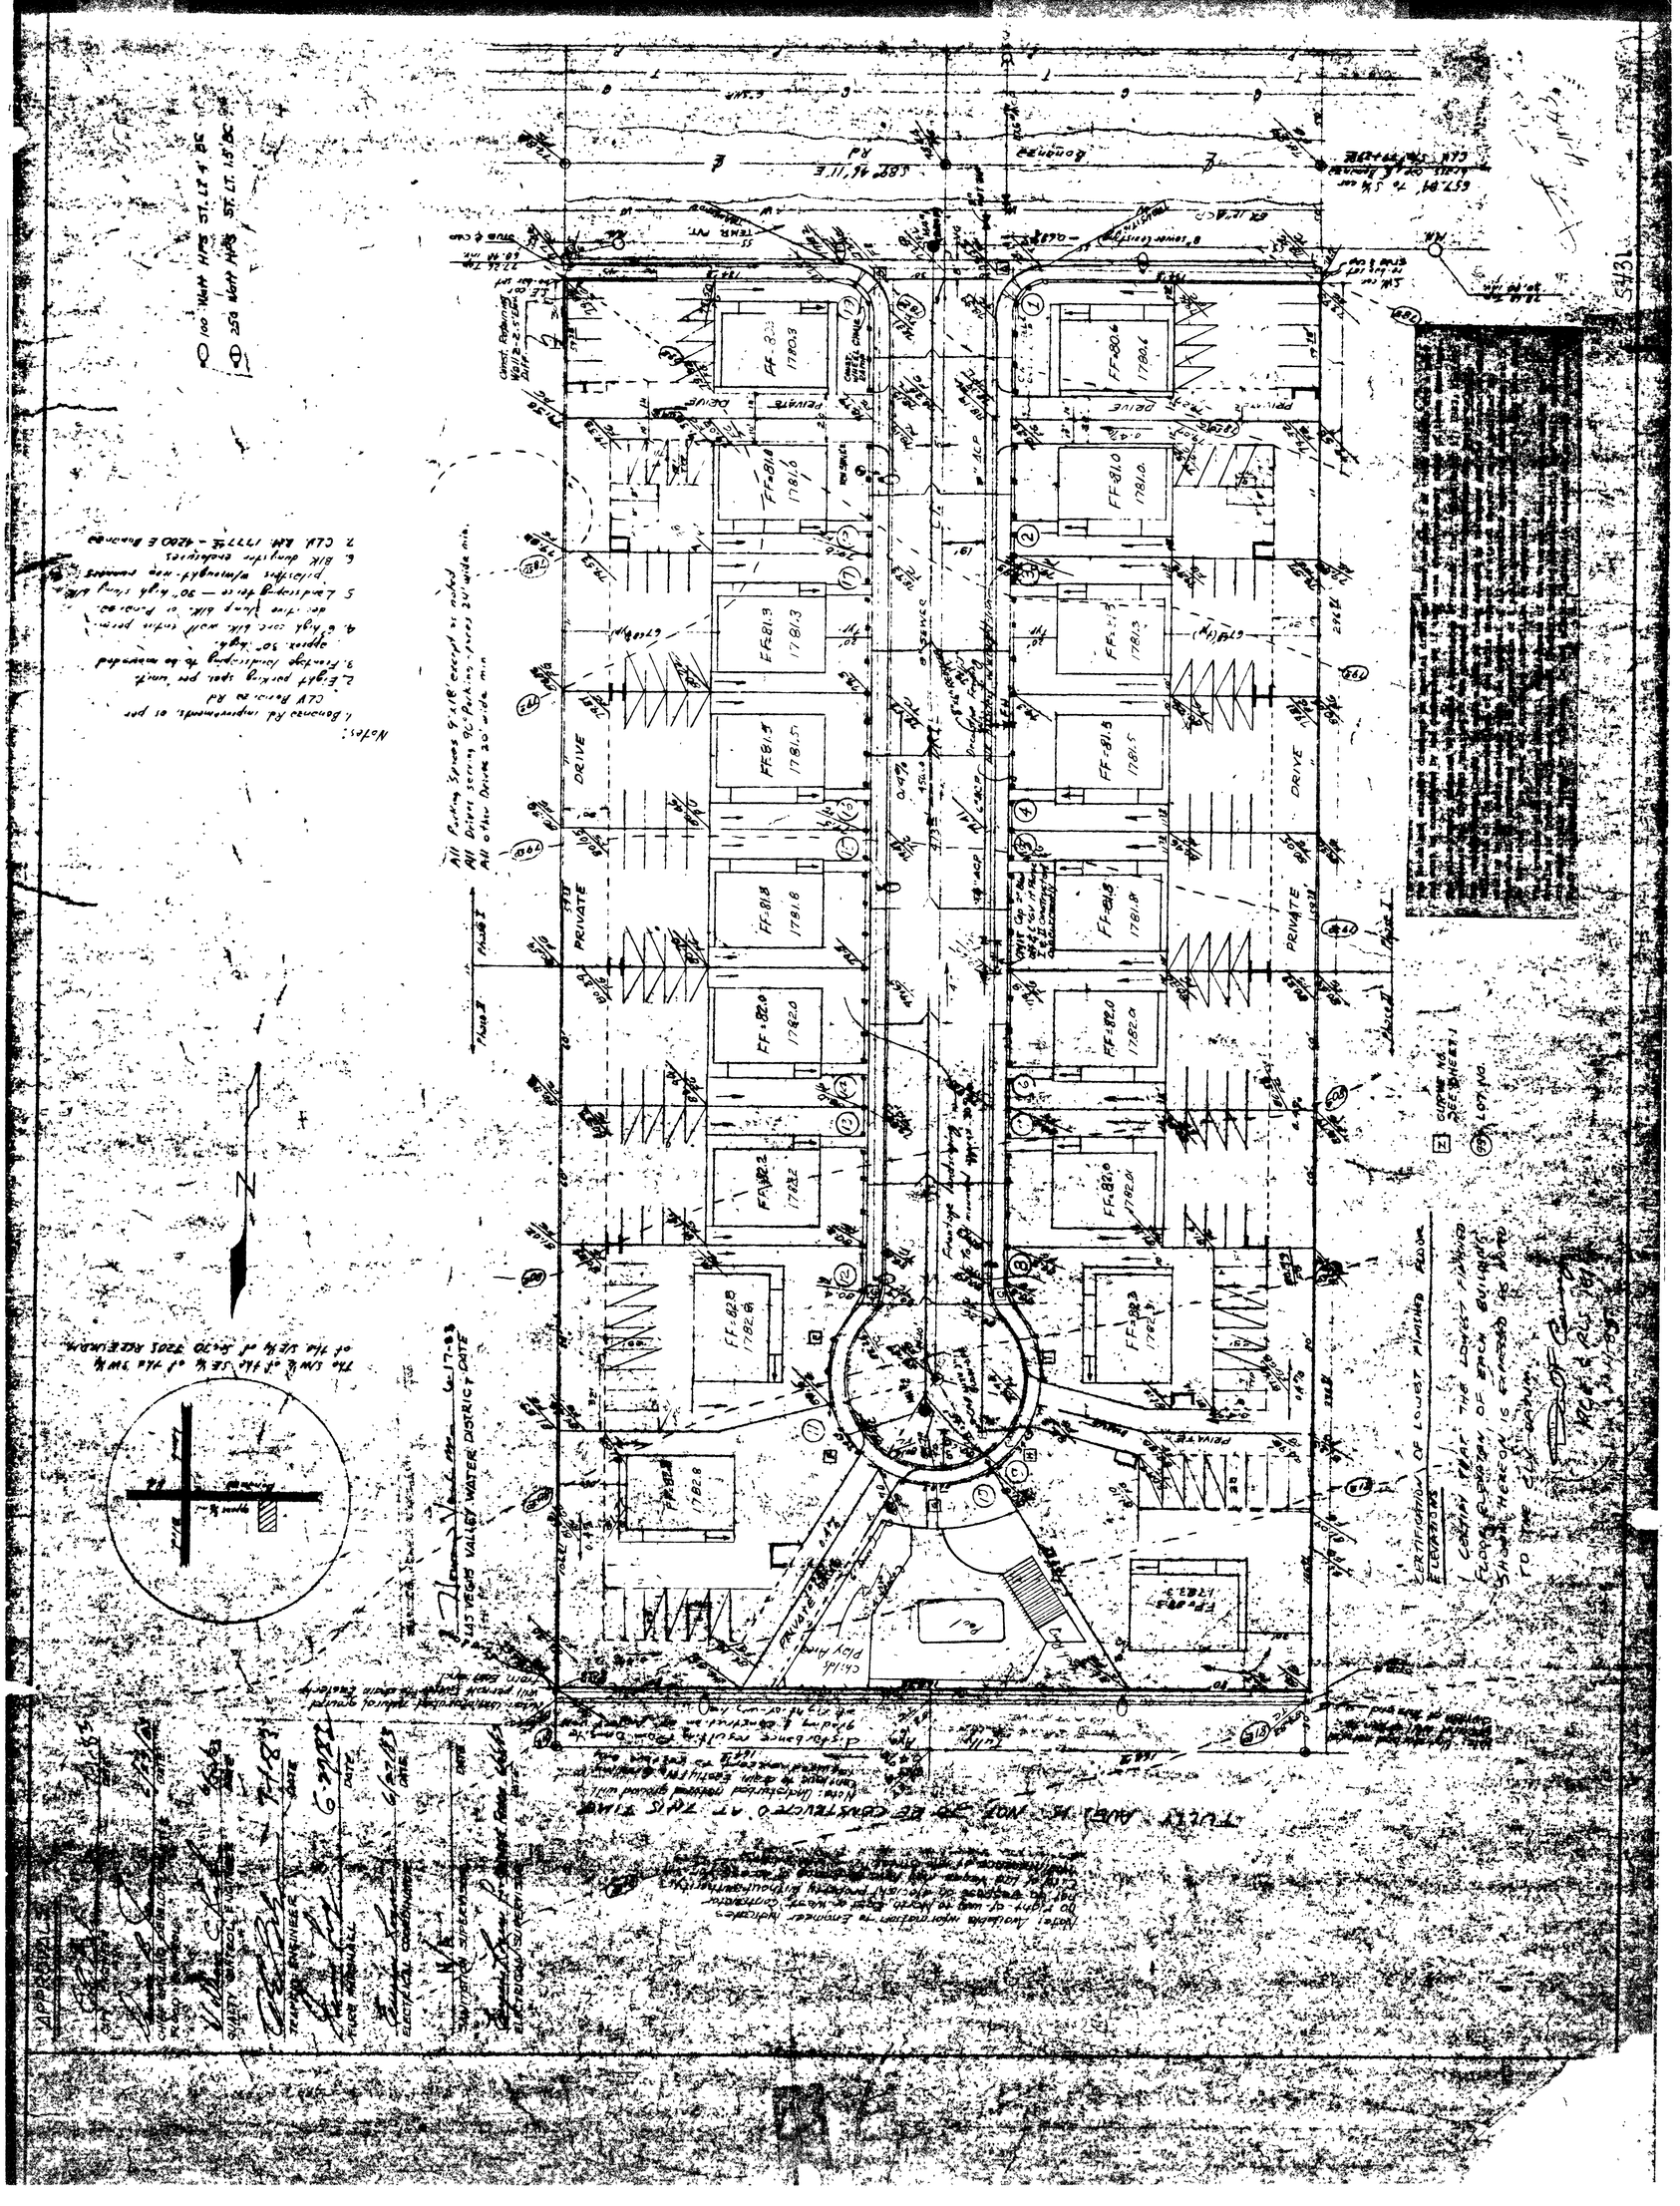
CAUSEY ENGINEERING SERVICE LTD.
ENGINEERS - PLANNERS - SURVEYORS
P.O. BOX 14846
LAS VEGAS, NEVADA 89114
TELEPHONE 702-
DAVID F. CAUSEY P.E.L.S.
JOB NO. 74975-3
SHEET 2 OF 6
IMPROVEMENT PLANS OF
TRIESTE COURT
PLOT AND GRADING
REVISIONS
BY DATE
IN W½ SE¼ SW¼ SE¼ SECTION 30
TOWNSHIP 19 SOUTH, RANGE 62 EAST MOUNT DIABLO MERIDIAN
CITY OF LAS VEGAS, CLARK COUNTY NEVADA
FOR HUTCHINS ENTERPRISE
P.O. BOX 2909 HENDERSON, NEV. 89015
PHONE 702-456-2297
SCALE 1" = 30'
DRAWN BY JDM
PRIVATE DRIVE
FF=81.8 178.1.8
FF=81.5 178.1.5
FF=81.3 178.1.3
FF=81.0 178.1.0
FF=80.6 178.0.6
FF=82.0 178.2.0
FF=82.2 178.2.2
FF=82.8 178.2.8
FF=83.3 178.3.3
Phase I
Phase II
 

TRESTLE COURT

PLOT AND GRADING