

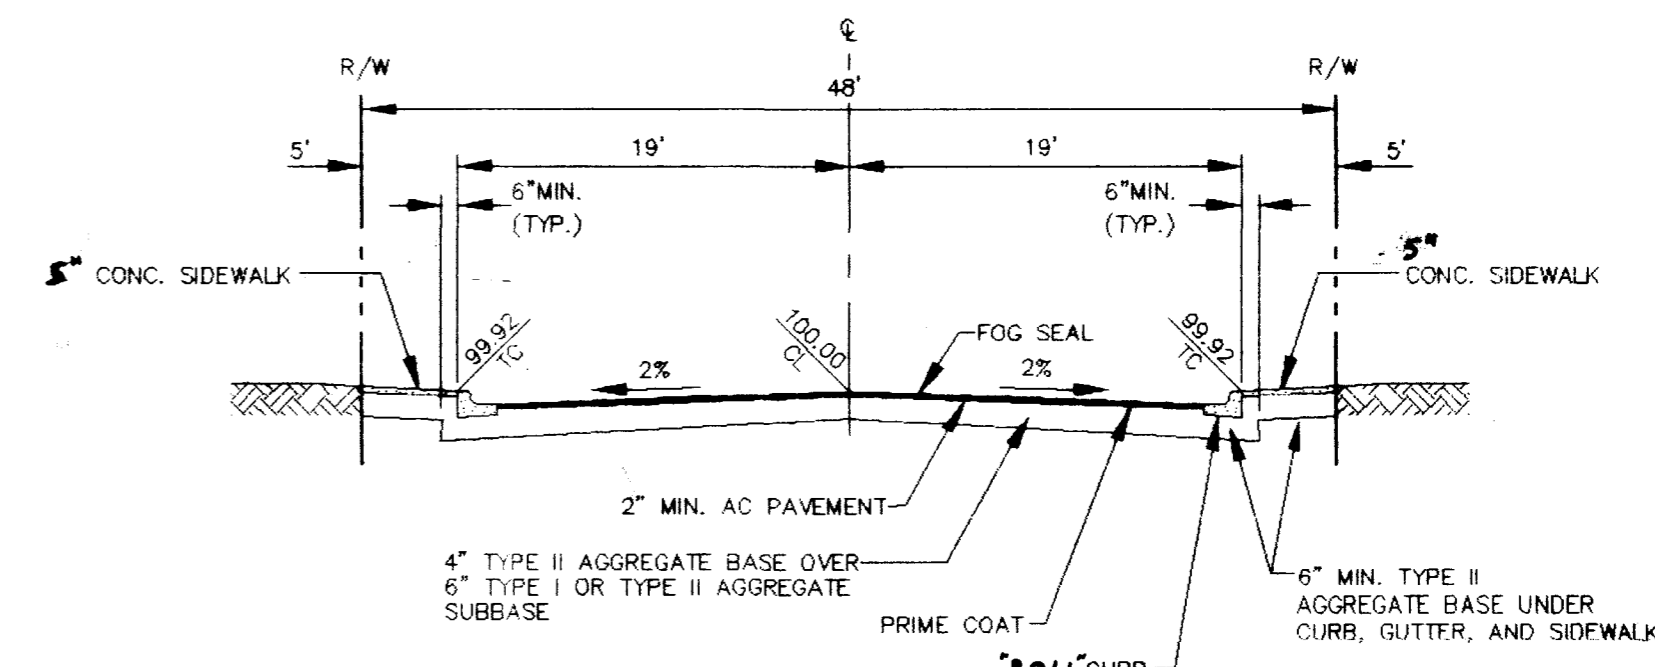
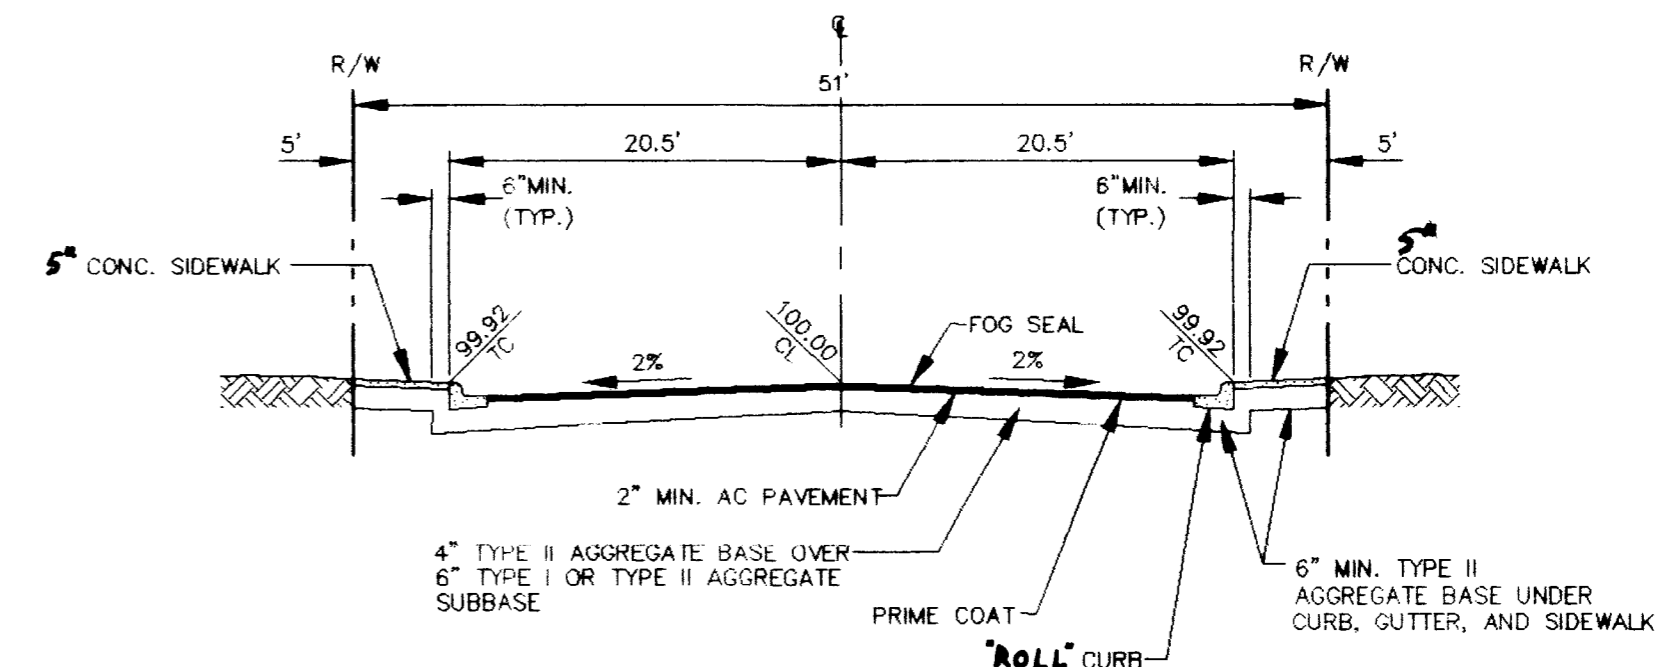
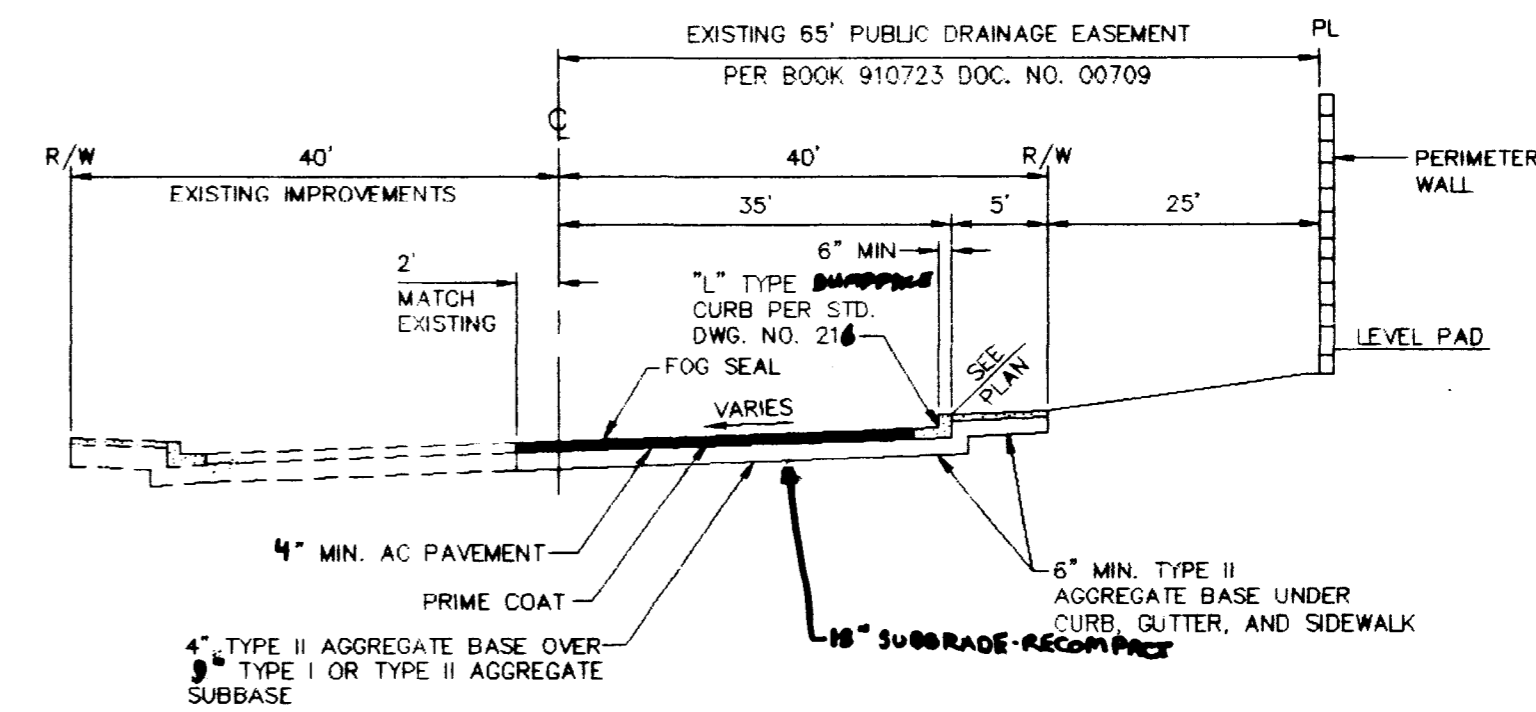



- NOTES:**
- 1" BATTER ON GUTTER FACE OPTIONAL.
 - WHERE LONGITUDINAL SLOPE IS LESS THAN 0.4% THE FLOW LINE SHALL BE WATER TESTED.

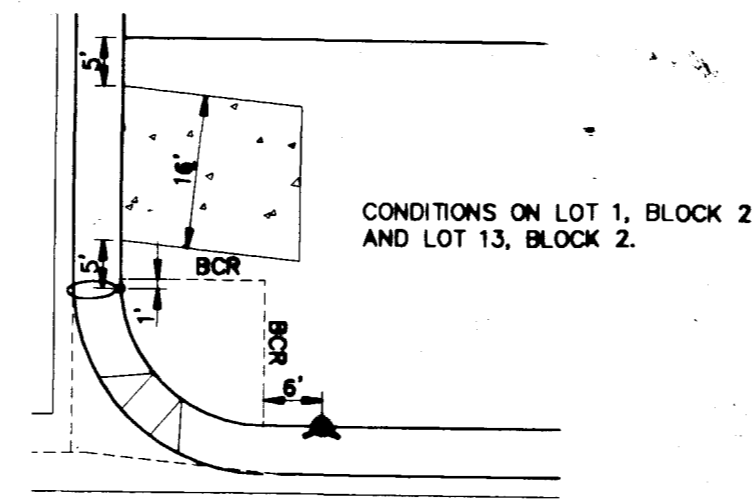

HELLER DEVELOPMENT COMPANIES		ORION ENGINEERING AND SURVEYING, INC.	
CALIFORNIA * NEVADA 8453 Reseda Boulevard Northridge, CA 91324		3068 E. SUNSET ROAD, SUITE 9 LAS VEGAS, NEVADA 89120 (702) 739-5921 FAX (702) 739-5929	
TYPICAL STREET SECTIONS		Washington & Sandhill - Unit 2	
DRAWN BY: RGP	DESIGNED BY: RGP	CHECKED BY: JMB	PROJECT NO: 020-8001
05-20-98	05-20-98	05-20-98	SCALE: N/A
SEAL		SEAL	
SHEET S5		SHEET S5	
11 OF 16 SHEETS		11 OF 16 SHEETS	
DRAWING NO. 107Y-4556-2		DRAWING NO. 107Y-4556-2	

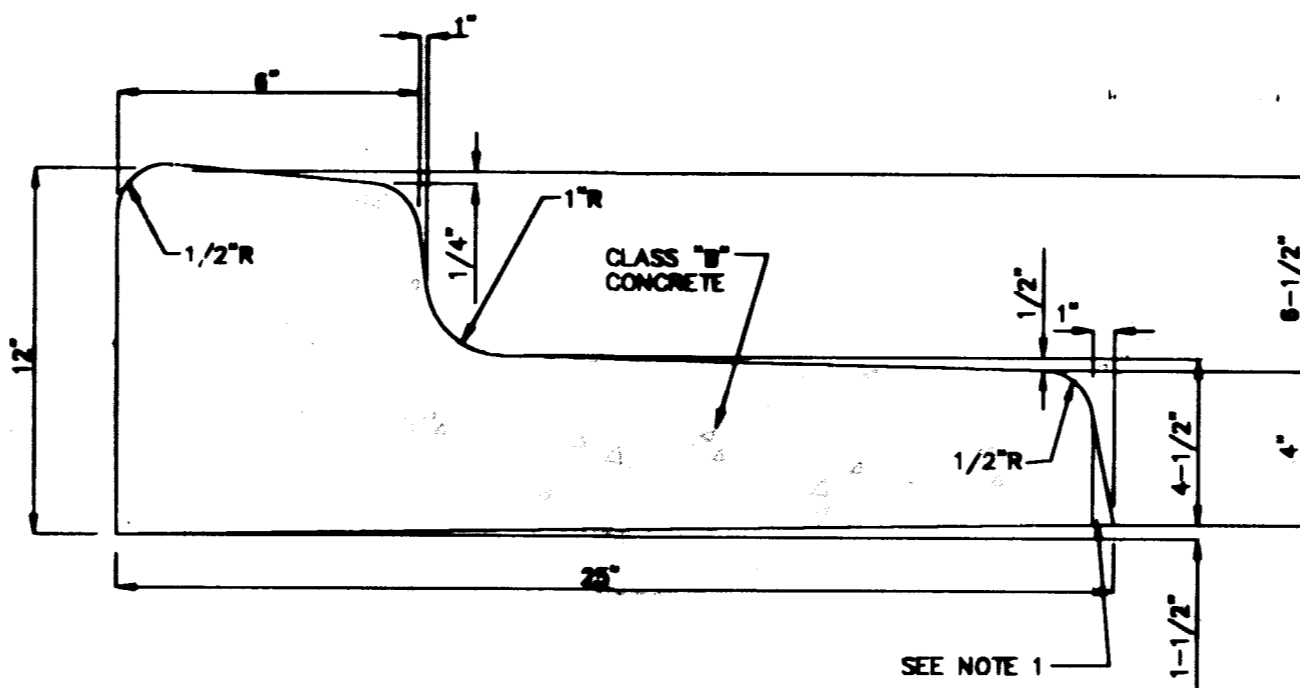

1. TYPICAL SIDE OF ROAD SECTION
 2. TYPICAL GUTTER SECTION

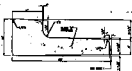














