
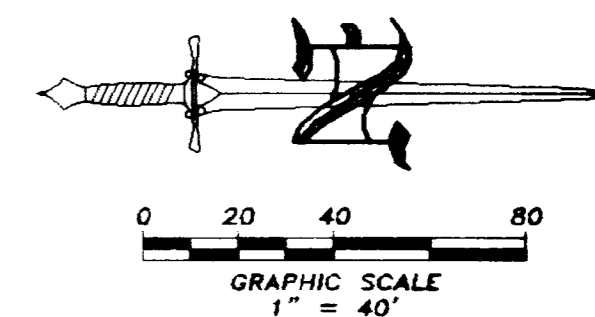


WASHINGTON AVENUE

HARRINGTON AVENUE

PROCLAMATION PLACE

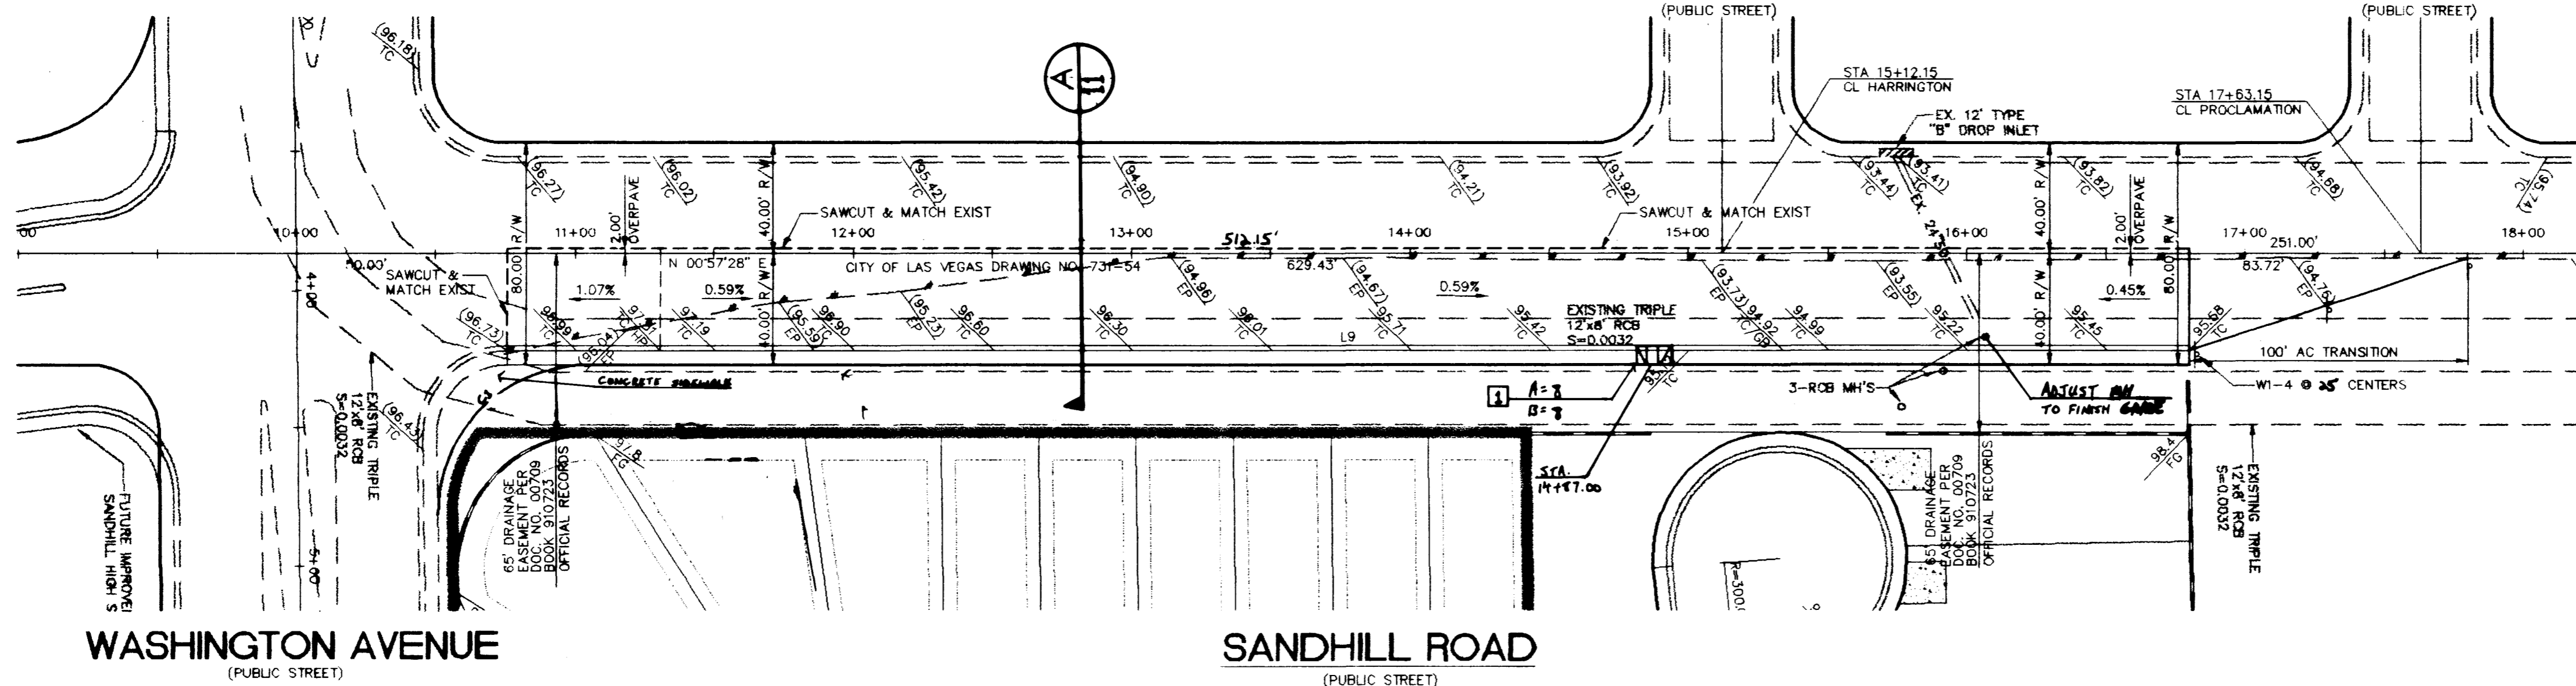

**BASIS OF BEARINGS**

BEING THE SOUTH LINE OF THE SOUTHEAST QUARTER (SE 1/4) OF THE NORTHEAST QUARTER (NE 1/4) OF SECTION 30, T.20S., R.62E., M.D.M., CITY OF LAS VEGAS, CLARK COUNTY, NEVADA. SAID LINE BEARS N. 89°53'26" E.

**BENCHMARK**

NORTH AMERICAN VERTICAL DATUM 1988 (NAV88)  
B.M. NO. 14 STATION 2LV02 3056  
FOUND RIVET AND SQUARE ALUMINUM PLATE IN TOP OF CURB, IN THE SOUTHWEST CORNER OF SANDHILL RD. AND HARRIS AVE.


ELEVATION = 1785.134 FEET  
544.8623 METERS

**LINE TABLE**

LINE	DIRECTION	DISTANCE
L9	N00°57'28" E	604.34'


**CURVE TABLE**

CURVE	RADIUS	LENGTH	TANGENT	AREA
1	61	24.52'	12.26'	231.17'

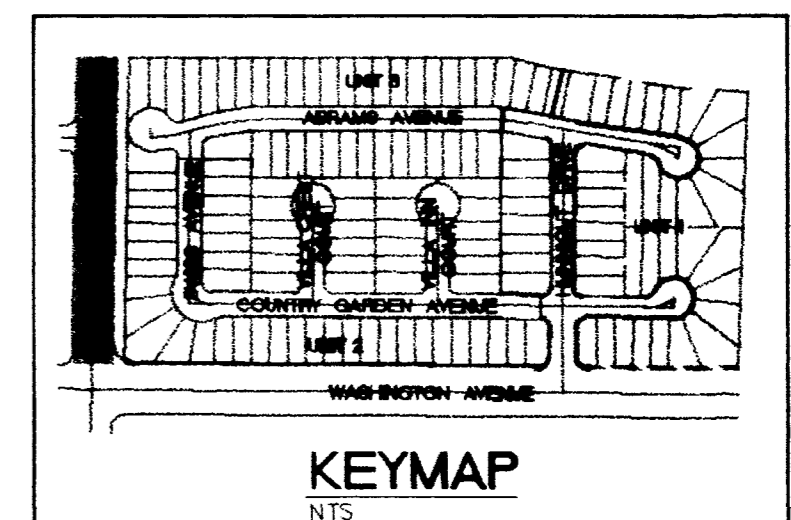

**CONSTRUCTION NOTES:**

- 1. INSTALL CASE 3 SIDEWALK RAMP FOR CLARK COUNTY AREA STANDARD DRAWING NO. 225

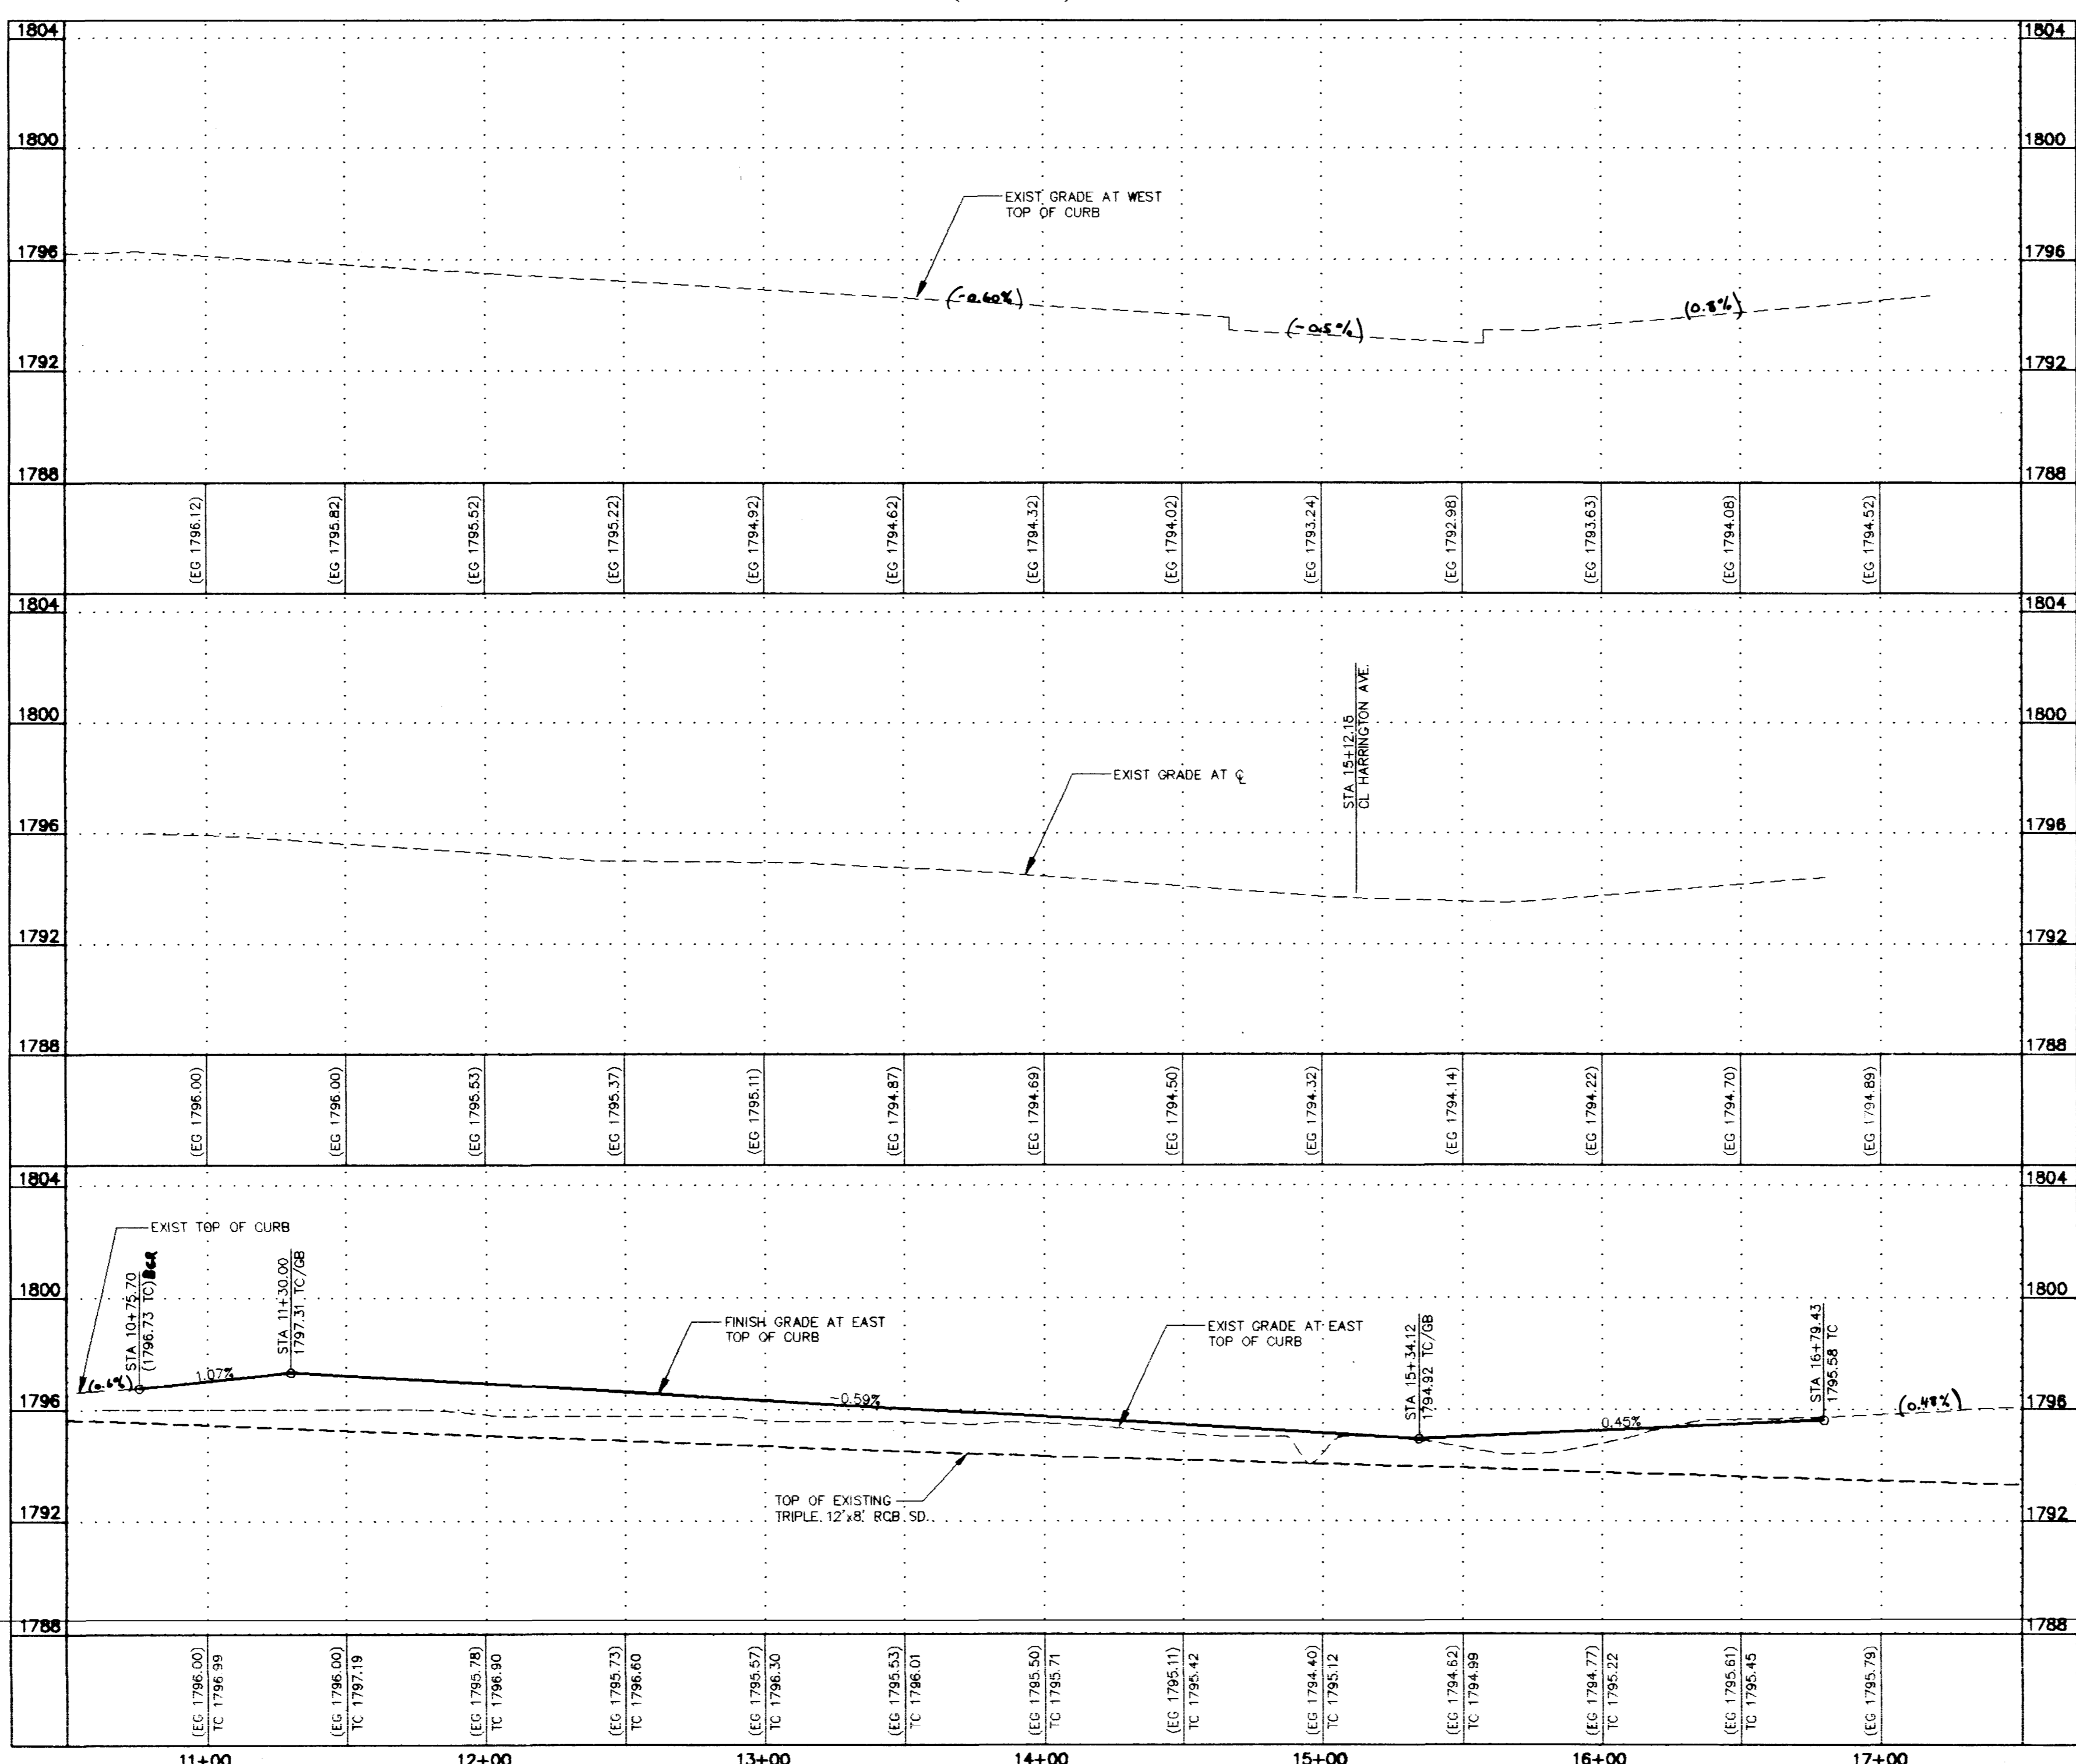

**DISCLAIMER NOTE**

UTILITY LOCATIONS SHOWN HEREON ARE APPROXIMATE ONLY. IT SHALL BE THE CONTRACTOR'S RESPONSIBILITY TO DETERMINE THE EXACT HORIZONTAL AND VERTICAL LOCATION OF ALL EXISTING UNDERGROUND OR OVERHEAD UTILITIES PRIOR TO COMMENCING CONSTRUCTION. NO REPRESENTATION IS MADE THAT ALL EXISTING UTILITIES ARE SHOWN HEREON. THE ENGINEER ASSUMES NO RESPONSIBILITY FOR UTILITIES NOT SHOWN IN THEIR PROPER LOCATION.

**Call before you Dig**  
1-800-227-2600  
NEVADA SERVICE AREA

**Call before you Overhead**  
1-702-583-6111  
NEVADA POWER CORPORATION AND SAFETY SERVICES DEPARTMENT

**HELLER DEVELOPMENT COMPANIES**  
CALIFORNIA \* NEVADA  
8453 Reseda Boulevard  
Van Nuys, CA 91324 (818) 727-2656

**ORION ENGINEERING AND SURVEYING, INC.**  
3068 E. SUNSET ROAD, SUITE 9  
LAS VEGAS, NEVADA 89120  
(702) 738-5921 FAX (702) 739-5929


**STREET PLAN AND PROFILE**  
**SANDHILL ROAD**  
**STA 10+75.70 TO 16+80.12**

**Washington & Sandhill - Unit 2**

DRAWN BY: RSP 05.20.98  
DESIGNED BY: RSP 05.20.98  
CHECKED BY: JMB 05.20.98  
PROJECT NO: 020-8001  
SCALE: HORIZ. 1" = 40'  
VERT. 1" = 4'

**SEAL**  
CIVIL ENGINEER  
NO. 12803

SHEET **51**  
7 OF 15 SHEETS  
DRAWING NO. **107Y-4556-2**

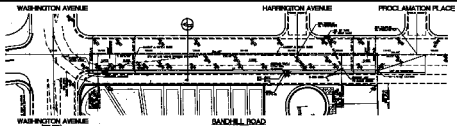


BASE OF BEARING  






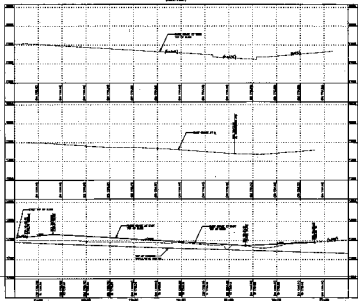

**DISCLAIMER NOTE**  




