
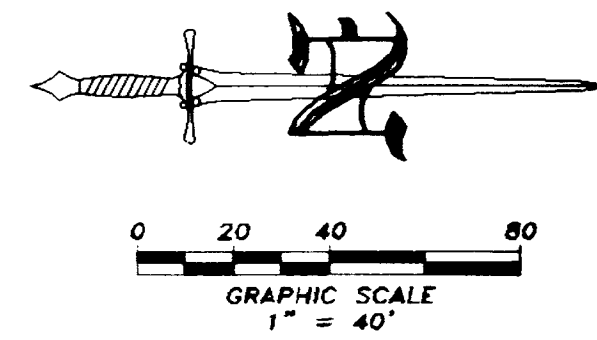


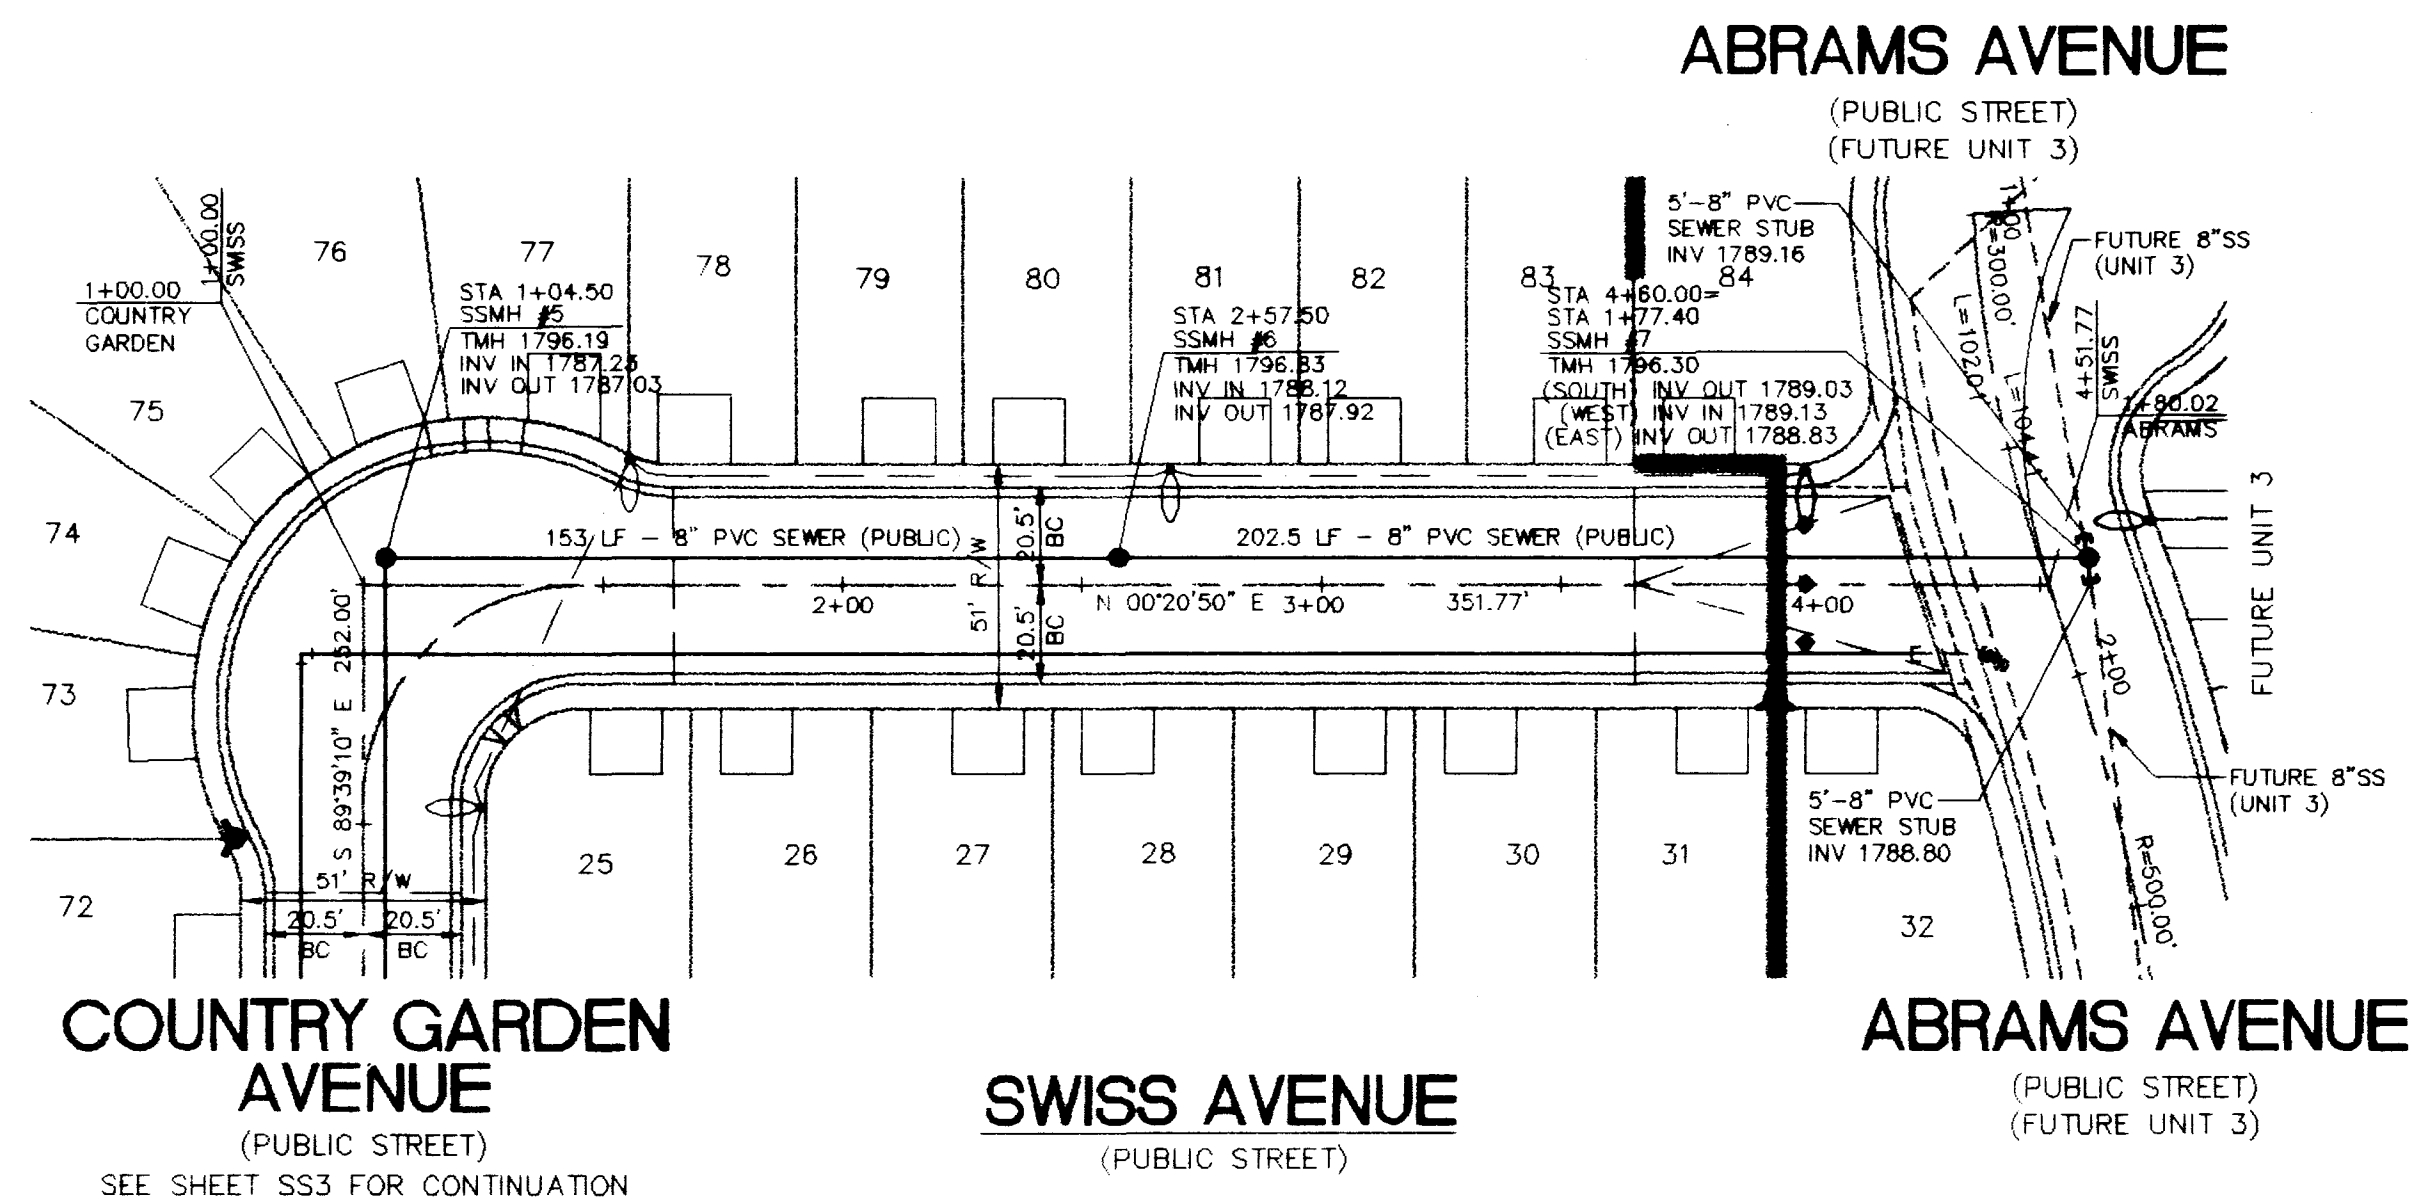



BASIS OF BEARINGS

BEING THE SOUTH LINE OF THE SOUTHEAST QUARTER (SE 1/4) OF THE NORTHEAST QUARTER (NE 1/4) OF SECTION 30, T.20S., R.62E., M.D.M., CITY OF LAS VEGAS, CLARK COUNTY, NEVADA. SAID LINE BEARS N. 89°53'26" E.

BENCHMARK

NORTH AMERICAN VERTICAL DATUM 1988 (NAVD88)
B.M. NO. 14 STATION 2LV02 3056
FOUND RIVET AND SQUARE ALUMINUM PLATE IN TOP OF CURB, IN THE SOUTHWEST CORNER OF SANDHILL RD. AND HARRIS AVE.

ELEVATION = 1785.134 FEET
544.8623 METERS

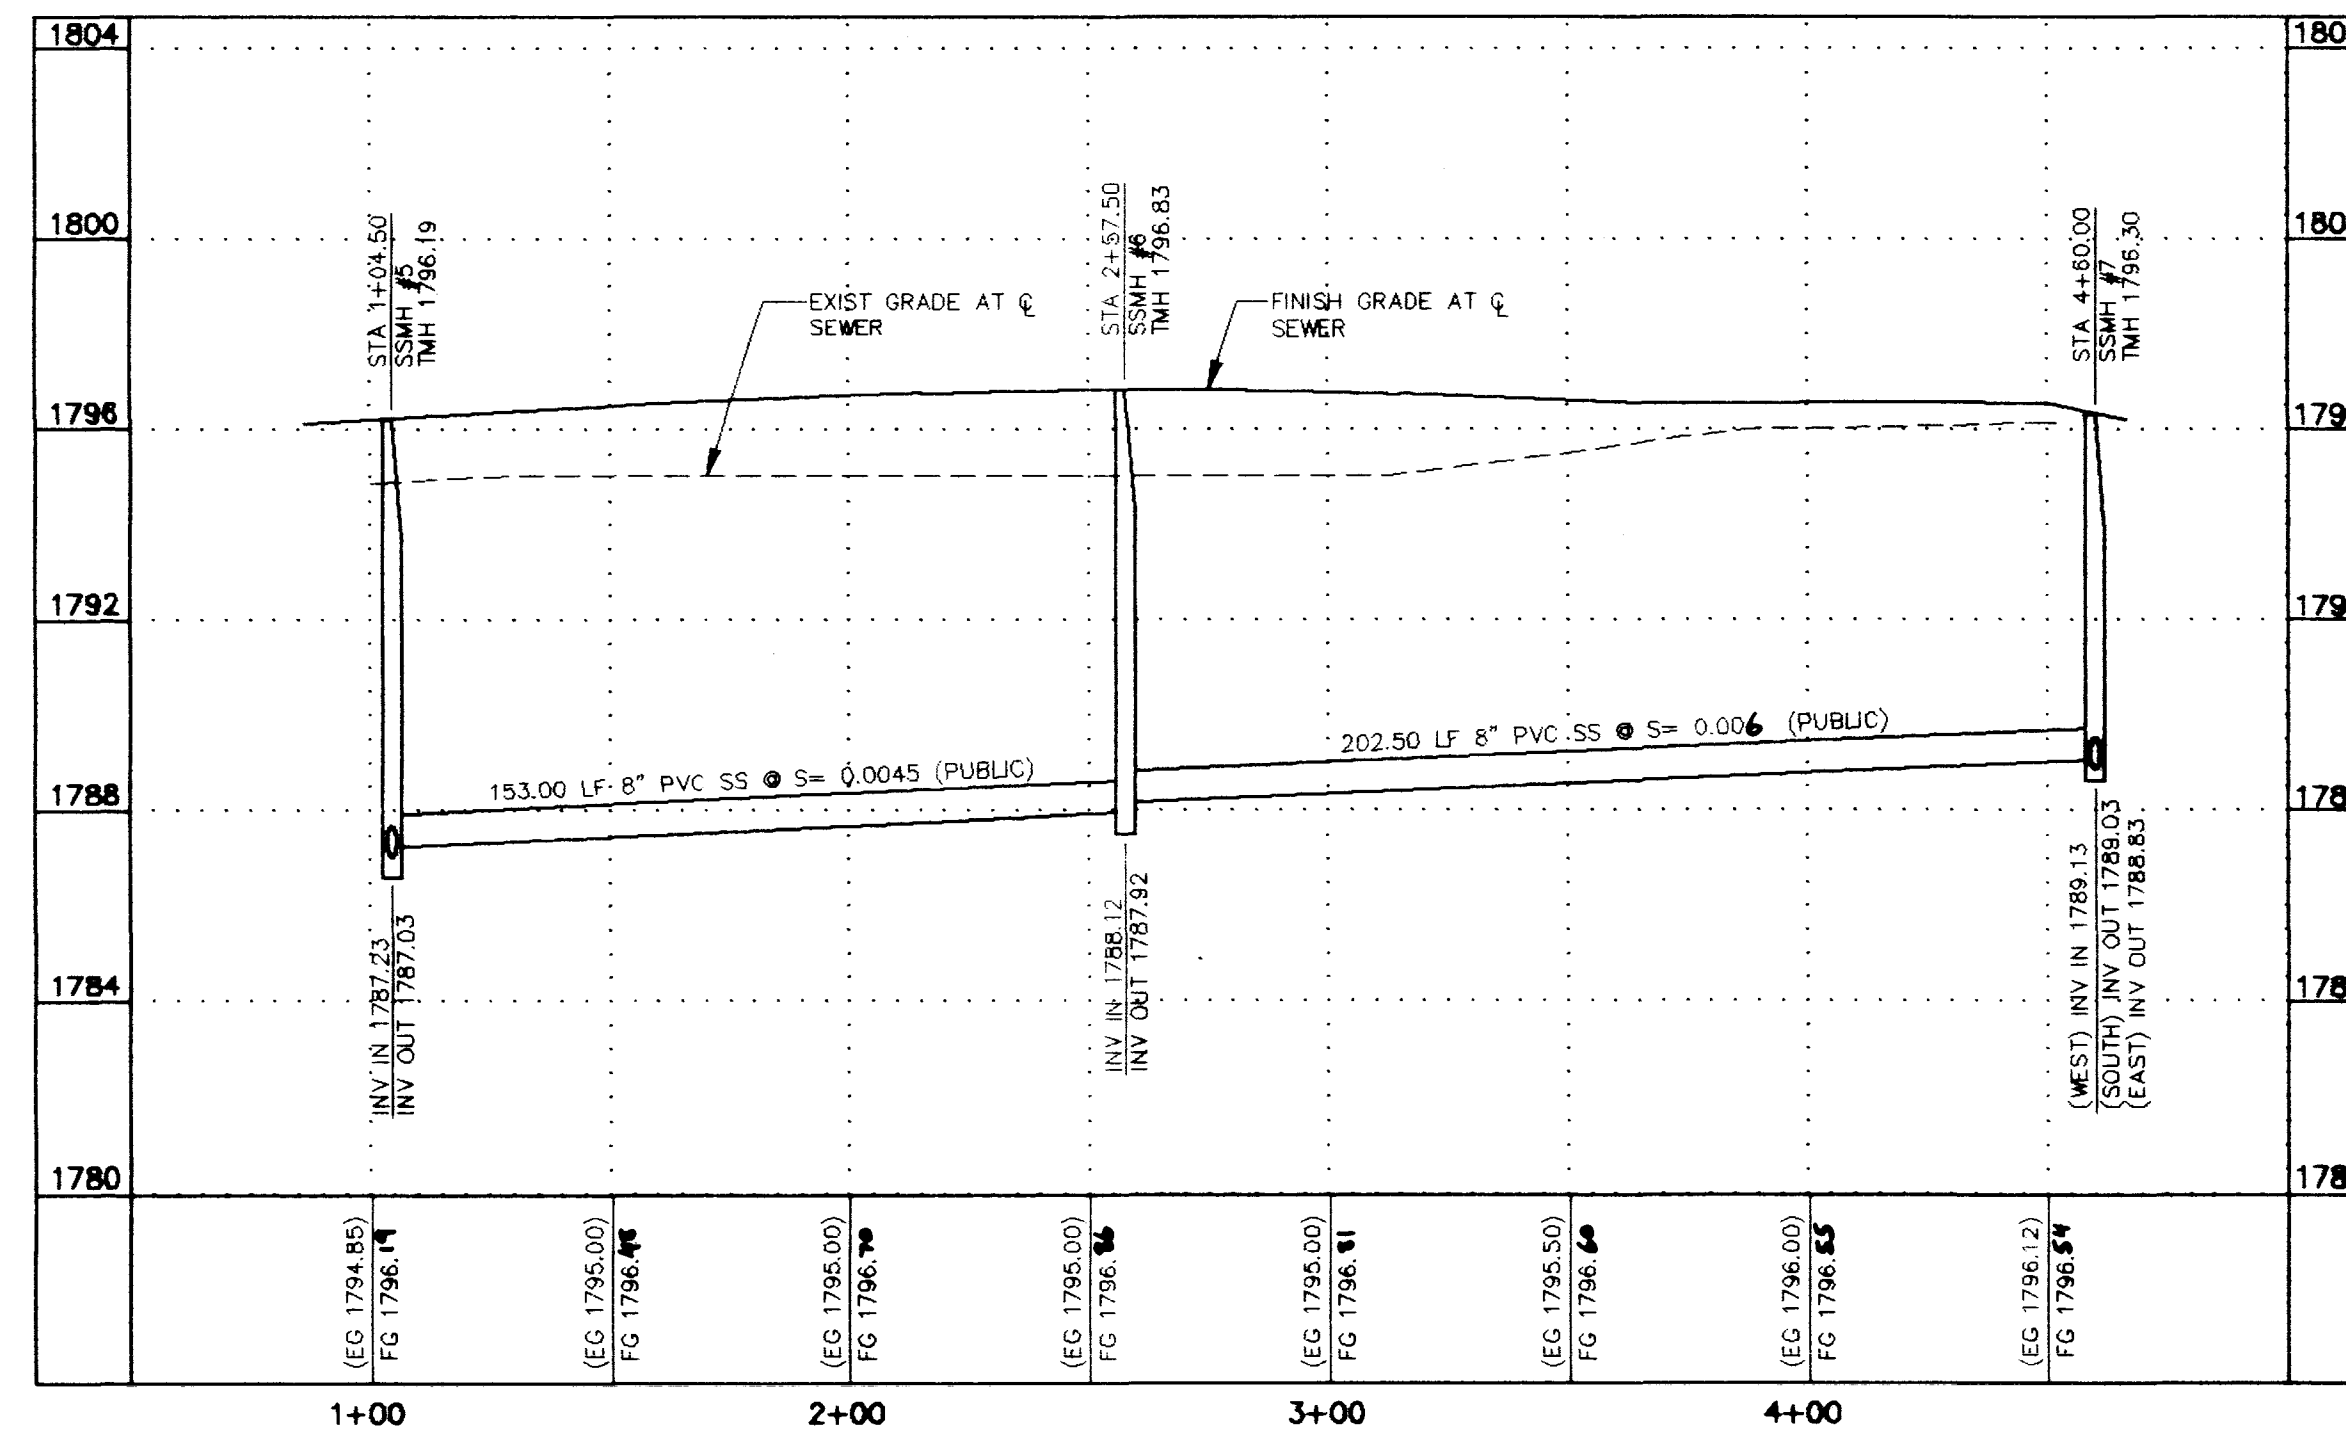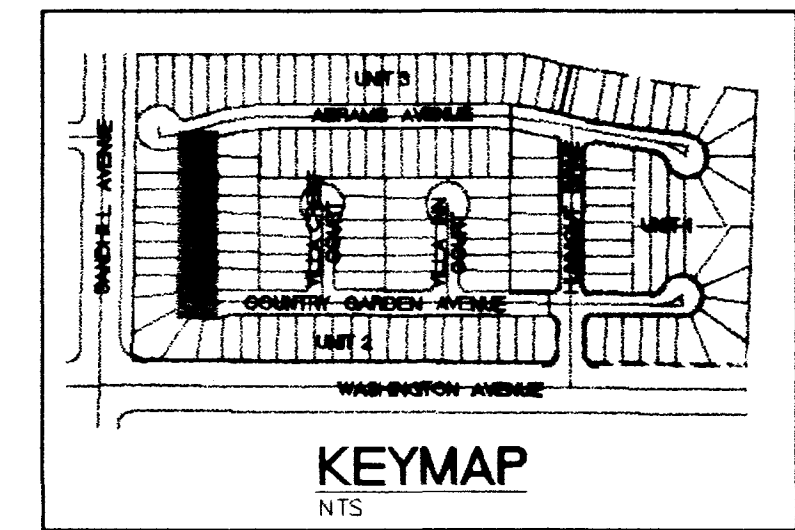

DISCLAIMER NOTE

UTILITY LOCATIONS SHOWN HEREON ARE APPROXIMATE ONLY. IT SHALL BE THE CONTRACTOR'S RESPONSIBILITY TO DETERMINE THE EXACT HORIZONTAL AND VERTICAL LOCATION OF ALL EXISTING UNDERGROUND OR OVERHEAD UTILITIES PRIOR TO COMMENCING CONSTRUCTION. NO REPRESENTATION IS MADE THAT ALL EXISTING UTILITIES ARE SHOWN HEREON. THE ENGINEER ASSUMES NO RESPONSIBILITY FOR UTILITIES NOT SHOWN OR UTILITIES NOT SHOWN IN THEIR PROPER LOCATION.

Avoid cutting underground utility lines. If's costly.

Call before you Dig

1-800-227-2600

UNDERGROUND SERVICE (USA)

Avoid overhead power line contact.

Call before you Overhead

1-702-593-6111

NEVADA POWER CORPORATION AND SAFETY SERVICES DEPARTMENT

HELLER DEVELOPMENT COMPANIES

CALIFORNIA * NEVADA
453 Reseda Boulevard
Northridge, CA 91324 (818) 727-2556

ORION ENGINEERING AND SURVEYING, INC.

3068 E. SUNSET ROAD, SUITE 9
LAS VEGAS, NEVADA 89120
(702) 739-5921 FAX (702) 739-5929

SWISS AVENUE
SEWER PLAN AND PROFILE
STA 1+00.00 TO 4+60.00


Washington & Sandhill - Unit 2

DRAWN BY: RCP 05/20/98


DESIGNED BY: RCP 05/20/98

CHECKED BY: MAB 05/20/98

PROJECT NO: 020-8001

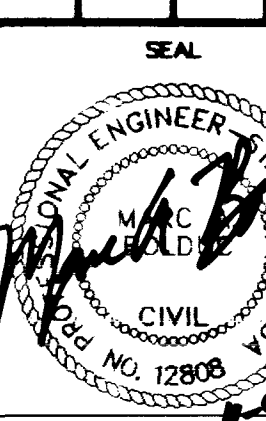


SHEET
SS1
14 OF 16 SHEETS
DRAWING NO:
307Y-4556-2

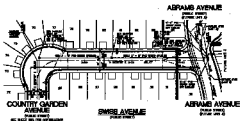



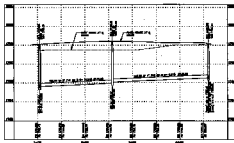



